

190 KURRABA RD

190 KURRABA RD, KURRABA POINT NSW 2089

DEVELOPMENT APPLICATION - DA RE-SUBMISSION

ARCHITECTURAL DRAWING LIST

A001	PROJECT SUMMARY	A482	HEIGHT PLANE PLAN (MERMAN) - R4 ZONE
A002	PERSPECTIVE 01	A483	HEIGHT PLANE DIAGRAMS (MERMAN) - R2 ZONE
A003	PERSPECTIVE 02	A484	HEIGHT PLANE PLAN (MERMAN) - R2 ZONE
A007	CONTEXT PLAN	A500	MATERIAL SAMPLE BOARD
A008	LOCATION PLAN	A620	DCP SIDE AND REAR SETBACK - SURVEY POINTS
A009	BOUNDARY ALIGNMENT PLAN	A630	BETTAR HEIGHT BLANKET LEVELS
A010	ZONING PLAN	A650	BOUNDARY SECTIONS - EXISTING LEVELS
A011	DEMOLITION PLAN	A660	RETAINING STUDY
A012	SITE PLAN	A661	CUT & FILL DIAGRAM
A013	SETBACK PLAN	A662	FLOOR PLAN - VIEW POINTS
A014	SITE ANALYSIS	A663	INDICATIVE 3D VIEWS
A101	R2 GROUND FLOOR	A690	FEASIBILITY STUDY - 184A KURRABA ROAD - OPTION 1
A102	R2 LEVEL 1	A691	CROSS SECTION - OPTION 1
A103	R2 LEVEL 2	A692	FEASIBILITY STUDY - 184A KURRABA ROAD - OPTION 2
A104	R4 LOWER GROUND	A693	FEASIBILITY STUDY - 184A KURRABA ROAD - OPTION 2
A105	R4 GROUND	A694	CROSS SECTION - OPTION 2
A106	R4 LEVEL 1		
A107	R4 LEVEL 2		
A108	R4 LEVEL 3		
A109	R4 ROOF		
A110	BUILDING HEIGHT		
A200	OVERALL NORTH ELEVATION		
A201	ELEVATION - EAST		
A202	ELEVATION - NORTH		
A203	ELEVATION - SOUTH		
A204	ELEVATION - WEST		
A205	ELEVATION - BUILDING A & C SOUTH		
A206	ELEVATION - MIDDLE LOOKING SOUTH		
A301	SECTION 1 - NORTH SECTION		
A302	SECTION 2 - SOUTH SECTION		
A303	SECTION 3 - R4 ZONE		
A304	SECTION 4 - R2 ZONE		
A401	COMBINED SITE CALCULATIONS		
A403	LANDSCAPE & EXCAVATION AREA CALCULATION		
A410	HEIGHT PLANE DIAGRAMS (BETTAR) - R4 ZONE		
A411	HEIGHT PLANE PLAN (BETTAR) - R4 ZONE		
A412	R4 DCP ENVELOPE (SIDE BOUNDARY)		
A414	R4 DCP ENVELOPE (REAR BOUNDARY)		
A415	HEIGHT PLANE DIAGRAMS (BETTAR) - R2 ZONE		
A416	HEIGHT PLANE PLAN (BETTAR)- R2 ZONE		
A420	CROSS VENTILATION		
A421	36 DEGREE HEIGHT PLANE DIAGRAMS - R4 ZONE		
A450	SHADOW DIAGRAMS - DEC 21 1/2		
A451	SHADOW DIAGRAMS - DEC 21 2/2		
A452	SHADOW DIAGRAM - JUNE 21 1/2		
A453	SHADOW DIAGRAM - JUNE 21 2/2		
A455	SUN EYE VIEW - DEC 21		
A456	SUN EYE VIEW - JUNE 21		
A458	GFA DIAGRAMS - BUILDING A & B (R4 ZONE)		
A459	GFA DIAGRAMS - BUILDING C & D (R2 ZONE)		
A475	PRE & POST ADAPTABLE UNIT LAYOUT (APT A 001)		
A476	PRE & POST ADAPTABLE UNIT LAYOUT (APT B 001)		
A481	HEIGHT PLANE DIAGRAMS (MERMAN) - R4 ZONE		

KOICHITAKADA.COM



PROJECT SUMMARY

Address: 184b-190 KURRABA RD
Site Area: R4 North: 658m² / 622m²(EASEMENT EXCLUDED) | R4 South: 749m² | **TOTAL R4:** 1407 m² / 1371 m²(EASEMENT EXCLUDED)
 R2 North: 924m² | R2 South: 1012m² | **TOTAL R2:** 1936 m²
Total (R4 + R2) 3343 m² / 3307m² (EASEMENT EXCLUDED)
Land Use: R4 High Density Residential
 R2 Low Density Residential

DEFINITIONS
 LEP: LOCAL ENVIRONMENTAL PLAN
 DCP: DEVELOPMENT CONTROL PLAN
 ADG: APARTMENT DESIGN GUIDE. WORKS WITH SEPP 65 TO OUTLINE STATUTORY REQUIREMENTS FOR APARTMENT DESIGN IN NSW.
 SEPP 65: STATE ENVIRONMENTAL PLANNING POLICY NO.65- DESIGN QUALITY OF RESIDENTIAL FLAT DEVELOPMENT.
 GFA: GROSS FLOOR AREA.

PROPOSAL SUMMARY / COUNCIL DCP & LEP REQUIREMENTS

	PROPOSED R4	CONTROL R4	PROPOSED R2	CONTROL R2
Building Height (m)	Building A: 9.8m - 12.3m Building B: 11.7m - 11.9m	12m	Building C: 4.1m - 7.7m Building D: 1.7m - 8.9m	8.5m
Setbacks	Kurraba Rd – Average 10m setback: 10.4m - 13.7m Side –2.5m min - 8.8m max to glazing line Rear – 1.7m min - 7.9m max (at roof)	Front – Alignment of primary facades on adjoining properties (Average 10.9m) Side – 3m and 45degree height plane commencing at 3.5m at boundary Rear – 1.5m and 45degree height plane commencing at 3.5m at boundary	Front – .5m min - 4.1m max Side: 2m min (refer to plans) Rear – Foreshore setback	Front – Alignment of primary facades on adjoining properties Side: 900mm UP TO 4m 1.5m UP TO 7m 2.5m TO GREATER 7m Rear - Foreshore setback
Car Parking	2 Bed: Bldg A: 1 Space, Bldg B: 0 Spaces 3+ Bed: Bldg A: 3 Spaces, Bldg B: 5 Spaces Visitor: Bldg A: 1 Space, Bldg B: 1 Space Total Proposed Bldg A: 5 spaces Total Proposed Bldg B: 6 spaces	1 or 2 Bed: 1 space / dwelling = 1 space for Bldg A 3+ Bed: 1.5 space / dwelling = 3 spaces for Bldg A, 5 spaces for Bldg B Visitor: .25 space / dwelling (min 1) = 1 space for Bldg A, 1 space for Bldg B	3+ Bed: 8 spaces Total Required: 8 spaces Total Proposed: 8 spaces	1 or 2 Bed: 1 space / dwelling = 0 spaces 3+ Bed: 1.5 space / dwelling = 8 spaces (2 spaces per separate dwelling)
Excavated Area	672.9m ² = 49.1%	Max 70% of combined site area (960m ²)	North: 53.5m ² 5.8% South: 23.1m ² 2.3%	North: Max 70% = 647m ² South: Max 70% = 708m ²
Adaptable Housing	2 UNITS	1 UNITS	NO REQUIREMENT	NO REQUIREMENT
Site Coverage	North: 279.9m ² 45% South: 329.3m ² 44.0%	North: Max 45% = 279.9m ² South: Max 45% = 337.1m ²	North: 400.1m ² 43.3% South: 430.0m ² 42.5%	North: Max 45% = 416m ² South: Max 45% = 455m ²
Landscaping	North: 243.9m ² 39.2% South: 310.1m ² 41.4%	North: (Min Total Landscape 40%) = 248.8m ² South: (Min Total Landscape 40%) =299.6m ²	North: 421.8m ² 45.7% South: 434.3m ² 42.9%	North: (Min Total Landscape 40%) = 370m ² South: (Min Total Landscape 40%) =405m ²
Unbuilt Upon Area	North: 98.2m ² 15.8% South: 109.6m ² 14.6%	North: Max 15% = 93.3m ² South: Max 15% = 112.4m ²	North: 102.1m ² 11% South: 147.7m ² 14.6%	North: Max 15% = 139m ² South: Max 15% = 152m ²

UNIT BREAKDOWN

LEVEL	R4 ZONE			R2 ZONE
	2 BED	3 BED	4 BED	DUAL OCCUPANCY
R2 GND.				4
R2 L01				
R2 L02				
R4 GND.	1	1		
R4 L01		2		
R4 L02		1	1	
R4 L03				
TOTAL R4	1	4	1	
TOTAL R2				4
TOTAL	1 (10%)	4 (40%)	1 (10%)	4 (40%)

(10 TOTAL)

ADG RECOMMENDATION (COMPLIANCE NOT REQUIRED)

	COMPLIANCE (R2 and R4 Zones)	RECOMMENDATION
4A.1 Solar Access	80% (8/10 dwellings) 0% (No apartments without solar access)	Min. 70% of apartments (9am - 3pm) Max. 15% no solar access
4B.3 Natural Cross Ventilation	100% (10 / 10) dwellings)	Min 60%
3D.1 Deep Soil	R4: 554m ² = 40.4% R2: 859.9m ² = 44.4%	R4: 7% of site area = 98m ² R2: 7% of site area = 136m ²
3D.1 Communal & Public Open Space	TBC	R4 : 25% of site area (352m ²)

GFA BREAKDOWN

R2	R4
R2 GND: 365m ²	R4 LG: 37m ²
R2 L01: 360m ²	R4 GND: 394m ²
R2 L02: 332m ²	R4 L01: 376m ²
	R4 L02: 244m ²
	R4 L03: 134m ²
TOTAL: 1057m ²	TOTAL: 1185m ²

* REFER TO DRAWING A401 FOR DIAGRAMS AND EXCLUSIONS
 ** REFER TO DRAWING A403 - FOR DIAGRAMS

<table border="1"> <thead> <tr> <th>NO.</th> <th>REVISION</th> <th>BY</th> <th>CHK</th> <th>DATE</th> </tr> </thead> <tbody> <tr> <td>1</td> <td>FOR INFORMATION</td> <td></td> <td></td> <td>17.12.2021</td> </tr> <tr> <td>2</td> <td>PRE-COMMENCEMENT</td> <td></td> <td></td> <td>20.11.2022</td> </tr> <tr> <td>3</td> <td>COORDINATION ISSUE</td> <td>AL</td> <td>RPW</td> <td>09.02.2023</td> </tr> <tr> <td>4</td> <td>AMENDED COORDINATION ISSUE</td> <td>AL</td> <td>RPW</td> <td>19.05.2022</td> </tr> <tr> <td>5</td> <td>DA ISSUE</td> <td>RPW</td> <td>JAC</td> <td>08.06.2022</td> </tr> <tr> <td>6</td> <td>COUNCIL RFI COORDINATION ISSUE</td> <td>AL</td> <td>RPW</td> <td>31.07.2023</td> </tr> <tr> <td>7</td> <td>COUNCIL RFI ISSUE</td> <td>AL</td> <td>RPW</td> <td>15.08.2023</td> </tr> <tr> <td>8</td> <td>ISSUE FOR DA RESUBMISSION</td> <td>AL</td> <td>RPW</td> <td>02.02.2024</td> </tr> </tbody> </table>	NO.	REVISION	BY	CHK	DATE	1	FOR INFORMATION			17.12.2021	2	PRE-COMMENCEMENT			20.11.2022	3	COORDINATION ISSUE	AL	RPW	09.02.2023	4	AMENDED COORDINATION ISSUE	AL	RPW	19.05.2022	5	DA ISSUE	RPW	JAC	08.06.2022	6	COUNCIL RFI COORDINATION ISSUE	AL	RPW	31.07.2023	7	COUNCIL RFI ISSUE	AL	RPW	15.08.2023	8	ISSUE FOR DA RESUBMISSION	AL	RPW	02.02.2024	REVISION NOTES: 1. FOR INFORMATION 2. PRE-COMMENCEMENT 3. COORDINATION ISSUE 4. AMENDED COORDINATION ISSUE 5. DA ISSUE 6. COUNCIL RFI COORDINATION ISSUE 7. COUNCIL RFI ISSUE 8. ISSUE FOR DA RESUBMISSION	KEY PLAN CLOUD LEGEND ○ REVISION ○ ON HOLD	NOTES: KOICHI TAKADA ARCHITECTS (KTA) RETAIN ALL COMMON LAW AND STATUTORY RIGHTS INCLUDING COPYRIGHT AND INTELLECTUAL PROPERTY RIGHTS TO THIS DOCUMENT. THIS DOCUMENT MUST NOT BE EDITED, PARTIALLY EXTRACTED, REPRODUCED OR DISTRIBUTED IN ANY MANNER WITHOUT KTA'S EXPRESS WRITTEN CONSENT AND UNDER NO CIRCUMSTANCES SHALL THE TRANSFER OF THIS DOCUMENT BE DEEMED A SALE OR CONSTITUTE A TRANSFER OF ANY LICENCE TO USE THE DOCUMENT WITHOUT KTA'S KNOWLEDGE OR CONSENT. THE PDF DOCUMENT STAMPED BY KTA AS A 'QA CONTROLLED DOCUMENT' IS THE ONLY OFFICIAL VERSION OF THIS DOCUMENT AND IS STRICTLY SUBJECT TO COPYRIGHT. THE CONTENT AND ACCURACY OF THE DOCUMENT IS STRICTLY LIMITED TO THAT DEPICTED IN THE 'QA CONTROLLED PDF'. DO NOT MEASURE FROM THE ELECTRONIC OR HARD COPY VERSIONS OF THIS DOCUMENT. VERIFY ALL DIMENSIONS ON SITE BEFORE COMMENCING SHOP DRAWINGS, FABRICATION, CONSTRUCTION OR INSTALLATION.	OTHERS: CLIENT Kurraba Point Road Pty Ltd 430 TOORAK ROAD, TOORAK 3142	ARCHITECT SUITE 41 & 42, LEVEL 4 61 MARLBOROUGH ST SURRY HILLS, NSW 2010 T 02 9698 8510 ABN 63 131 365 896 NOMINATED ARCHITECT: KOICHI TAKADA NSW ARCHITECTS 6901 VIC ARCHITECTS 16179 QLD ARCHITECTS 5590 KOICHI TAKADA.COM	PROJECT 190 KURRABA RD 190 KURRABA RD, KURRABA POINT NSW 2089 STATUS DEVELOPMENT APPLICATION - RFI 01	DWG TITLE PROJECT SUMMARY DWG NO. A001 SCALE REVISION 8 DATE 02.02.2024
NO.	REVISION	BY	CHK	DATE	
1	FOR INFORMATION			17.12.2021	
2	PRE-COMMENCEMENT			20.11.2022	
3	COORDINATION ISSUE	AL	RPW	09.02.2023	
4	AMENDED COORDINATION ISSUE	AL	RPW	19.05.2022	
5	DA ISSUE	RPW	JAC	08.06.2022	
6	COUNCIL RFI COORDINATION ISSUE	AL	RPW	31.07.2023	
7	COUNCIL RFI ISSUE	AL	RPW	15.08.2023	
8	ISSUE FOR DA RESUBMISSION	AL	RPW	02.02.2024	

Koichi Takada Architects

THIS DOCUMENT IS NOT SUITABLE OR APPROVED FOR CONSTRUCTION AT ANY TIME UNLESS KTA HAVE NOTATED THE STATUS TITLE AS FOR CONSTRUCTION WITHOUT THE PRESENCE OF 'WIP', 'DRAFT' OR ANY OTHER FORM OF QUALIFICATION ON THE DOCUMENT.



NOTE: INDICATIVE ONLY - REFER TO DESIGN REPORT FOR EXTERNAL PHOTOMONTAGES

NO.	REVISION	BY	CHK	DATE	REVISION NOTES:
1	FOR INFORMATION			17.12.2021	
2	PRE-CONSENT			20.11.2022	
3	COORDINATION ISSUE	AL	RPW	09.02.2023	
4	AMENDED COORDINATION ISSUE	AL	RPW	19.05.2023	
5	DA ISSUE	RPW	JAC	08.06.2023	
6	COUNCIL RFI COORDINATION ISSUE	AL/CK	RPW	31.07.2023	
7	COUNCIL RFI ISSUE	AL/CK	RPW	15.08.2023	
8	ISSUE FOR DA RESUBMISSION	AL	RPW	02.02.2024	

NOTE: INDICATIVE ONLY - REFER TO DESIGN REPORT FOR EXTERNAL PHOTOMONTAGES

NO.	REVISION	BY	CHK	DATE	REVISION NOTES:
1	FOR INFORMATION			17.12.2021	
2	PRE-CONCRETE			20.11.2022	
3	COORDINATION ISSUE			09.02.2020	
4	AMENDED COORDINATION ISSUE	AL	RPW	19.05.2022	
5	DA ISSUE	RPW	JAC	08.06.2022	
6	COUNCIL RFI COORDINATION ISSUE	AL/CK	RPW	31.07.2023	
7	COUNCIL RFI ISSUE	AL/CK	RPW	15.08.2023	
8	ISSUE FOR DA RESUBMISSION	AL	RPW	02.02.2024	

NOTES:
 KOICHI TAKADA ARCHITECTS (KTA) RETAIN ALL COMMON LAW AND STATUTORY RIGHTS INCLUDING COPYRIGHT AND INTELLECTUAL PROPERTY RIGHTS TO THIS DOCUMENT.
 THIS DOCUMENT MUST NOT BE EDITED, PARTIALLY EXTRACTED, REPRODUCED OR DISTRIBUTED IN ANY MANNER WITHOUT KTA'S EXPRESS WRITTEN CONSENT AND UNDER NO CIRCUMSTANCES SHALL THE TRANSFER OF THIS DOCUMENT BE DEEMED A SALE OR CONSTITUTE A TRANSFER OF ANY LICENCE TO USE THE DOCUMENT WITHOUT KTA'S KNOWLEDGE OR CONSENT.
 THE PDF DOCUMENT STAMPED BY KTA AS A 'QA CONTROLLED DOCUMENT' IS THE ONLY OFFICIAL VERSION OF THIS DOCUMENT AND IS STRICTLY SUBJECT TO COPYRIGHT ©.
 THE CONTENT AND ACCURACY OF THE DOCUMENT IS STRICTLY LIMITED TO THAT DEPICTED IN THE QA CONTROLLED PDF. DO NOT MEASURE FROM THE ELECTRONIC OR HARD COPY VERSIONS OF THIS DOCUMENT.
 VERIFY ALL DIMENSIONS ON SITE BEFORE COMMENCING SHOP DRAWINGS, FABRICATION, CONSTRUCTION OR INSTALLATION.

NO.	REVISION	BY	CHK	DATE	REVISION NOTES:
1	FOR INFORMATION			17.12.2021	
2	PRE-CONCRETE			20.11.2022	
3	COORDINATION ISSUE			09.02.2020	
4	AMENDED COORDINATION ISSUE	AL	RPW	19.05.2022	
5	DA ISSUE	RPW	JAC	08.06.2022	
6	COUNCIL RFI COORDINATION ISSUE	AL/CK	RPW	31.07.2023	
7	COUNCIL RFI ISSUE	AL/CK	RPW	15.08.2023	
8	ISSUE FOR DA RESUBMISSION	AL	RPW	02.02.2024	

CLIENT
 Kurraba Point Road Pty Ltd
 430 TOORAK ROAD, TOORAK 3142

ARCHITECT
 SUITE 41 & 42, LEVEL 4
 61 MARLBOROUGH ST
 SURRY HILLS, NSW 2010
 T 02 9698 8510
 ABN 63 131 365 896
 NOMINATED ARCHITECT:
 KOICHI TAKADA
 NSW ARCHITECTS 6901
 VIC ARCHITECTS 16179
 QLD ARCHITECTS 5590
 KOICHIKAKADA.COM

Koichi Takada Architects

QA STAMP
 THIS DOCUMENT IS NOT SUITABLE OR APPROVED FOR CONSTRUCTION AT ANY TIME UNLESS KTA HAVE NOTATED THE STATUS TITLE AS FOR CONSTRUCTION WITHOUT THE PRESENCE OF 'WIP', 'DRAFT' OR ANY OTHER FORM OF QUALIFICATION ON THE DOCUMENT.

PROJECT
 190 KURRABA RD
 190 KURRABA RD, KURRABA POINT NSW 2089

STATUS
 DEVELOPMENT APPLICATION - RFI 01

DWG TITLE	DWG NO.	SCALE	REVISION	DATE
PERSPECTIVE 02	A003		8	02.02.2024



NO.	REVISION	BY	CHK	DATE
1	DA ISSUE	RPW	AG	08.06.2022
2	COUNCIL RFI COORDINATION ISSUE	AL/DK	RPW	31.07.2023
3	COUNCIL RFI ISSUE	AL/DK	RPW	15.08.2023
4	ISSUE FOR DA RESUBMISSION	AL	RPW	02.02.2024

REVISION NOTES:

KEY PLAN


NOTES:
<p>KOICHI TAKADA ARCHITECTS (KTA) RETAIN ALL COMMON LAW AND STATUTORY RIGHTS INCLUDING COPYRIGHT AND INTELLECTUAL PROPERTY RIGHTS TO THIS DOCUMENT. THIS DOCUMENT MUST NOT BE EDITED, PARTIALLY EXTRACTED, REPRODUCED OR DISTRIBUTED IN ANY MANNER WITHOUT KTA'S EXPRESS WRITTEN CONSENT AND UNDER NO CIRCUMSTANCES SHALL THE TRANSFER OF THIS DOCUMENT BE DEEMED A SALE OR CONSTITUTE A TRANSFER OF ANY LICENCE TO USE THE DOCUMENT WITHOUT KTA'S KNOWLEDGE OR CONSENT. THE PDF DOCUMENT STAMPED BY KTA AS A 'QA CONTROLLED DOCUMENT' IS THE ONLY OFFICIAL VERSION OF THIS DOCUMENT AND IS STRICTLY SUBJECT TO COPYRIGHT ©.</p> <p>THE CONTENT AND ACCURACY OF THE DOCUMENT IS STRICTLY LIMITED TO THAT DEPICTED IN THE QA CONTROLLED PDF. DO NOT MEASURE FROM THE ELECTRONIC OR HARD COPY VERSIONS OF THIS DOCUMENT.</p> <p>VERIFY ALL DIMENSIONS ON SITE BEFORE COMMENCING SHOP DRAWINGS, FABRICATION, CONSTRUCTION OR INSTALLATION.</p>

OTHERS:

CLIENT:
<p>Kurraba Point Road Pty Ltd 430 TOORAK ROAD, TOORAK 3142</p>

ARCHITECT:
<p>SUITE 41 & 42, LEVEL 4 61 MARLBOROUGH ST SURRY HILLS, NSW 2010 T 02 9698 8510 ASN 63 131 365 896 NOMINATED ARCHITECT: KOICHI TAKADA NSW ARCHITECTS 6901 VIC ARCHITECTS 16179 QLD ARCHITECTS 5590 KOICHI.TAKADA.COM</p>

Koichi Takada Architects

 QA STAMP:


PROJECT:	
<p>190 KURRABA RD 190 KURRABA RD, KURRABA POINT NSW 2089</p>	
STATUS:	DEVELOPMENT APPLICATION - RFI 01

DWG TITLE:	CONTEXT PLAN
DWG NO.:	A007
REVISION:	4
DATE:	02.02.2024

THIS DOCUMENT IS NOT SUITABLE OR APPROVED FOR CONSTRUCTION AT ANY TIME UNLESS KTA HAVE NOTATED THE STATUS TITLE AS FOR CONSTRUCTION WITHOUT THE PRESENCE OF 'WIP', 'DRAFT' OR ANY OTHER FORM OF QUALIFICATION ON THE DOCUMENT.



NO.	REVISION	BY	CHK	DATE
1	DA ISSUE	RPW	AG	08.06.2022
2	COUNCIL RFI COORDINATION ISSUE	AL/DK	RPW	31.07.2023
3	COUNCIL RFI ISSUE	AL/DK	RPW	15.08.2023
4	ISSUE FOR DA RESUBMISSION	AL	RPW	02.02.2024

REVISION NOTES:	

KEY PLAN

NOTES:
 KOICHI TAKADA ARCHITECTS (KTA) RETAIN ALL COMMON LAW AND STATUTORY RIGHTS INCLUDING COPYRIGHT AND INTELLECTUAL PROPERTY RIGHTS TO THIS DOCUMENT.
 THIS DOCUMENT MUST NOT BE EDITED, PARTIALLY EXTRACTED, REPRODUCED OR DISTRIBUTED IN ANY MANNER WITHOUT KTA'S EXPRESS WRITTEN CONSENT AND UNDER NO CIRCUMSTANCES SHALL THE TRANSFER OF THIS DOCUMENT BE DEEMED A SALE OR CONSTITUTE A TRANSFER OF ANY LICENCE TO USE THE DOCUMENT WITHOUT KTA'S KNOWLEDGE OR CONSENT.
 THE PDF DOCUMENT STAMPED BY KTA AS A 'QA CONTROLLED DOCUMENT' IS THE ONLY OFFICIAL VERSION OF THIS DOCUMENT AND IS STRICTLY SUBJECT TO COPYRIGHT ©.
 THE CONTENT AND ACCURACY OF THE DOCUMENT IS STRICTLY LIMITED TO THAT DEPICTED IN THE QA CONTROLLED PDF. DO NOT MEASURE FROM THE ELECTRONIC OR HARD COPY VERSIONS OF THIS DOCUMENT.
 VERIFY ALL DIMENSIONS ON SITE BEFORE COMMENCING SHOP DRAWINGS, FABRICATION, CONSTRUCTION OR INSTALLATION.

OTHERS:

CLIENT:
 Kurraba Point Road Pty Ltd
 430 TOORAK ROAD, TOORAK 3142

ARCHITECT:
 SUITE 41 & 42, LEVEL 4
 61 MARLBOROUGH ST
 SURRY HILLS, NSW 2010
 T 02 9698 8510
 ABN 63 131 365 896
 NOMINATED ARCHITECT:
 KOICHI TAKADA
 NSW ARCHITECTS 6901
 VIC ARCHITECTS 16179
 QLD ARCHITECTS 5590
 KOICHI TAKADA.COM

Koichi Takada Architects

QA STAMP

THIS DOCUMENT IS NOT SUITABLE OR APPROVED FOR CONSTRUCTION AT ANY TIME UNLESS KTA HAVE NOTATED THE STATUS TITLE AS FOR CONSTRUCTION WITHOUT THE PRESENCE OF 'WIP', 'DRAFT' OR ANY OTHER FORM OF QUALIFICATION ON THE DOCUMENT.

PROJECT:
 190 KURRABA RD
 190 KURRABA RD, KURRABA POINT NSW 2089

STATUS:
 DEVELOPMENT APPLICATION - RFI 01


DWG TITLE:
 LOCATION PLAN

DWG NO.:
 A008


REVISION:
 4

DATE:
 02.02.2024

SCALE:
 1:1

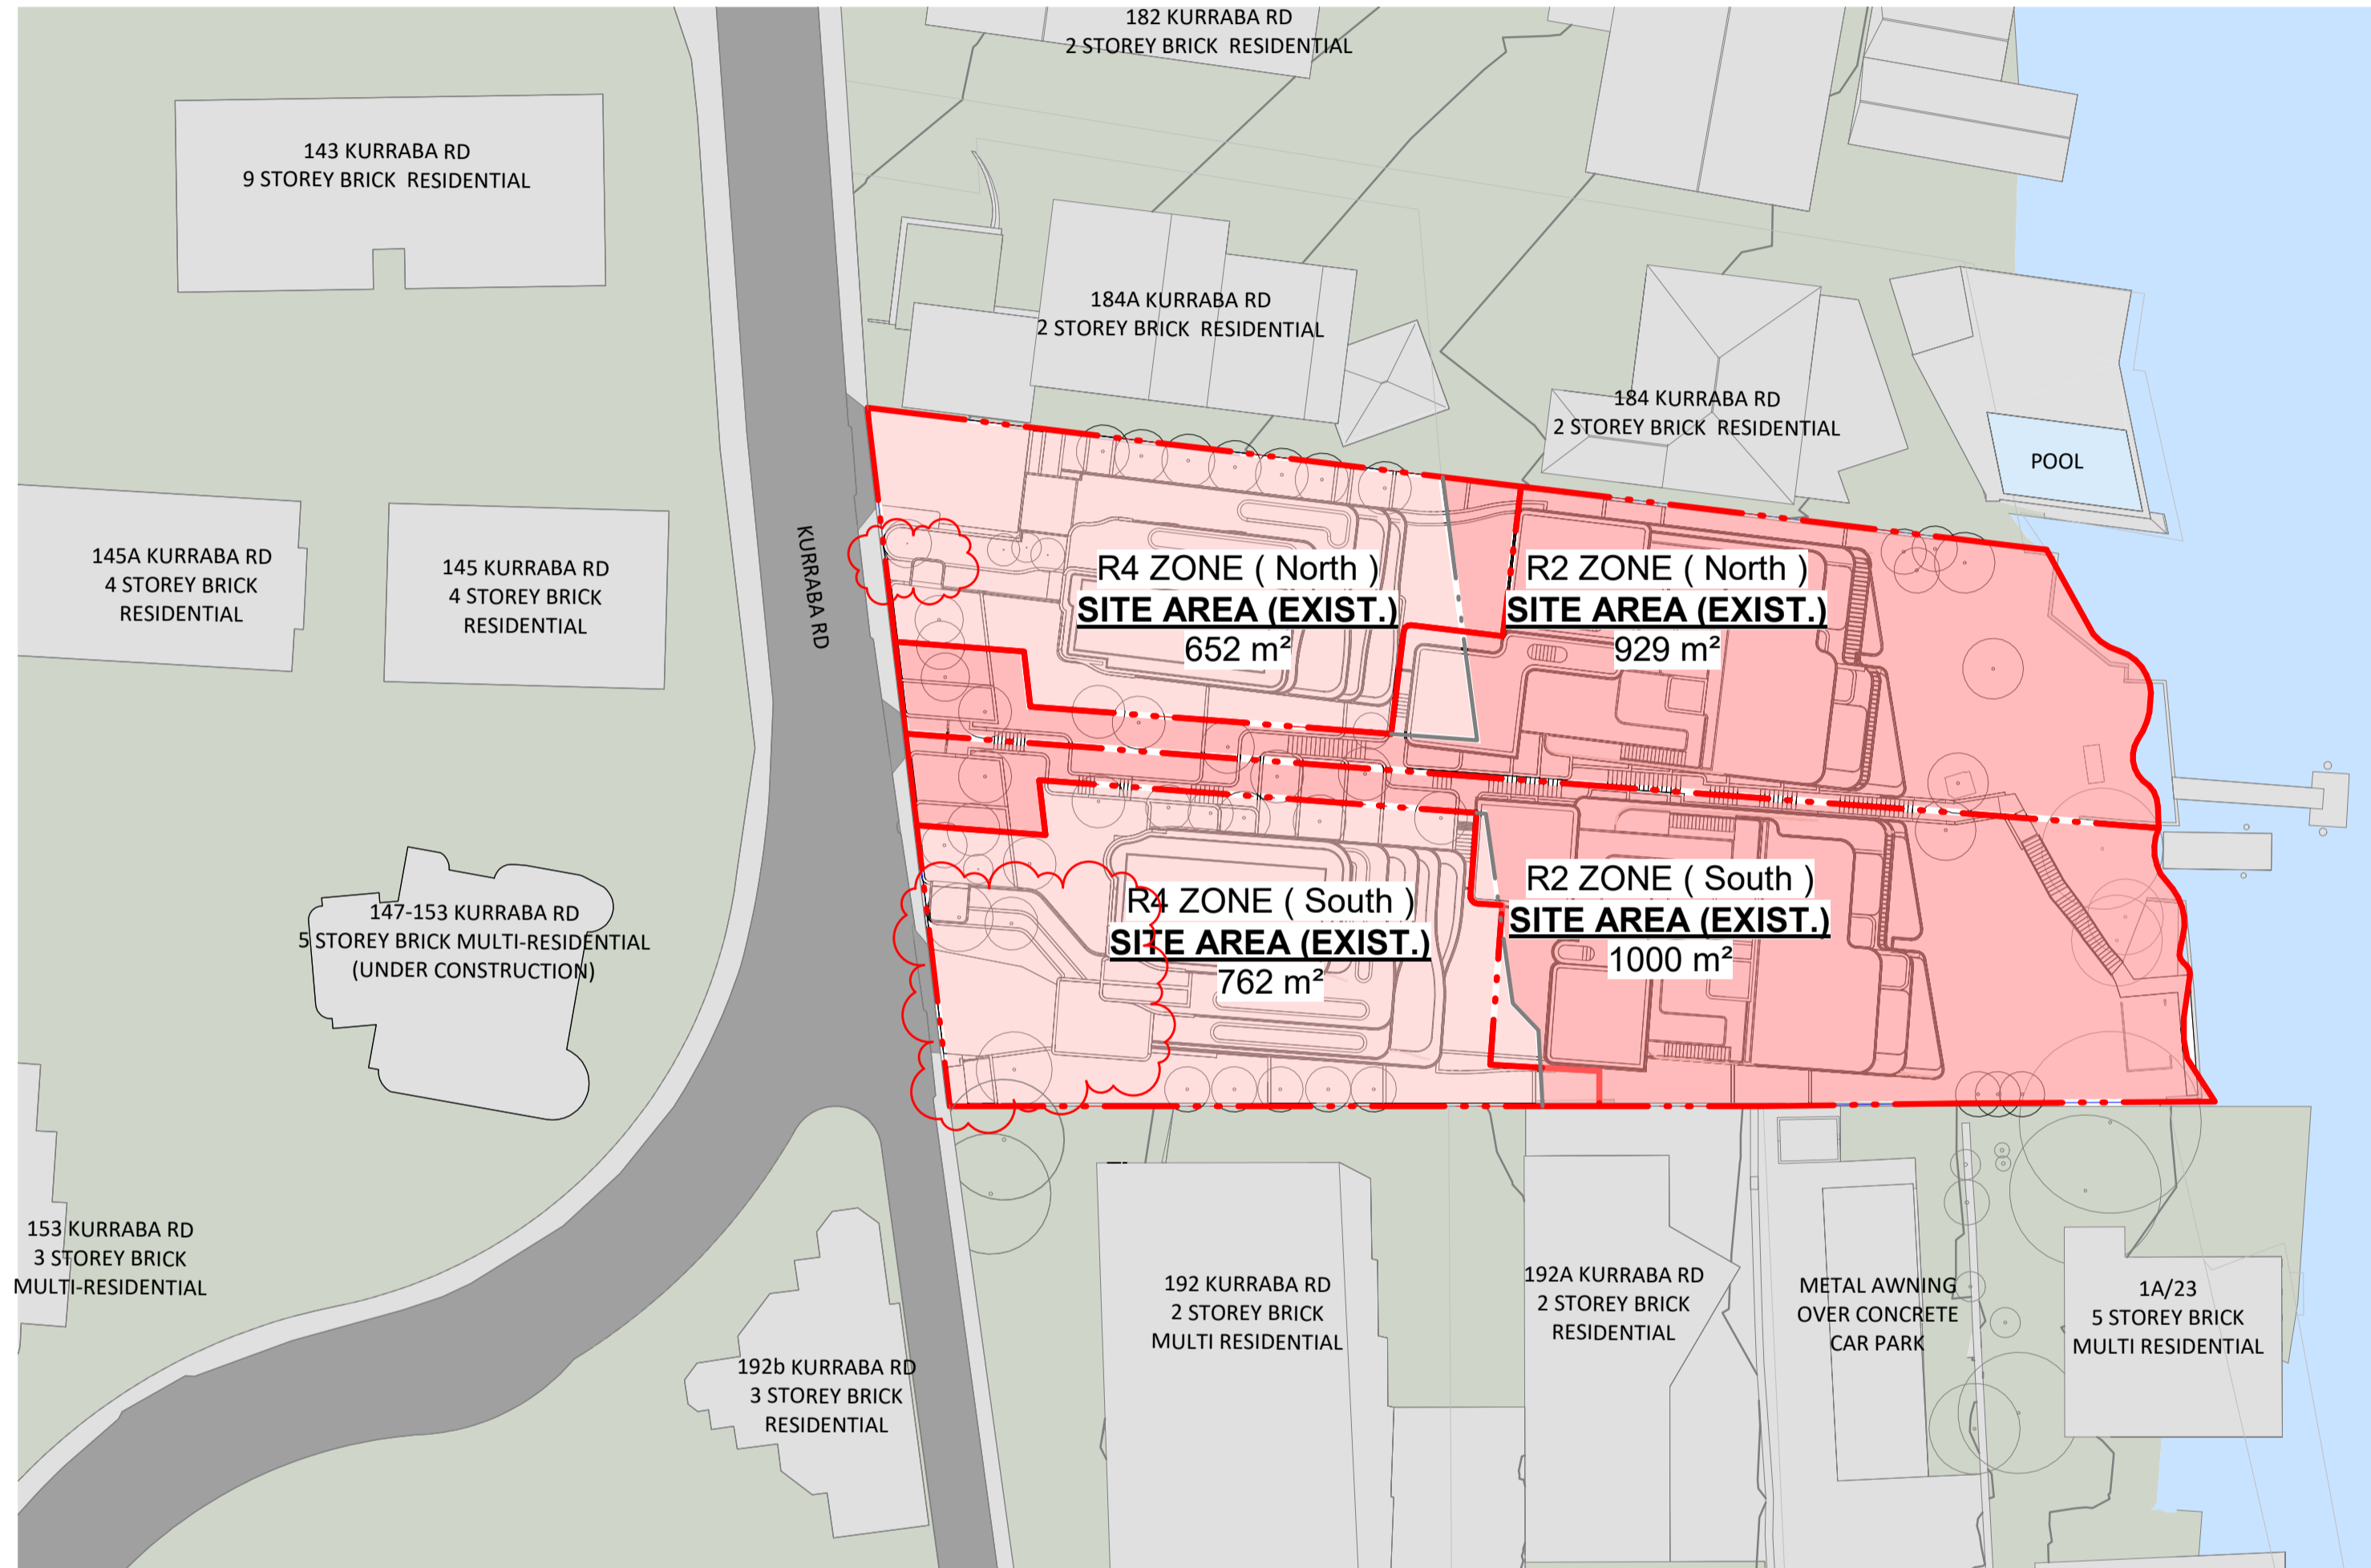

1 EXISTING & PROPOSED BOUNDARY OVERLAY
1 : 400

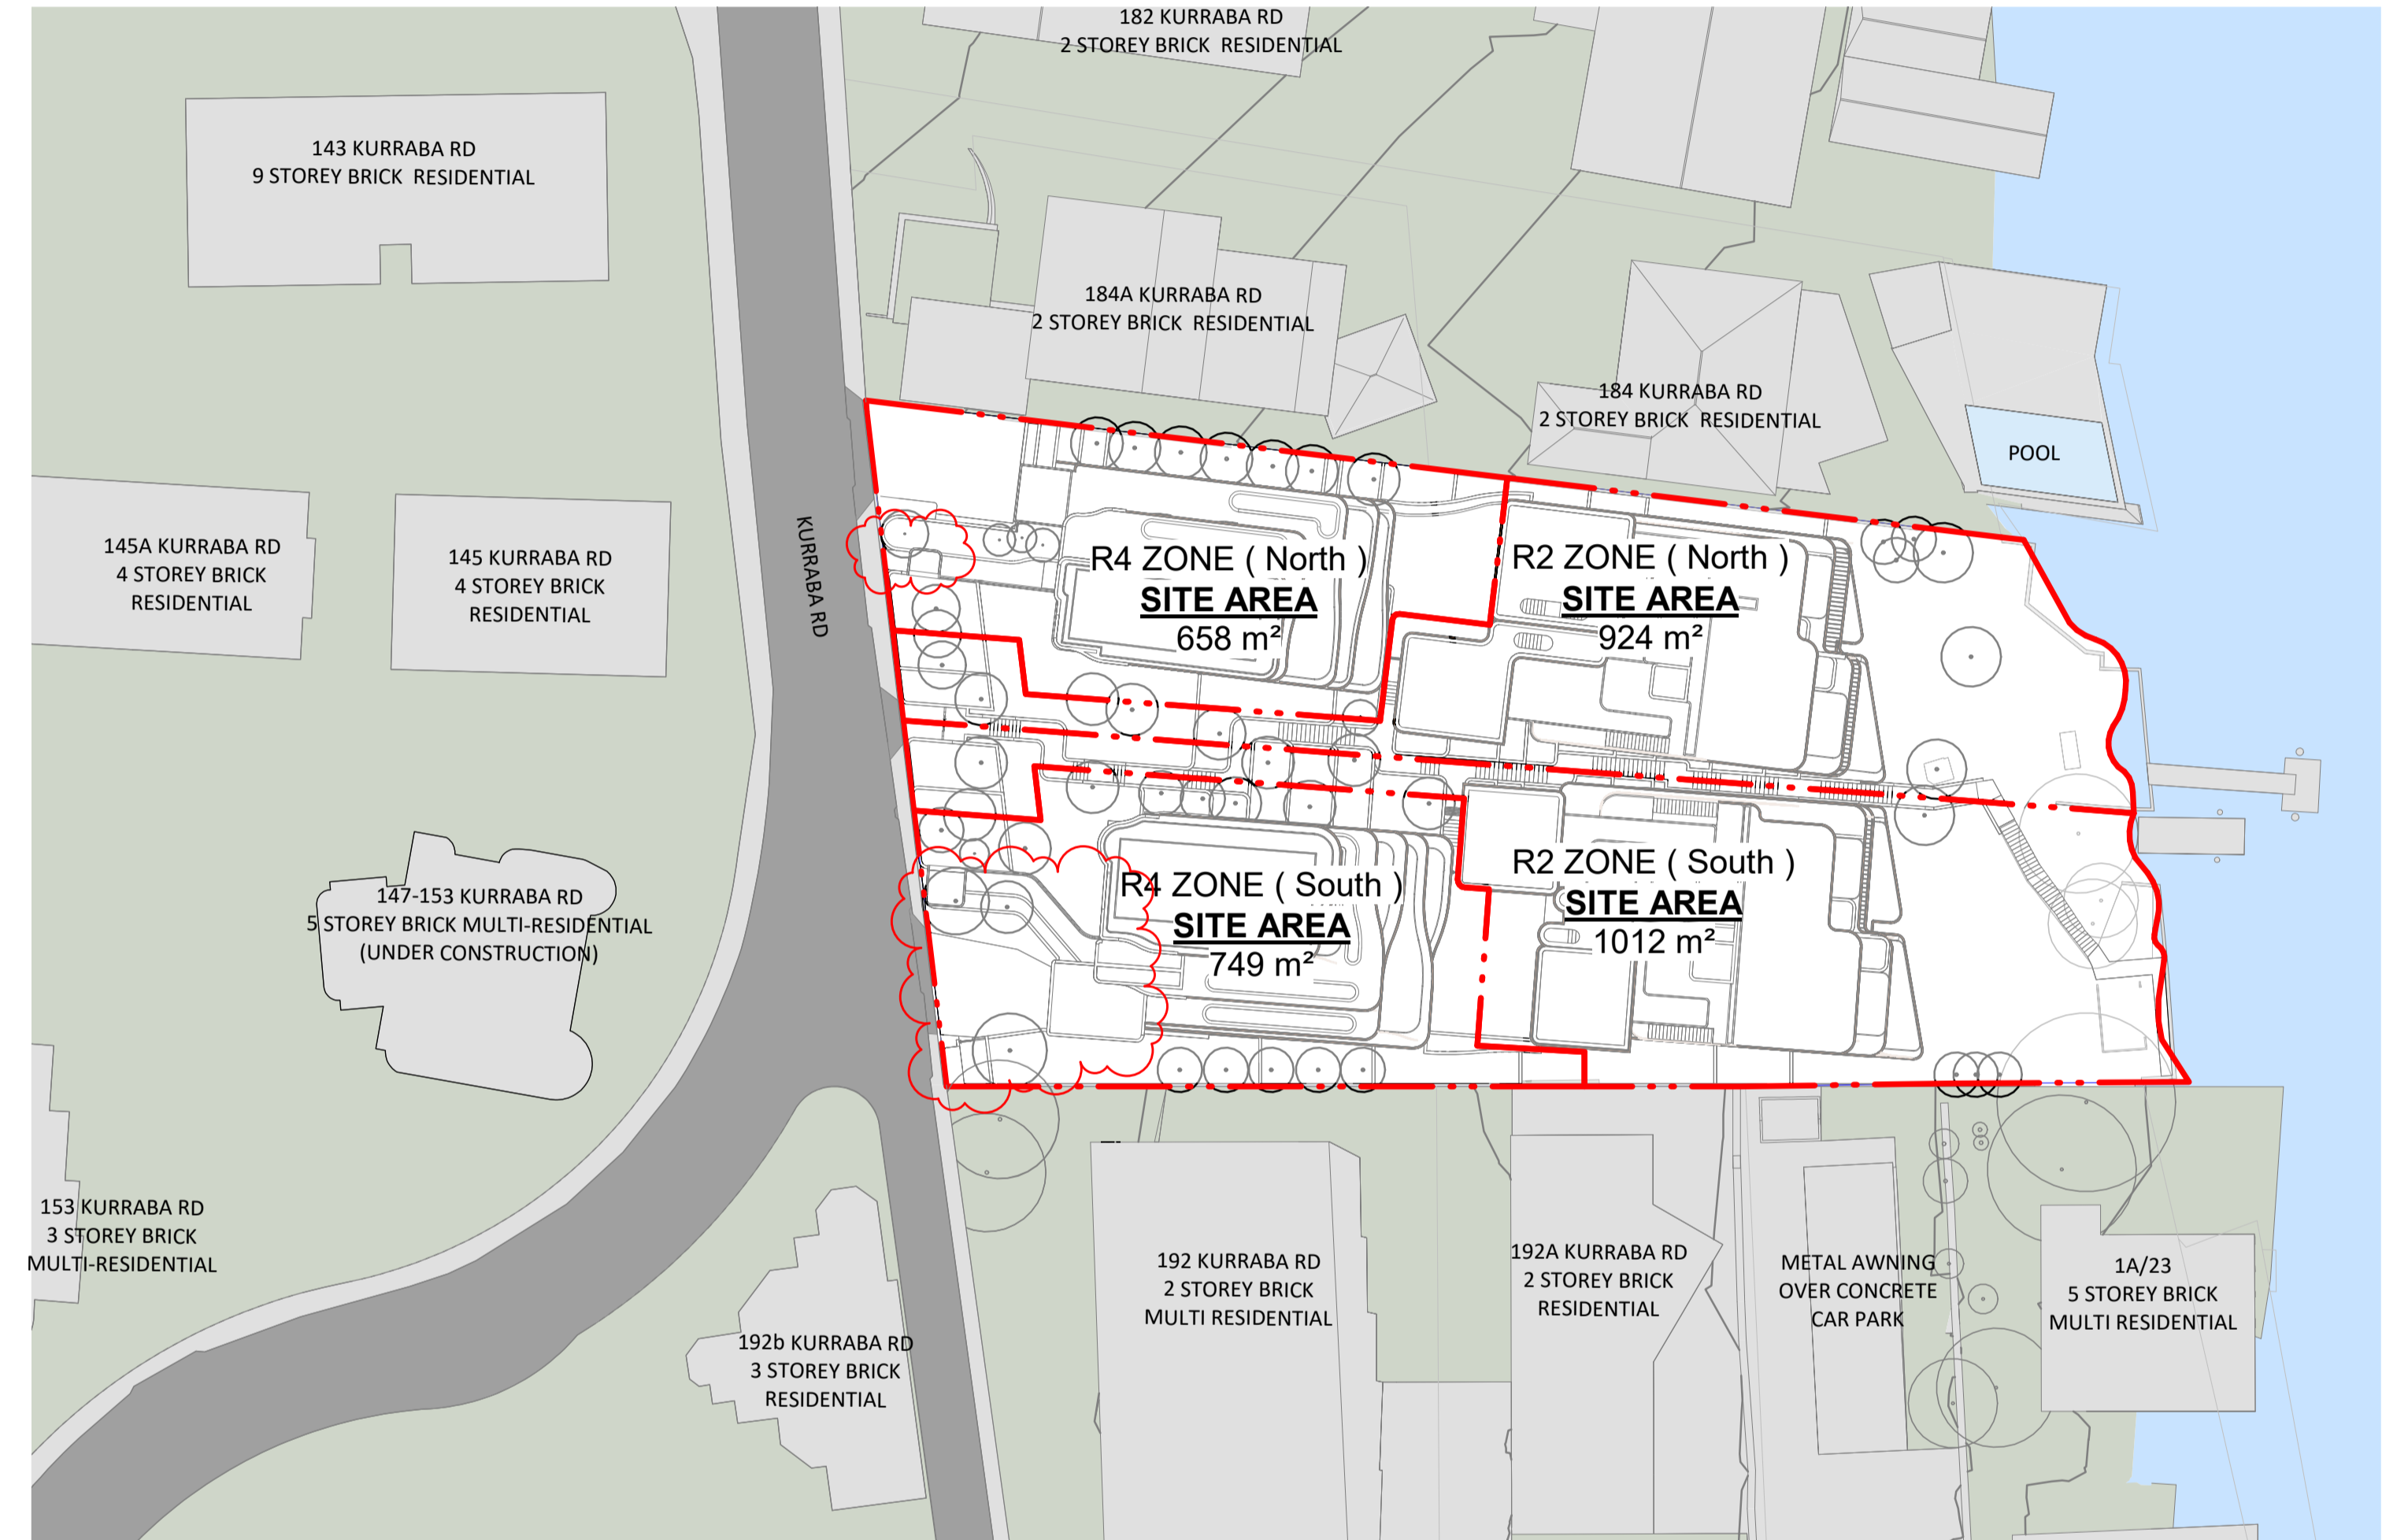

2 PROPOSED BOUNDARY ALIGNMENT
1 : 400

- LEGEND**
- - - PROPOSED SITE BOUNDARY
 - - - EXISTING SITE BOUNDARY
 - R2 ZONE
 - R4 ZONE

NO.	REVISION	BY	CHK	DATE	REVISION NOTES:
1	DA ISSUE	RPW	JAG	08.06.2022	
2	COUNCIL RFI COORDINATION ISSUE	AL/CK	RPW	31.07.2023	
3	COUNCIL RFI ISSUE	AL/CK	RPW	15.08.2023	
4	ISSUE FOR DA RESUBMISSION	AL	RPW	02.02.2024	

KEY PLAN
CLOUD LEGEND
○ REVISION
○ ON HOLD

NOTES:
KOICHI TAKADA ARCHITECTS (KTA) RETAIN ALL COMMON LAW AND STATUTORY RIGHTS INCLUDING COPYRIGHT AND INTELLECTUAL PROPERTY RIGHTS TO THIS DOCUMENT.
THIS DOCUMENT MUST NOT BE EDITED, PARTIALLY EXTRACTED, REPRODUCED OR DISTRIBUTED IN ANY MANNER WITHOUT KTA'S EXPRESS WRITTEN CONSENT AND UNDER NO CIRCUMSTANCES SHALL THE TRANSFER OF THIS DOCUMENT BE DEEMED A SALE OR CONSTITUTE A TRANSFER OF ANY LICENCE TO USE THE DOCUMENT.
THE PDF DOCUMENT STAMPED BY KTA AS A 'QA CONTROLLED DOCUMENT' IS THE ONLY OFFICIAL VERSION OF THIS DOCUMENT AND IS STRICTLY SUBJECT TO COPYRIGHT ©.
THE CONTENT AND ACCURACY OF THE DOCUMENT IS STRICTLY LIMITED TO THAT DEPICTED IN THE QA CONTROLLED PDF. DO NOT MEASURE FROM THE ELECTRONIC OR HARD COPY VERSIONS OF THIS DOCUMENT.
VERIFY ALL DIMENSIONS ON SITE BEFORE COMMENCING SHOP DRAWINGS, FABRICATION, CONSTRUCTION OR INSTALLATION.

OTHERS:

CLIENT
Kurraba Point Road Pty Ltd
430 TOORAK ROAD, TOORAK 3142

ARCHITECT
SUITE 41 & 42, LEVEL 4
61 MARLBOROUGH ST
SURRY HILLS, NSW 2010
T 02 9698 8510
ABN 63 131 365 896
NOMINATED ARCHITECT:
KOICHI TAKADA
NSW ARCHITECTS 6901
VIC ARCHITECTS 16179
QLD ARCHITECTS 5590
KOICHI TAKADA.COM

Koichi Takada Architects

GA STAMP

THIS DOCUMENT IS NOT SUITABLE OR APPROVED FOR CONSTRUCTION AT ANY TIME UNLESS KTA HAVE NOTATED THE STATUS TITLE AS FOR CONSTRUCTION WITHOUT THE PRESENCE OF 'WIP', 'DRAFT' OR ANY OTHER FORM OF QUALIFICATION ON THE DOCUMENT.

PROJECT
190 KURRABA RD
190 KURRABA RD, KURRABA POINT NSW
2089

STATUS
DEVELOPMENT APPLICATION - RFI 01


SCALE
1:400@A1, 1:800@A3

DWG TITLE
BOUNDARY ALIGNMENT PLAN

DWG NO.
A009

REVISION
4

DATE
02.02.2024

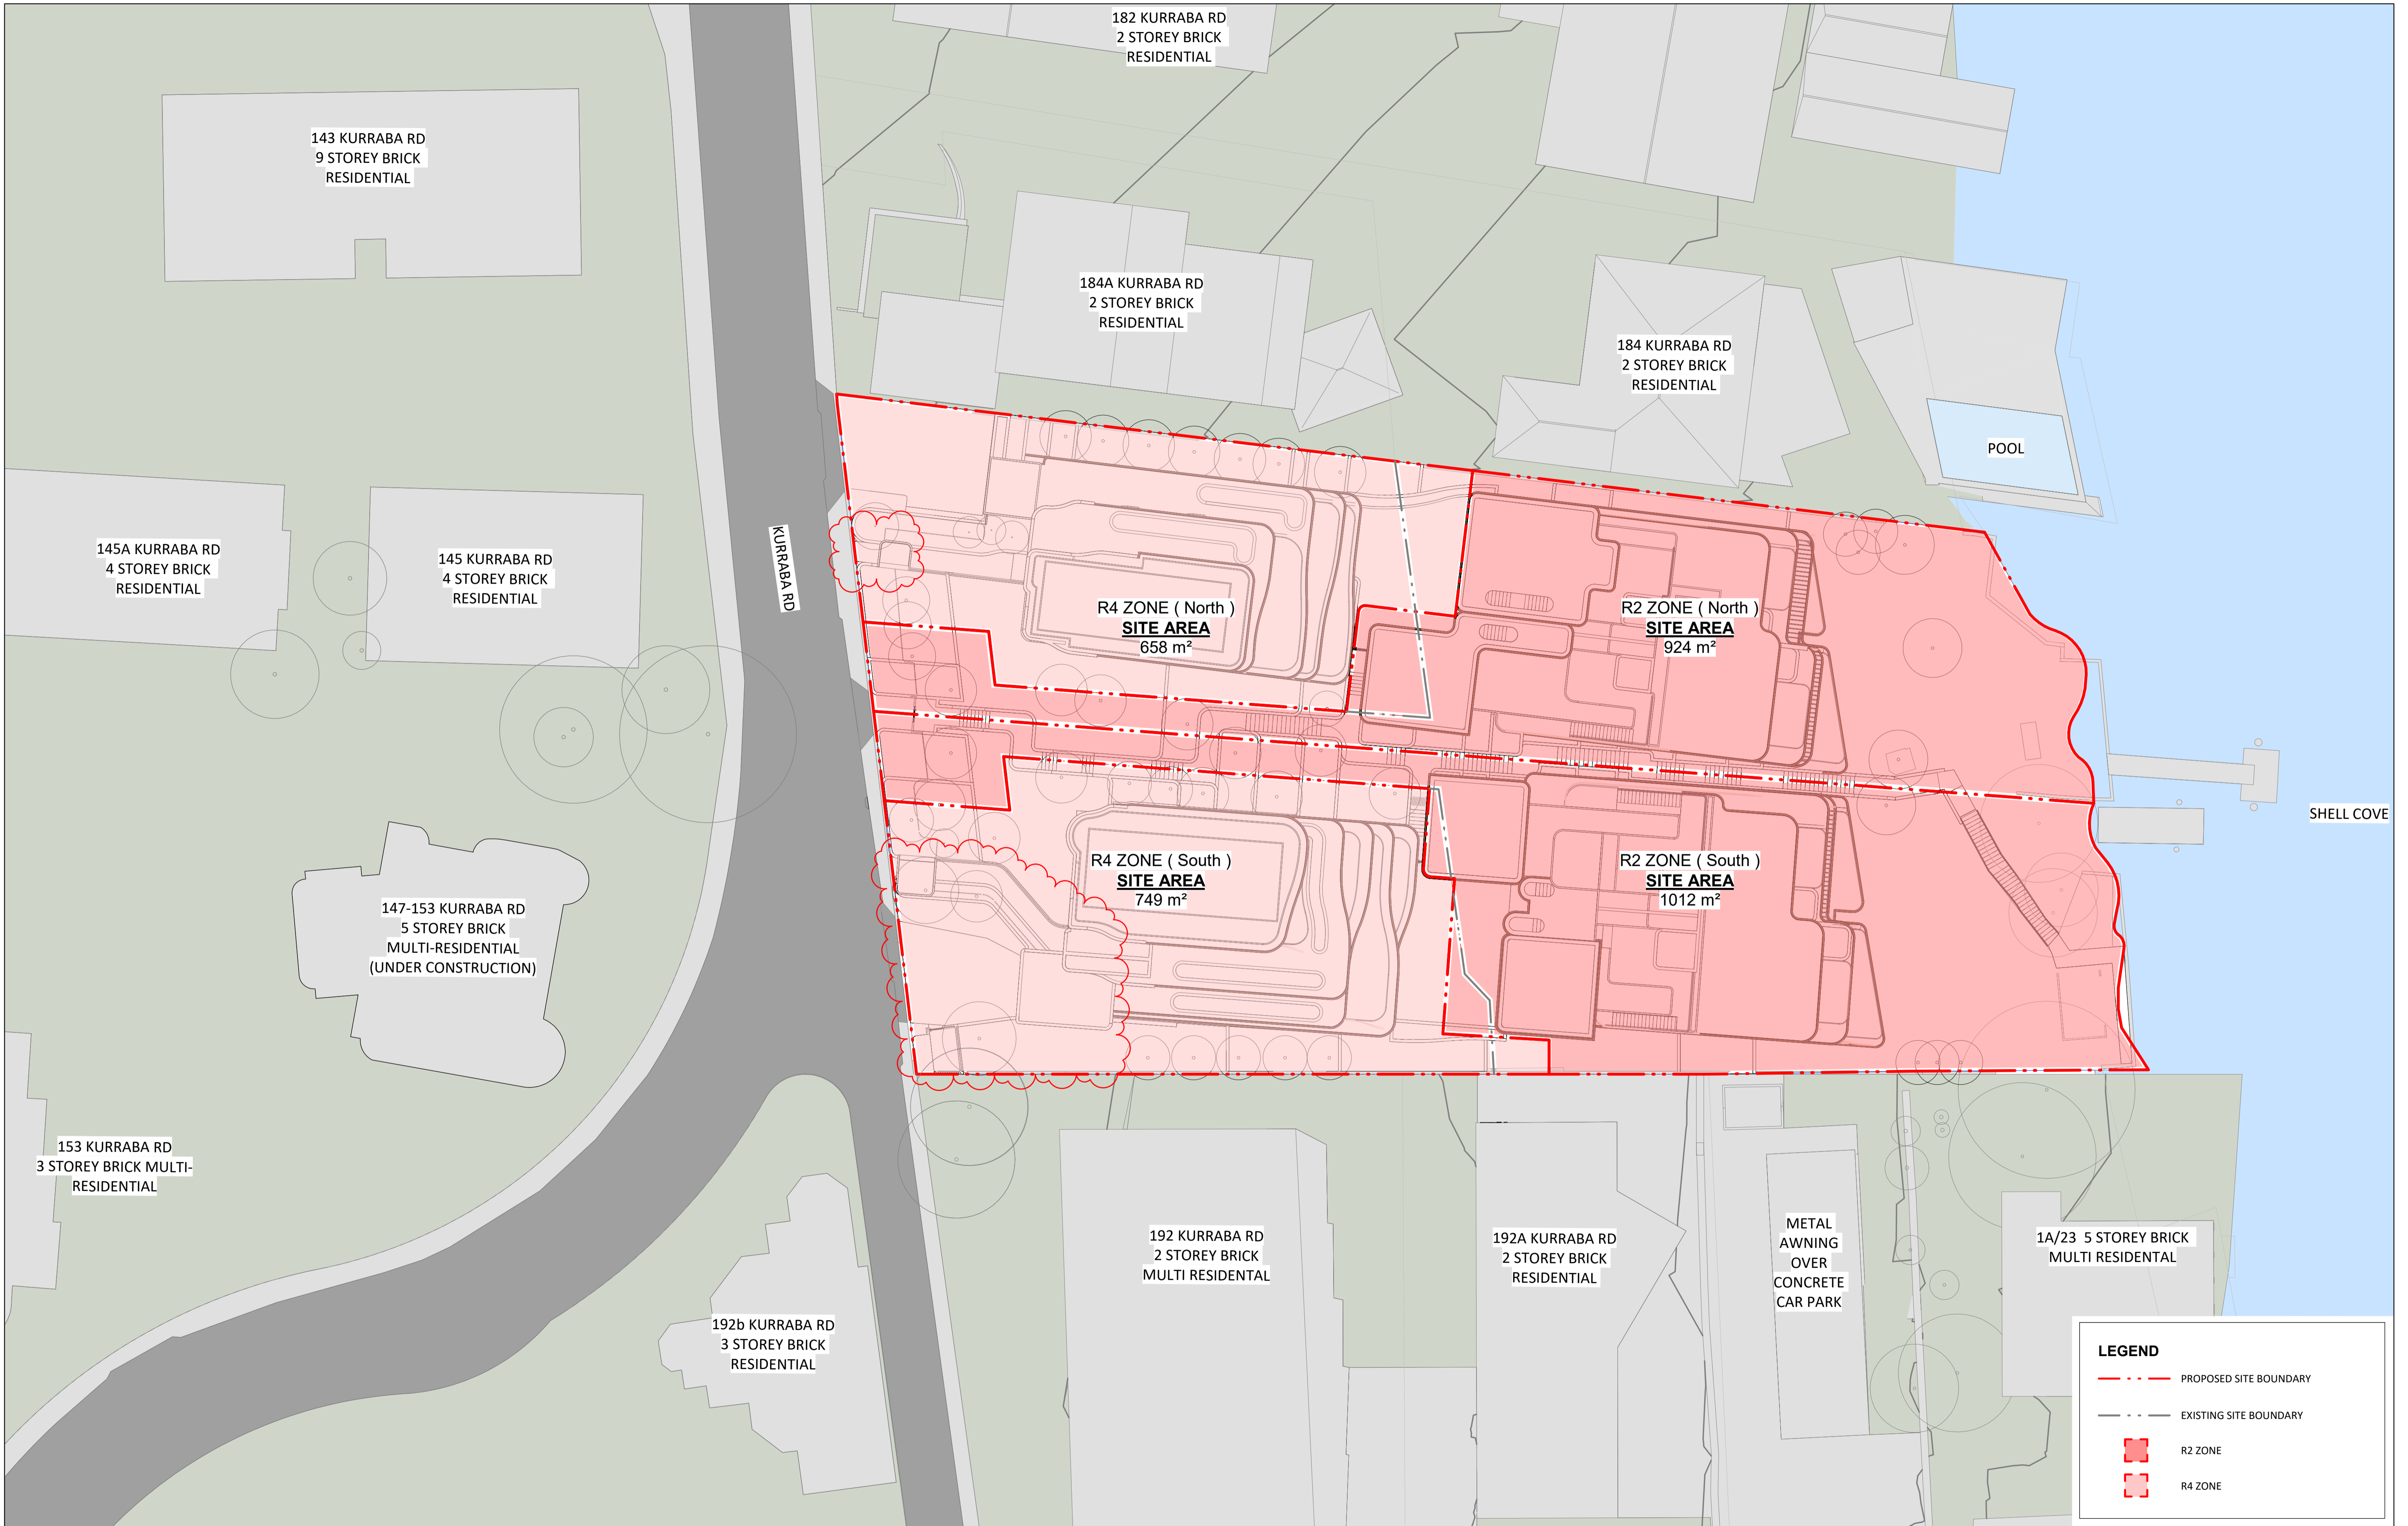

LEGEND

- - - - - PROPOSED SITE BOUNDARY
- - - - - EXISTING SITE BOUNDARY
- R2 ZONE
- R4 ZONE

NO.	REVISION	BY	CHK	DATE	REVISION NOTES:
1	FOR INFORMATION			18.11.2021	
2	FOR INFORMATION			08.12.2021	
3	FOR INFORMATION			17.12.2021	
4	PRE-LODGE			20.01.2022	
5	COORDINATION ISSUE			09.02.2022	
6	AMENDED COORDINATION ISSUE	AL	RPW	19.05.2022	
7	DA ISSUE	RPW	JAC	08.06.2022	
8	COUNCIL RFI COORDINATION ISSUE	AL/CK	RPW	31.07.2023	
9	COUNCIL RFI ISSUE	AL/CK	RPW	15.08.2023	
10	ISSUE FOR DA RESUBMISSION	AL	RPW	02.02.2024	

KEY PLAN

CLOUD LEGEND

- REVISION
- ON HOLD

NOTES:
 KOICHI TAKADA ARCHITECTS (KTA) RETAINS ALL COMMON LAW AND STATUTORY RIGHTS INCLUDING COPYRIGHT AND INTELLECTUAL PROPERTY RIGHTS TO THIS DOCUMENT.
 THIS DOCUMENT MUST NOT BE EDITED, PARTIALLY EXTRACTED, REPRODUCED OR DISTRIBUTED IN ANY MANNER WITHOUT KTA'S EXPRESS WRITTEN CONSENT AND UNDER NO CIRCUMSTANCES SHALL THE TRANSFER OF THIS DOCUMENT BE DEEMED A SALE OR CONSTITUTE A TRANSFER OF ANY LICENCE TO USE THE DOCUMENT WITHOUT KTA'S KNOWLEDGE OR CONSENT.
 THE PDF DOCUMENT STAMPED BY KTA AS A QA CONTROLLED DOCUMENT IS THE ONLY OFFICIAL VERSION OF THIS DOCUMENT AND IS STRICTLY SUBJECT TO COPYRIGHT ©.
 THE CONTENT AND ACCURACY OF THE DOCUMENT IS STRICTLY LIMITED TO THAT DEPICTED IN THE QA CONTROLLED PDF. DO NOT MEASURE FROM THE ELECTRONIC OR HARD COPY VERSIONS OF THIS DOCUMENT.
 VERIFY ALL DIMENSIONS ON SITE BEFORE COMMENCING SHOP DRAWINGS, FABRICATION, CONSTRUCTION OR INSTALLATION.

CLIENT:
 Kurraba Point Road Pty Ltd
 430 TOORAK ROAD, TOORAK 3142

ARCHITECT:
 SUITE 41 & 42, LEVEL 4
 61 MARLBOROUGH ST
 SURRY HILLS, NSW 2010
 T 02 9698 8510
 ABN 63 131 365 896
 NOMINATED ARCHITECT:
 KOICHI TAKADA
 NSW ARCHITECTS 6901
 VIC ARCHITECTS 16179
 QLD ARCHITECTS 5590
 KOICHI TAKADA.COM

Koichi Takada Architects


PROJECT:
 190 KURRABA RD
 190 KURRABA RD, KURRABA POINT NSW
 2089

STATUS:
 DEVELOPMENT APPLICATION - RFI 01

SCALE:
 1:200@A1, 1:400@A3

DATE:
 02.02.2024

DWG NO.	REVISION	DATE
A010	10	02.02.2024

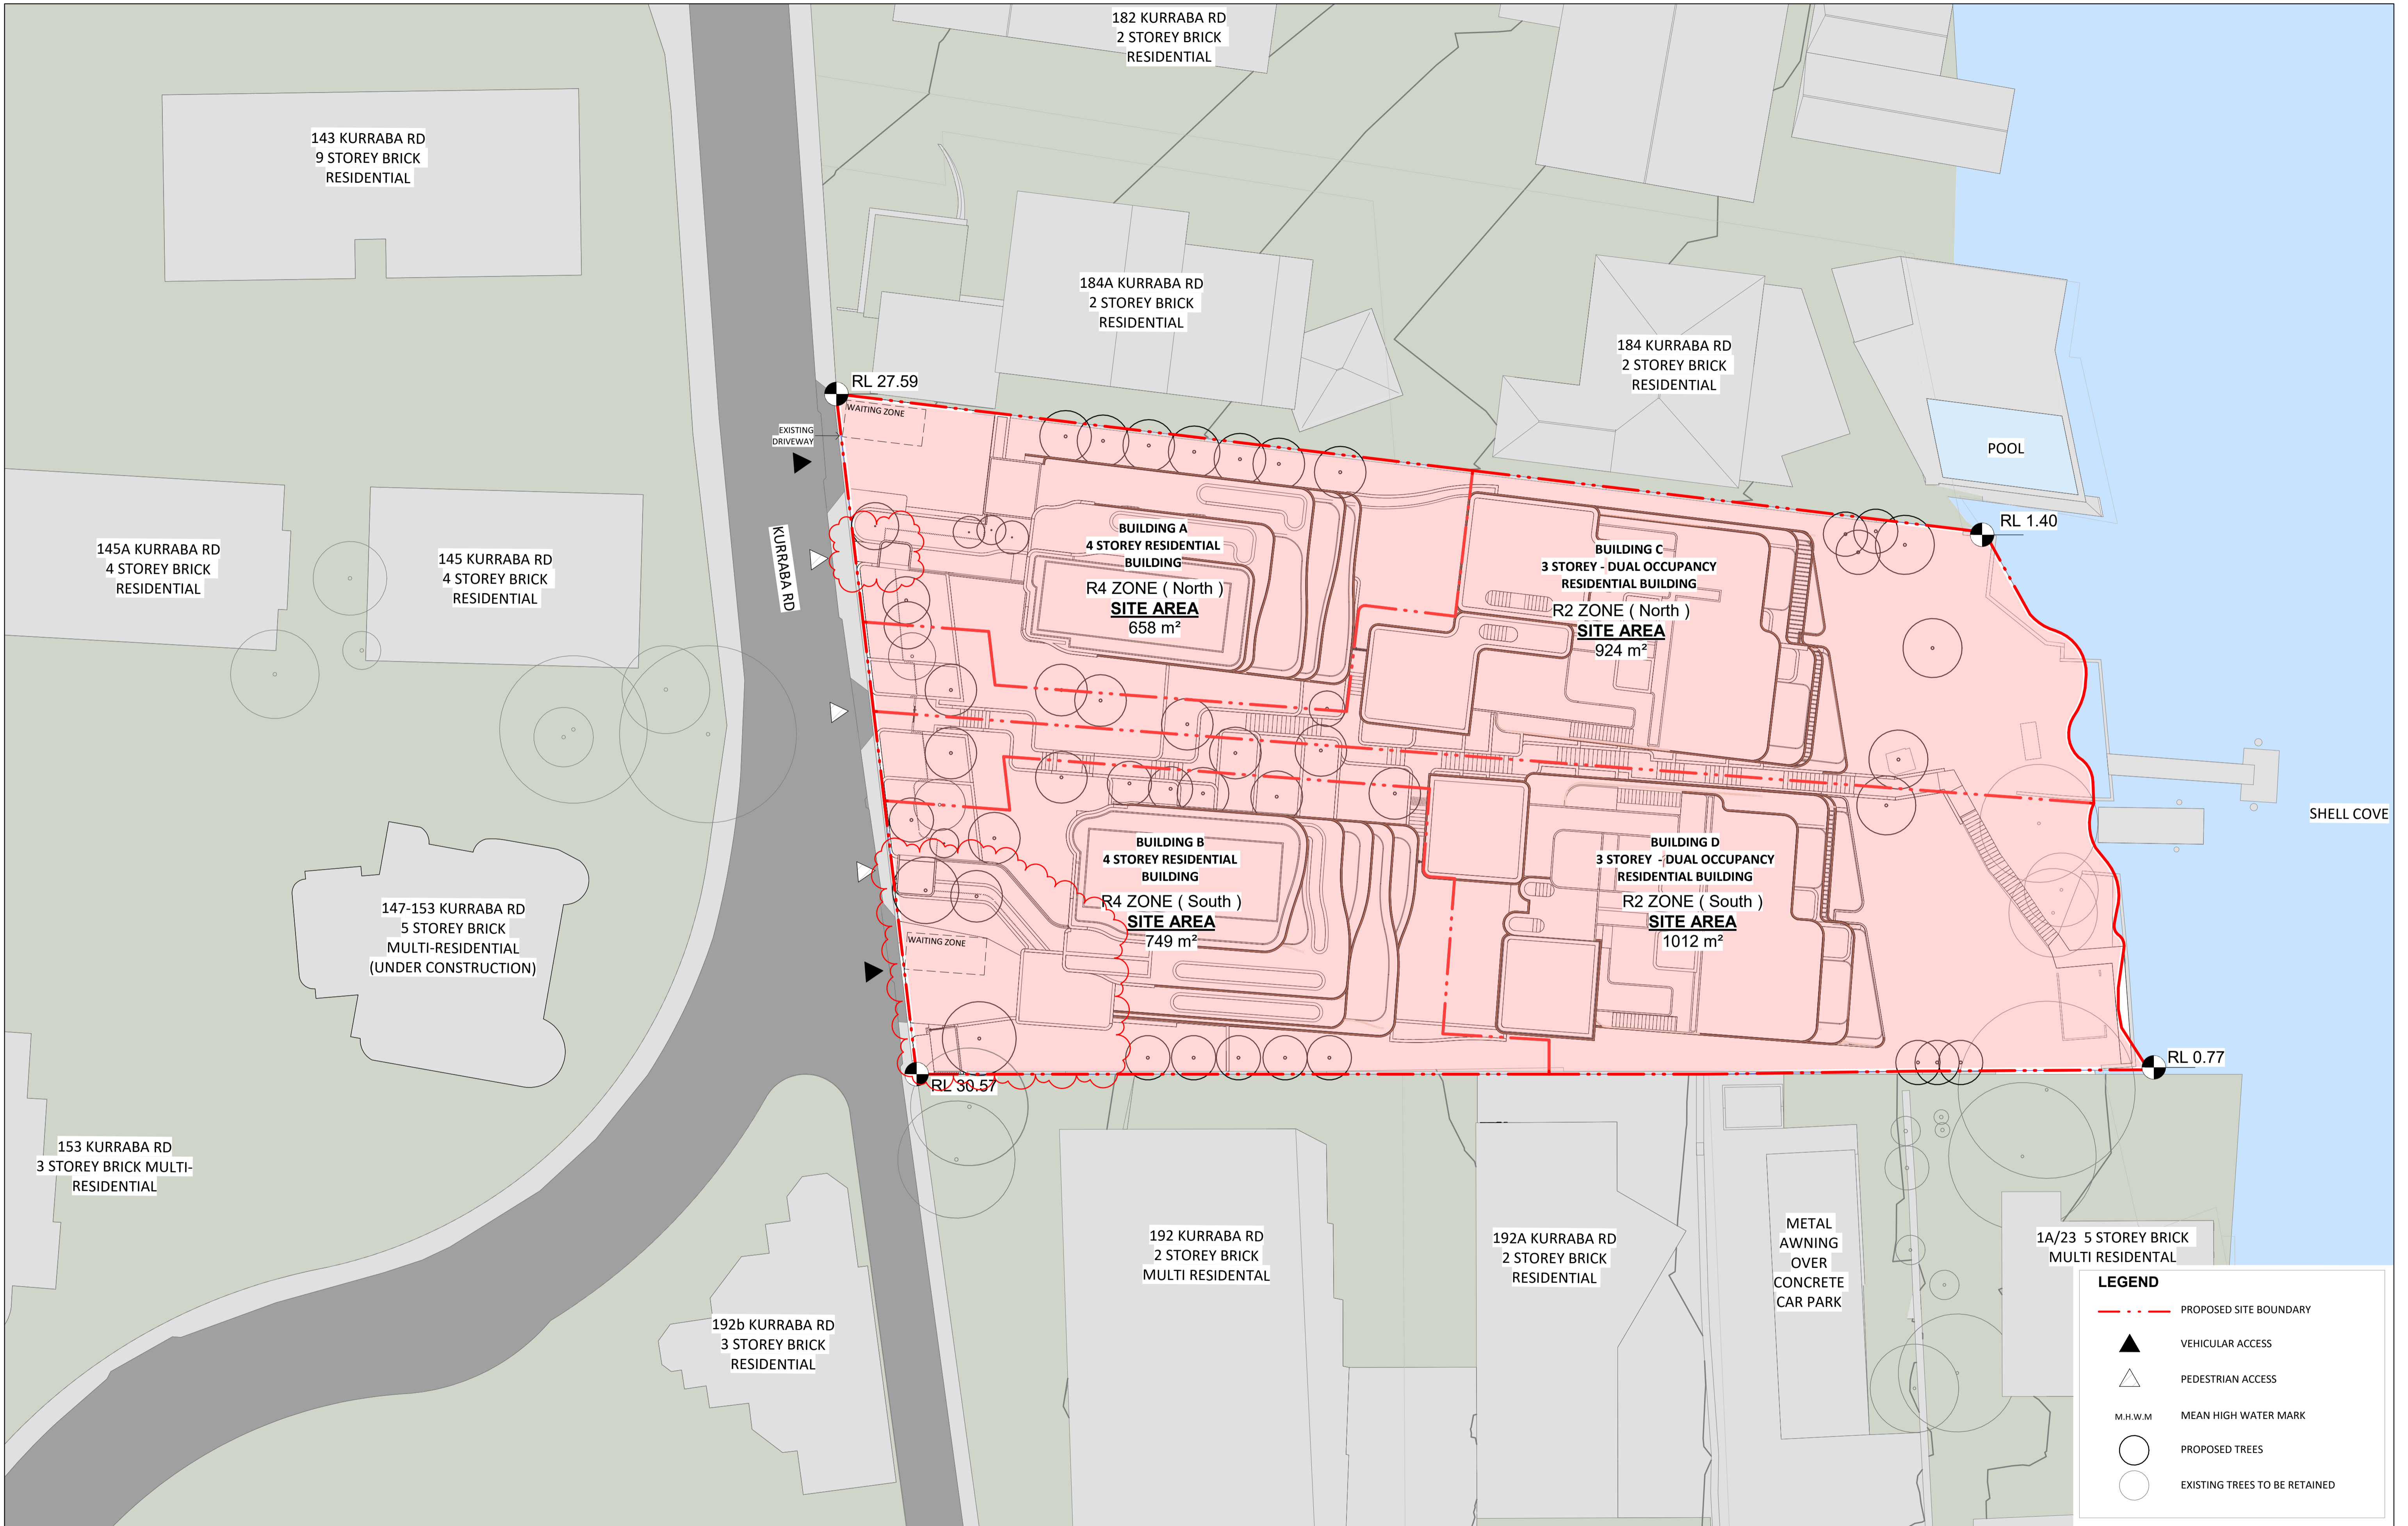

LEGEND	
	PROPOSED SITE BOUNDARY
	VEHICULAR ACCESS
	PEDESTRIAN ACCESS
	MEAN HIGH WATER MARK
	PROPOSED TREES
	EXISTING TREES TO BE RETAINED

NO.	REVISION	BY	CHK	DATE	REVISION NOTES:
1	FOR INFORMATION			18.11.2021	
2	FOR INFORMATION			08.12.2021	
3	FOR INFORMATION			17.12.2021	
4	PRE-LODGE			20.01.2022	
5	COORDINATION ISSUE			09.02.2022	
6	AMENDED COORDINATION ISSUE	AL	RPW	19.05.2022	
7	DA ISSUE	RPW	AC	08.06.2022	
8	RFI TRAFFIC COORDINATION	AL	RPW	24.07.2023	
9	COUNCIL RFI COORDINATION ISSUE	AL/CR	RPW	31.07.2023	
10	COUNCIL RFI ISSUE	AL/CR	RPW	15.08.2023	
11	ISSUE FOR DA RESUBMISSION	AL	RPW	02.02.2024	

KEY PLAN
REVISION ON HOLD

NOTES:
 KOICHI TAKADA ARCHITECTS (KTA) RETAINS ALL COMMON LAW AND STATUTORY RIGHTS INCLUDING COPYRIGHT (D) AND INTELLECTUAL PROPERTY RIGHTS TO THIS DOCUMENT.
 THIS DOCUMENT MUST NOT BE EDITED, PARTIALLY EXTRACTED, REPRODUCED OR DISTRIBUTED IN ANY MANNER WITHOUT KTA'S EXPRESS WRITTEN CONSENT AND UNDER NO CIRCUMSTANCES SHALL THE TRANSFER OF THIS DOCUMENT BE DEEMED A SALE OR CONSTITUTE A TRANSFER OF ANY LICENCE TO USE THE DOCUMENT WITHOUT KTA'S KNOWLEDGE OR CONSENT.
 THE PDF DOCUMENT STAMPED BY KTA AS A 'QA CONTROLLED DOCUMENT' IS THE ONLY OFFICIAL VERSION OF THIS DOCUMENT AND IS STRICTLY SUBJECT TO COPYRIGHT ©.
 THE CONTENT AND ACCURACY OF THE DOCUMENT IS STRICTLY LIMITED TO THAT DEPICTED IN THE QA CONTROLLED PDF. DO NOT MEASURE FROM THE ELECTRONIC OR HARD COPY VERSIONS OF THIS DOCUMENT.
 VERIFY ALL DIMENSIONS ON SITE BEFORE COMMENCING SHOP DRAWINGS, FABRICATION, CONSTRUCTION OR INSTALLATION.

CLIENT
 Kurraba Point Road Pty Ltd
 430 TOORAK ROAD, TOORAK 3142

ARCHITECT
 SUITE 41 & 42, LEVEL 4
 61 MARLBOROUGH ST
 SURRY HILLS, NSW 2010
 T 02 9698 8510
 ABN 63 131 365 896
 NOMINATED ARCHITECT:
 KOICHI TAKADA
 NSW ARCHITECTS 6901
 VIC ARCHITECTS 16179
 QLD ARCHITECTS 5590
 KOICHI TAKADA.COM

Koichi Takada Architects


PROJECT
 190 KURRABA RD
 190 KURRABA RD, KURRABA POINT NSW
 2089

STATUS
 DEVELOPMENT APPLICATION - RFI 01

SCALE
 1:200@A1, 1:400@A3

DATE
 02.02.2024

DWG TITLE	REVISION
SITE PLAN	11
DWG NO.	DATE
A012	02.02.2024

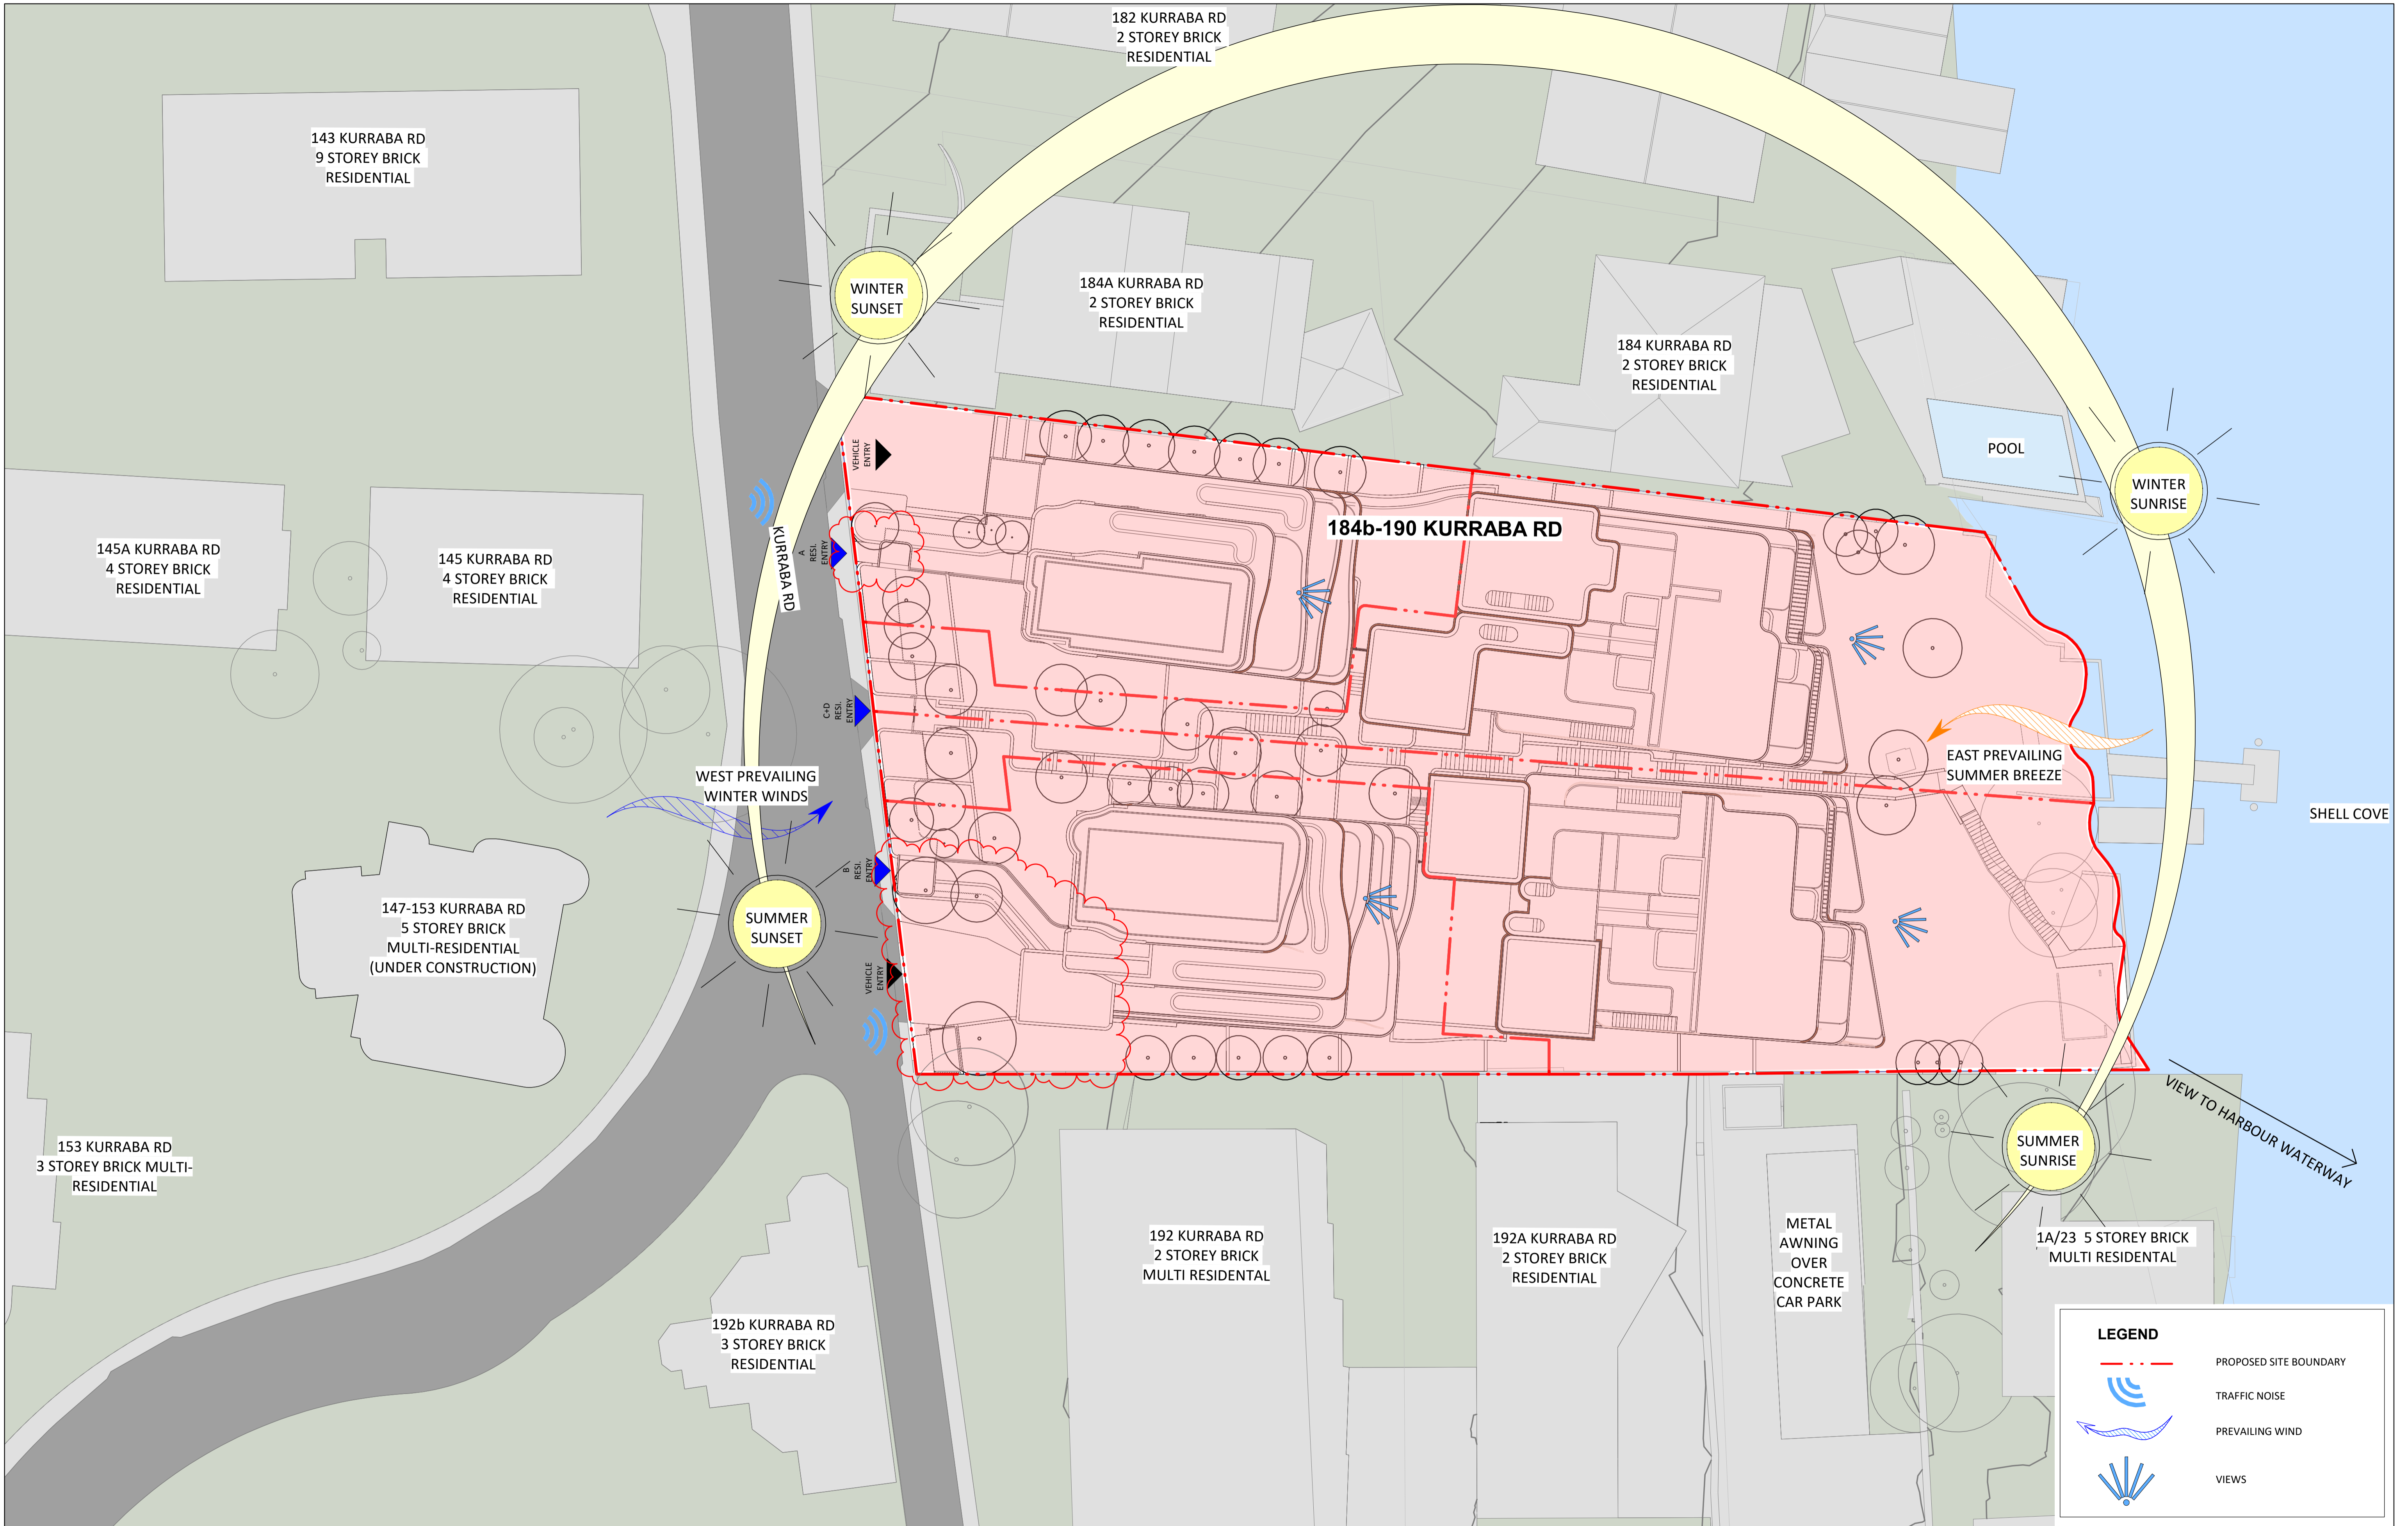

LEGEND

- PROPOSED SITE BOUNDARY
- TRAFFIC NOISE
- PREVAILING WIND
- VIEWS

NO.	REVISION	BY	CHK	DATE	REVISION NOTES:
1	FOR INFORMATION			17.12.2021	
2	COORDINATION ISSUE			09.02.2023	
3	AMENDED COORDINATION ISSUE	AL	RPW	19.05.2022	
4	DA ISSUE	RPW	JAC	08.05.2022	
5	COUNCIL RFI COORDINATION ISSUE	AL/CK	RPW	31.07.2023	
6	COUNCIL RFI ISSUE	AL/CK	RPW	15.08.2023	
7	ISSUE FOR DA RESUBMISSION	AL	RPW	02.02.2024	

KEY PLAN

CLOUD LEGEND

- REVISION
- ON HOLD

NOTES:
 KOICHI TAKADA ARCHITECTS (KTA) RETAIN ALL COMMON LAW AND STATUTORY RIGHTS INCLUDING COPYRIGHT AND INTELLECTUAL PROPERTY RIGHTS TO THIS DOCUMENT.
 THIS DOCUMENT MUST NOT BE EDITED, PARTIALLY EXTRACTED, REPRODUCED OR DISTRIBUTED IN ANY MANNER WITHOUT KTA'S EXPRESS WRITTEN CONSENT AND UNDER NO CIRCUMSTANCES SHALL THE TRANSFER OF THIS DOCUMENT BE DEEMED A SALE OR CONSTITUTE A TRANSFER OF ANY LICENCE TO USE THE DOCUMENT WITHOUT KTA'S KNOWLEDGE OR CONSENT.
 THE PDF DOCUMENT STAMPED BY KTA AS A QA CONTROLLED DOCUMENT IS THE ONLY OFFICIAL VERSION OF THIS DOCUMENT AND IS STRICTLY SUBJECT TO COPYRIGHT.
 THE CONTENT AND ACCURACY OF THE DOCUMENT IS STRICTLY LIMITED TO THAT DEPICTED IN THE QA CONTROLLED PDF. DO NOT MEASURE FROM THE ELECTRONIC OR HARD COPY VERSIONS OF THIS DOCUMENT.
 VERIFY ALL DIMENSIONS ON SITE BEFORE COMMENCING SHOP DRAWINGS, FABRICATION, CONSTRUCTION OR INSTALLATION.

CLIENT:
 Kurraba Point Road Pty Ltd
 430 TOORAK ROAD, TOORAK 3142

ARCHITECT:
 SUITE 41 & 42, LEVEL 4
 61 MARLBOROUGH ST
 SURRY HILLS, NSW 2010
 T 02 9698 8510
 ABN 63 131 365 896
 NOMINATED ARCHITECT:
 KOICHI TAKADA
 NSW ARCHITECTS 6901
 VIC ARCHITECTS 16179
 QLD ARCHITECTS 5590
 KOICHI TAKADA.COM

Koichi Takada Architects

PROJECT:
 190 KURRABA RD
 190 KURRABA RD, KURRABA POINT NSW
 2089

STATUS:
 DEVELOPMENT APPLICATION - RFI 01

GA STAMP:

THIS DOCUMENT IS NOT SUITABLE OR APPROVED FOR CONSTRUCTION AT ANY TIME UNLESS KTA HAVE NOTATED THE STATUS TITLE AS FOR CONSTRUCTION WITHOUT THE PRESENCE OF 'WIP', 'DRAFT' OR ANY OTHER FORM OF QUALIFICATION ON THE DOCUMENT.

DWG TITLE:
 SITE ANALYSIS


DWG NO.:
 A014

REVISION:
 7

SCALE:
 1:200@A1, 1:400@A3

DATE:
 02.02.2024

0 10 m

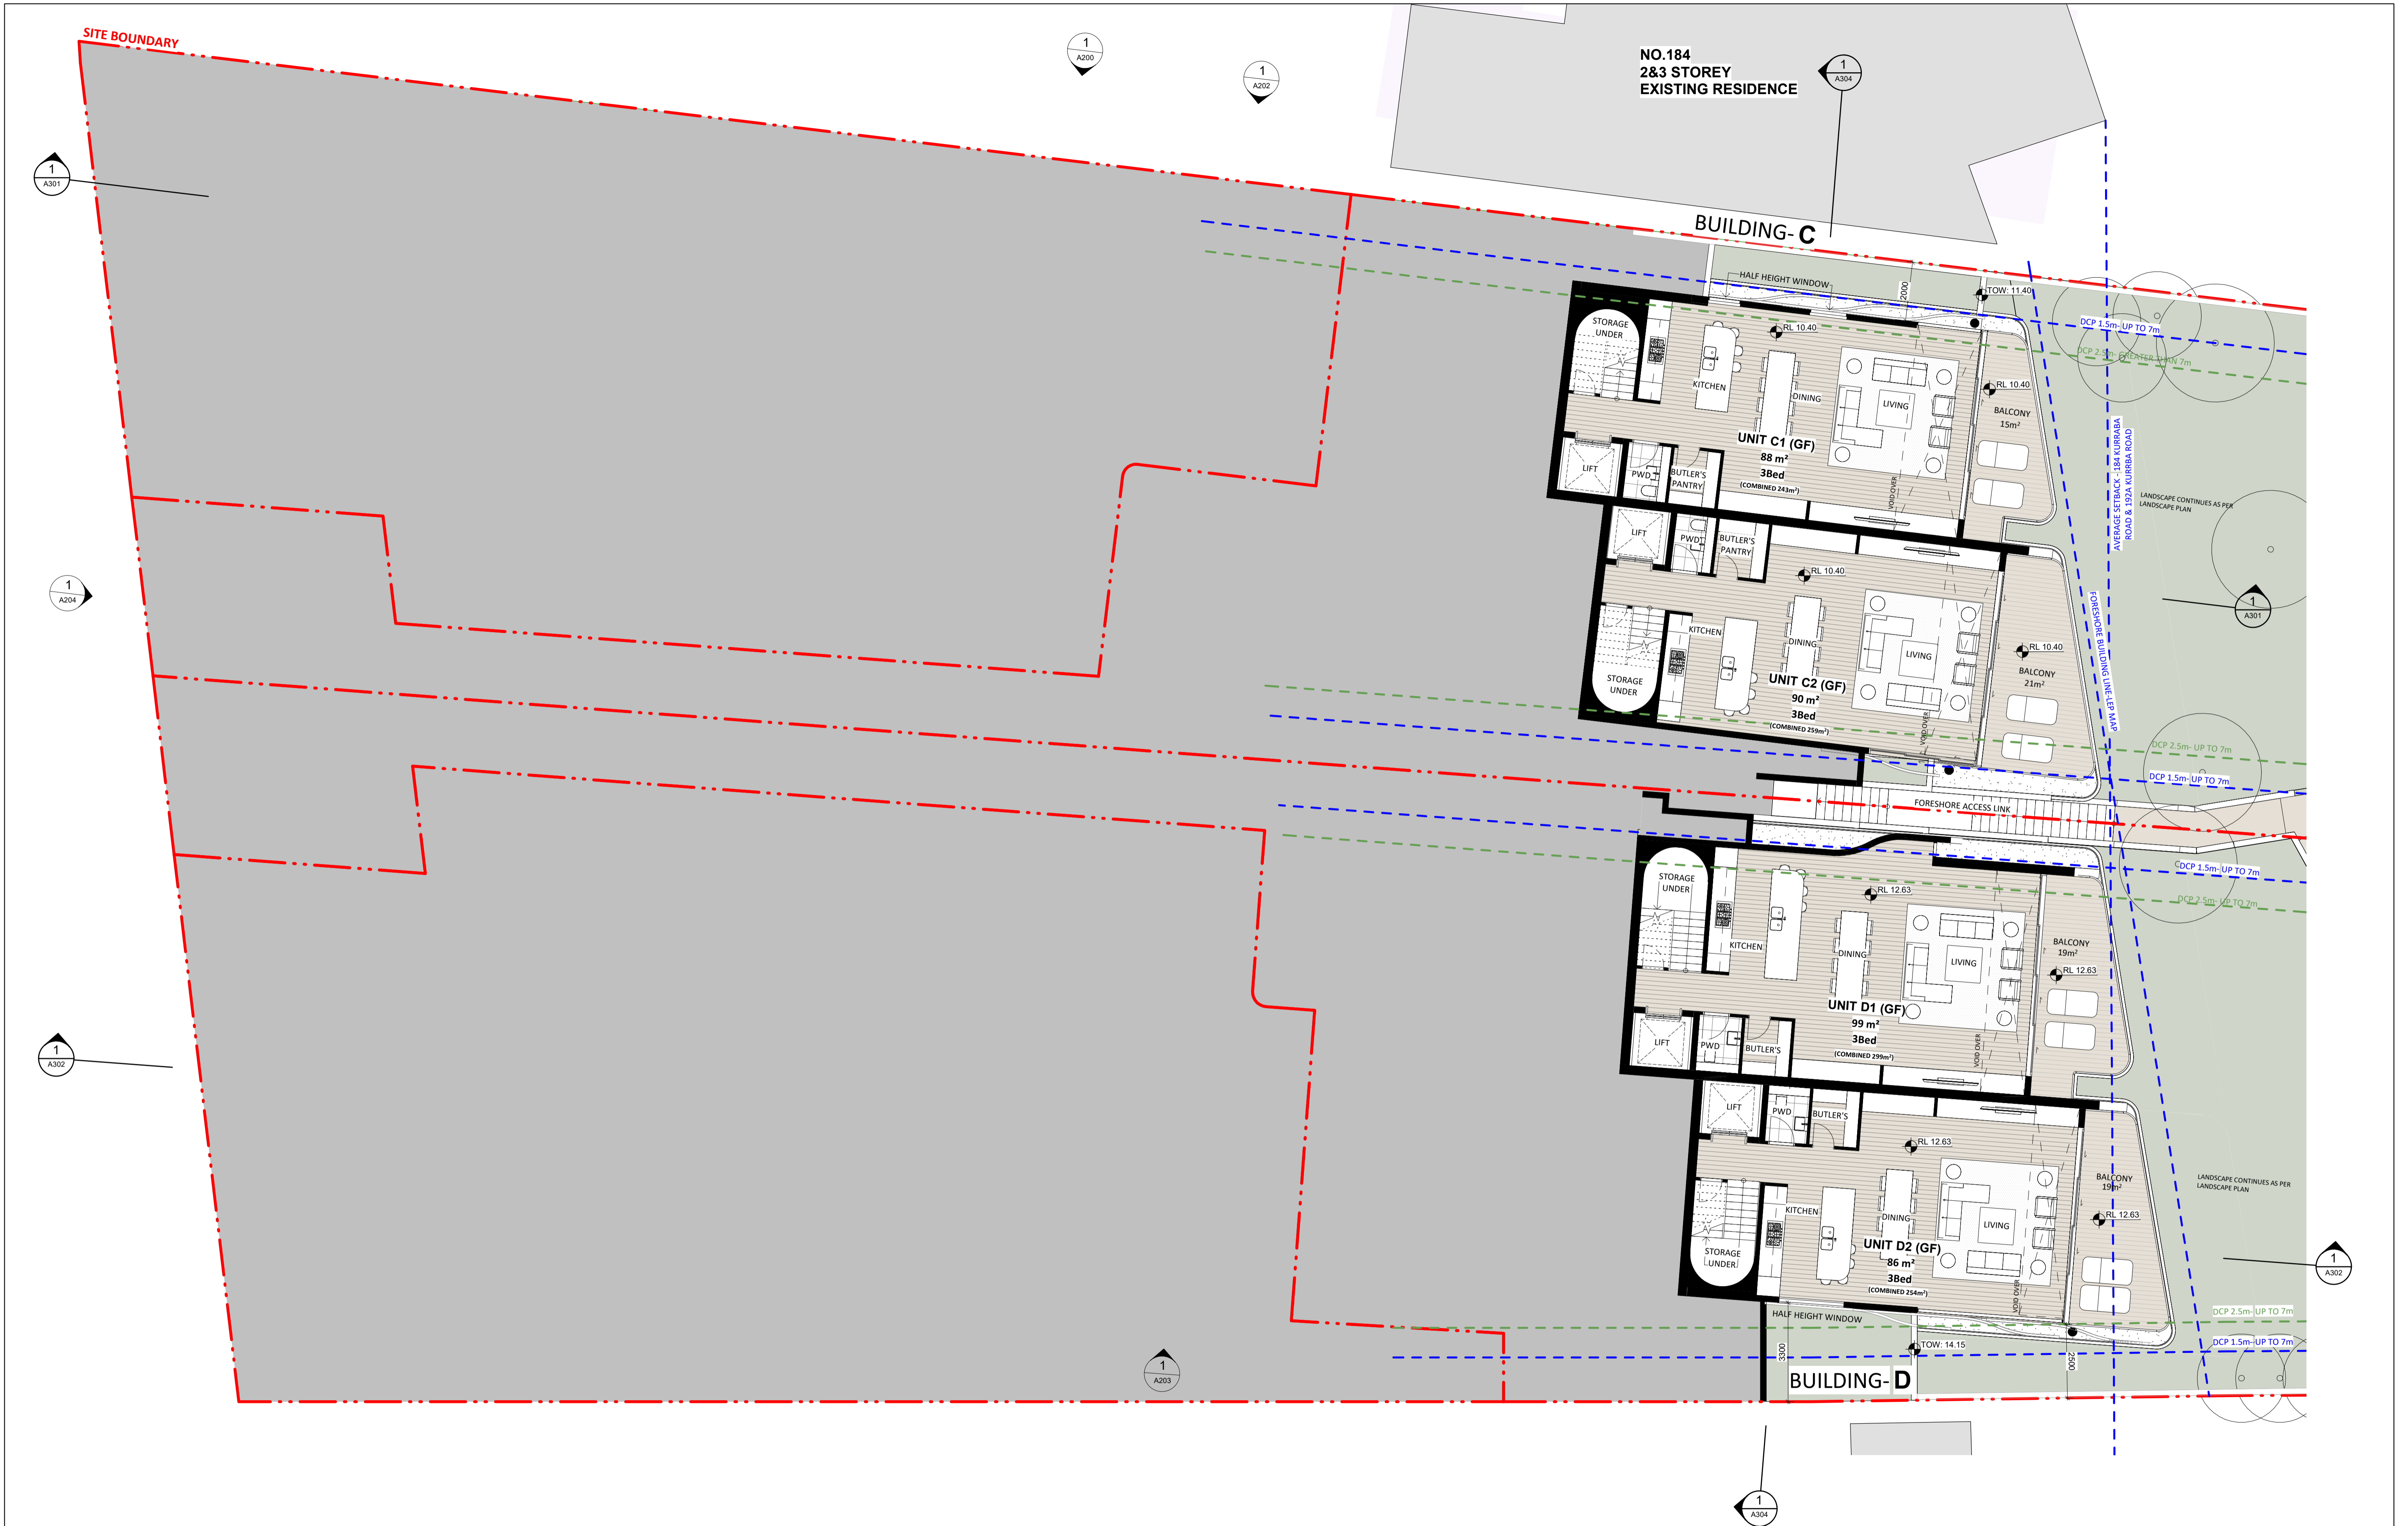

NO.	REVISION	BY	CHK	DATE	REVISION NOTES:
1	FOR INFORMATION			18.11.2021	
2	FOR INFORMATION			08.12.2021	
3	FOR INFORMATION			17.12.2021	
4	PRE-LODGE			20.02.2022	
5	COORDINATION ISSUE			09.02.2022	
6	COORDINATION ISSUE	RPW	AC	13.04.2022	
7	PRIENTATION ISSUE	AL	AC	13.05.2022	
8	AMENDED COORDINATION ISSUE	AL	RPW	19.05.2022	
9	DA ISSUE	RPW	AC	08.06.2022	
10	RFI PLAN COORDINATION ISSUE	AL	RPW	14.07.2023	
11	UPDATED DRAFT ISSUE	AL	RPW	25.07.2023	
12	COUNCIL RFI COORDINATION ISSUE	AL/DR	RPW	31.07.2023	
13	COUNCIL RFI ISSUE	AL/DR	RPW	15.08.2023	
14	ISSUE FOR DA RESUBMISSION	AL	RPW	02.02.2024	

KEY PLAN	NOTES:
<p>REVISION</p> <p>ON HOLD</p>	<p>NOTES:</p> <p>KOICHI TAKADA ARCHITECTS (KTA) RETAIN ALL COMMON LAW AND STATUTORY RIGHTS INCLUDING COPYRIGHT AND INTELLECTUAL PROPERTY RIGHTS TO THIS DOCUMENT.</p> <p>THIS DOCUMENT MUST NOT BE EDITED, PARTIALLY EXTRACTED, REPRODUCED OR DISTRIBUTED IN ANY MANNER WITHOUT KTA'S EXPRESS WRITTEN CONSENT AND UNDER NO CIRCUMSTANCES SHALL THE TRANSFER OF THIS DOCUMENT BE DEEMED A SALE OR CONSTITUTE A TRANSFER OF ANY LICENCE TO USE THE DOCUMENT.</p> <p>THE PDF DOCUMENT STAMPED BY KTA AS A 'QA CONTROLLED DOCUMENT' IS THE ONLY OFFICIAL VERSION OF THIS DOCUMENT AND IS STRICTLY SUBJECT TO COPYRIGHT ©</p> <p>THE CONTENT AND ACCURACY OF THE DOCUMENT IS STRICTLY LIMITED TO THAT DEPICTED IN THE 'QA CONTROLLED PDF'.</p> <p>DO NOT MEASURE FROM THE ELECTRONIC OR HARD COPY VERSIONS OF THIS DOCUMENT.</p> <p>VERIFY ALL DIMENSIONS ON SITE BEFORE COMMENCING SHOP DRAWINGS, FABRICATION, CONSTRUCTION OR INSTALLATION.</p>

CLIENT	ARCHITECT
<p>Kurraba Point Road Pty Ltd</p> <p>430 TOORAK ROAD, TOORAK 3142</p>	<p>SUITE 41 & 42, LEVEL 4</p> <p>61 MARLBOROUGH ST</p> <p>SURRY HILLS, NSW 2010</p> <p>T 02 9698 8510</p> <p>ASN 63 131 365 896</p> <p>NOMINATED ARCHITECT:</p> <p>KOICHI TAKADA</p> <p>NSW ARCHITECTS 6901</p> <p>VIC ARCHITECTS 16179</p> <p>QLD ARCHITECTS 5590</p> <p>KOICHI TAKADA.COM</p>


PROJECT	DWG TITLE
<p>190 KURRABA RD</p> <p>190 KURRABA RD, KURRABA POINT NSW</p> <p>2089</p> <p>STATUS</p> <p>DEVELOPMENT APPLICATION - RFI 01</p>	<p>R2 GROUND FLOOR</p> <p>DWG NO.</p> <p>A101</p> <p>REVISION</p> <p>14</p> <p>DATE</p> <p>02.02.2024</p>

Koichi Takada Architects

THIS DOCUMENT IS NOT SUITABLE OR APPROVED FOR CONSTRUCTION AT ANY TIME UNLESS KTA HAS NOTATED THE STATUS TITLE AS FOR CONSTRUCTION WITHOUT THE PRESENCE OF 'WIP', 'DRAFT' OR ANY OTHER FORM OF QUALIFICATION ON THE DOCUMENT.

SCALE	DATE
<p>1:100@A1, 1:200@A3</p>	<p>02.02.2024</p>

PROJECT	DWG TITLE
<p>190 KURRABA RD</p> <p>190 KURRABA RD, KURRABA POINT NSW</p> <p>2089</p> <p>STATUS</p> <p>DEVELOPMENT APPLICATION - RFI 01</p>	<p>R2 GROUND FLOOR</p> <p>DWG NO.</p> <p>A101</p> <p>REVISION</p> <p>14</p> <p>DATE</p> <p>02.02.2024</p>

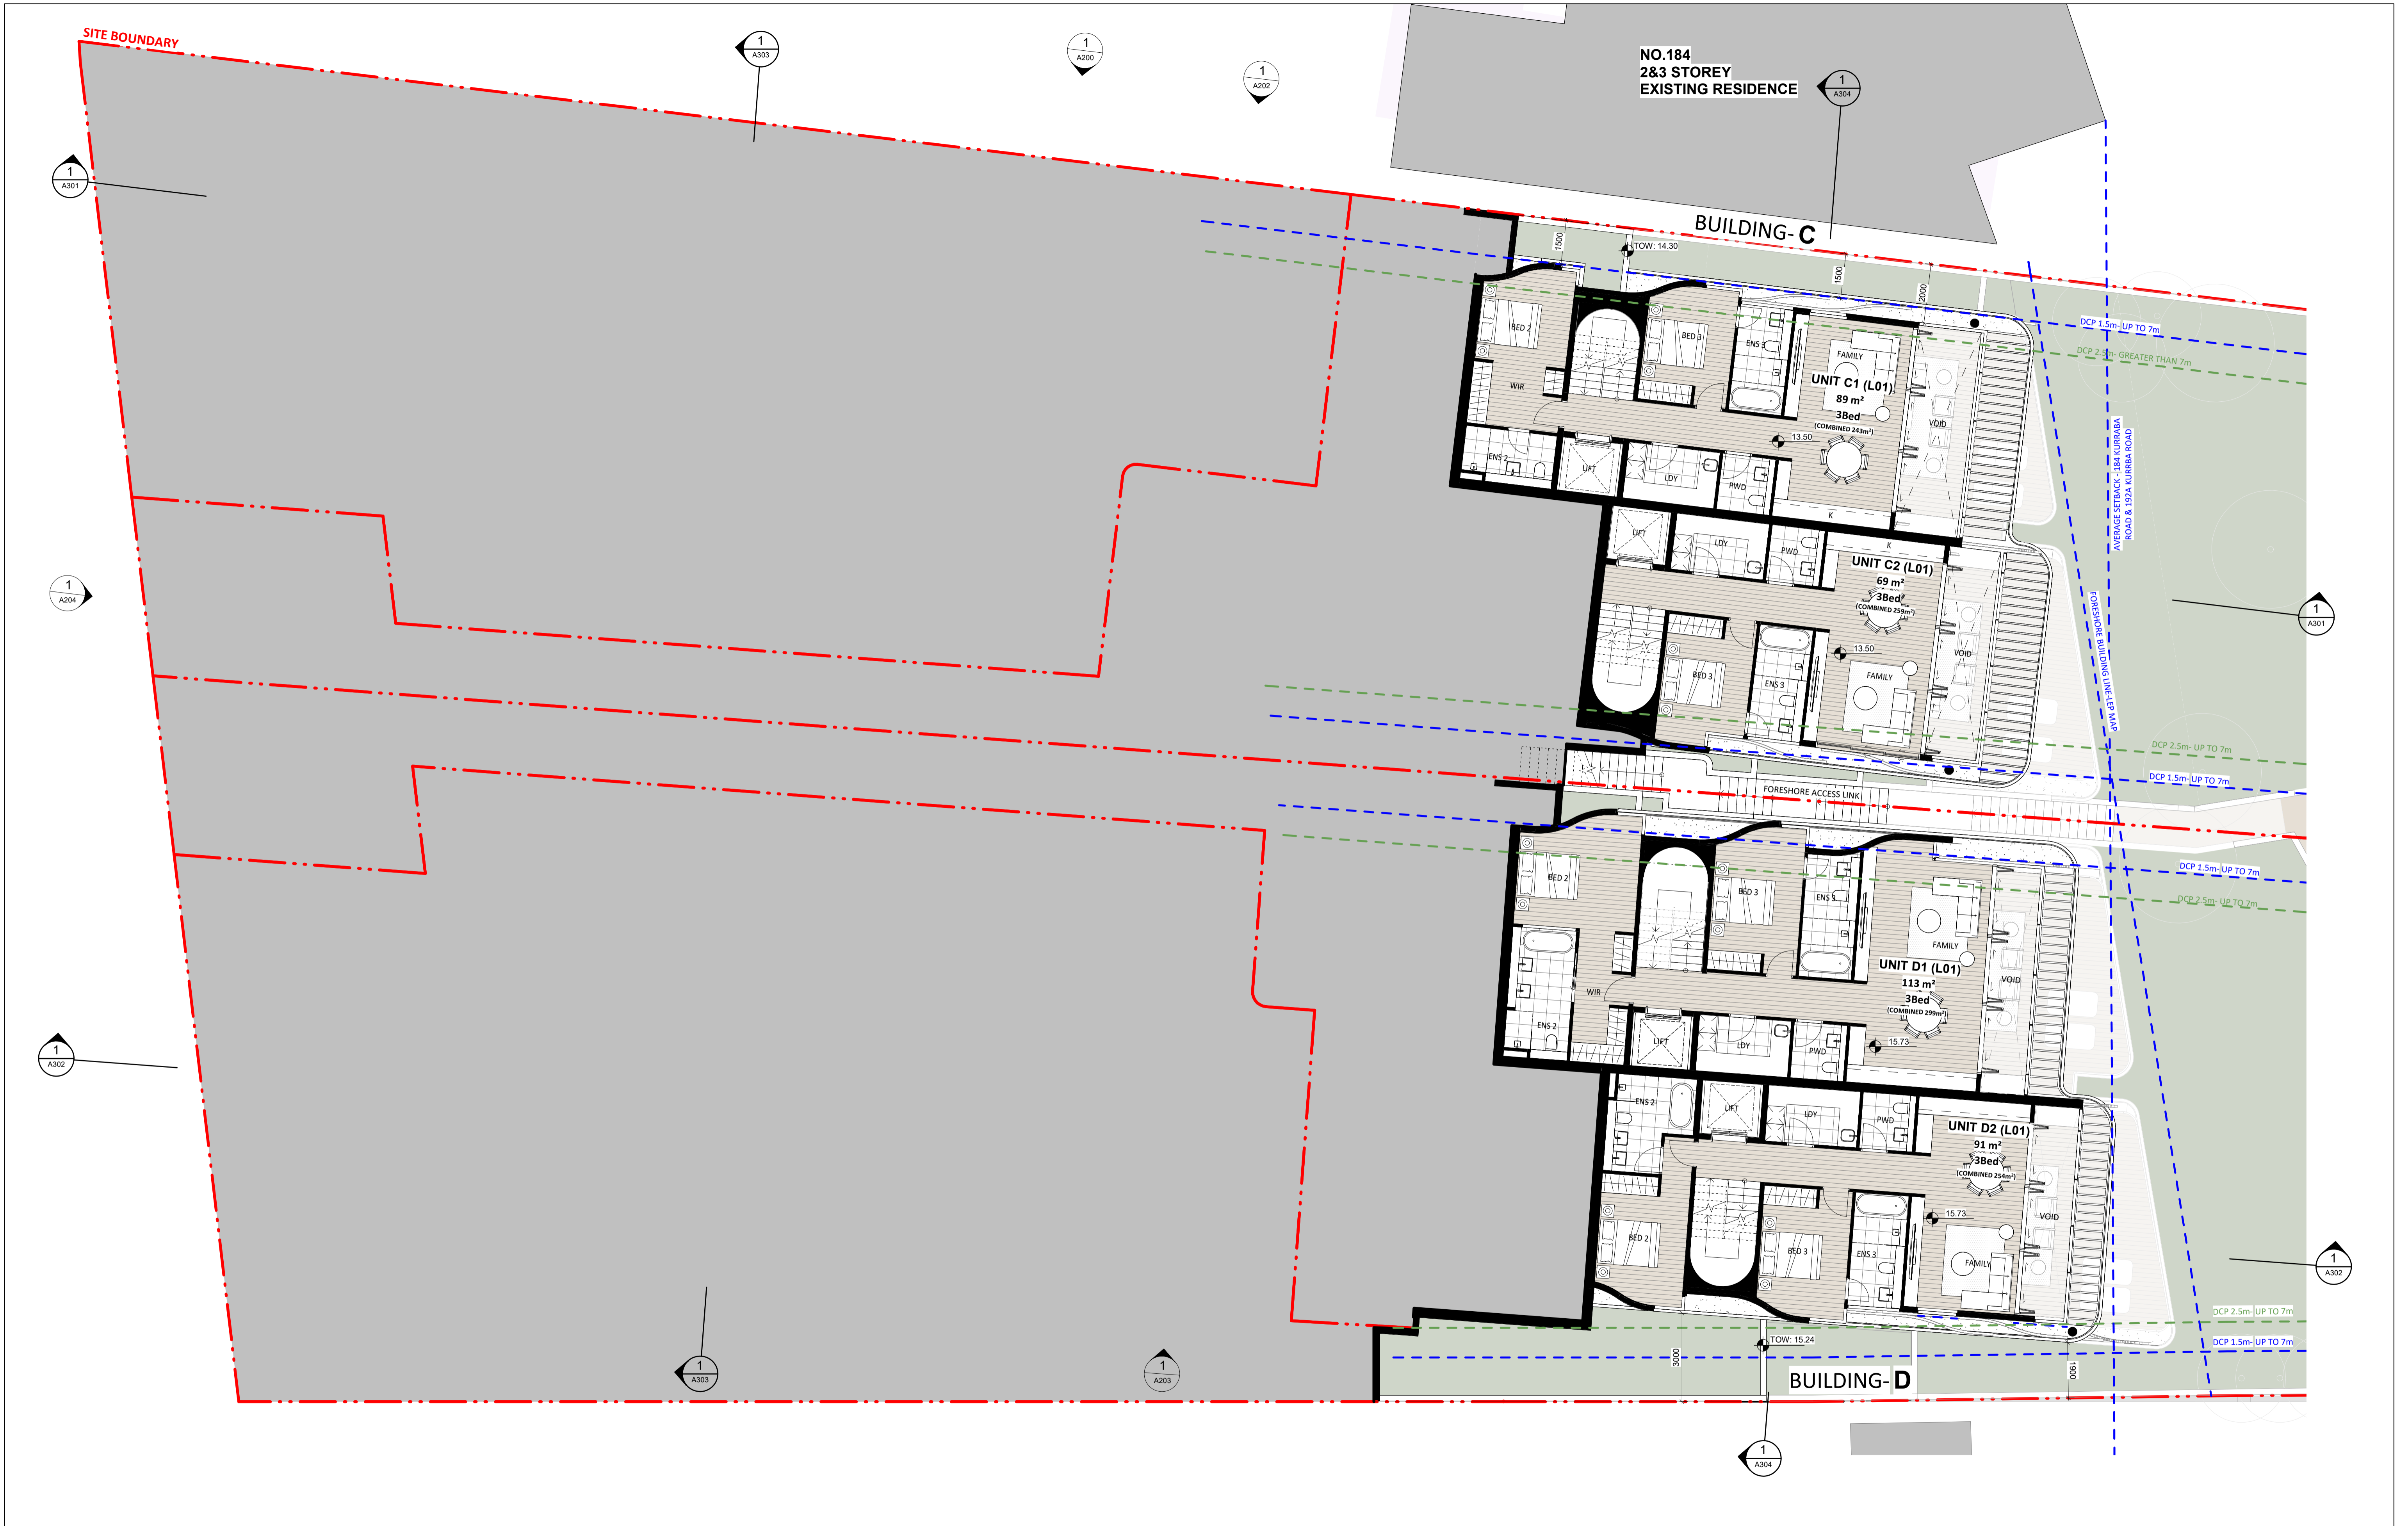

NO.	REVISION	BY	CHK	DATE	REVISION NOTES:
1	FOR INFORMATION			18.11.2021	
2	FOR INFORMATION			08.12.2021	
3	FOR INFORMATION			17.12.2021	
4	PRE-LODGE			20.02.2022	
5	COORDINATION ISSUE			09.02.2022	
6	COORDINATION ISSUE	RPW	AC	13.04.2022	
7	PRIENTATION ISSUE	AL	AC	13.05.2022	
8	AMENDED COORDINATION ISSUE	AL	RPW	19.05.2022	
9	DA ISSUE	RPW	AC	08.06.2022	
10	RFI PLAN COORDINATION ISSUE	AL	RPW	14.07.2023	
11	UPDATED DRAFT ISSUE	AL	RPW	25.07.2023	
12	COUNCIL RFI COORDINATION ISSUE	AL/DR	RPW	31.07.2023	
13	COUNCIL RFI ISSUE	AL/DR	RPW	15.08.2023	
14	ISSUE FOR DA RESUBMISSION	AL	RPW	02.02.2024	

KEY PLAN	NOTES:
SITE BOUNDARY REVISION ON HOLD	KOICHI TAKADA ARCHITECTS (KTA) RETAIN ALL COMMON LAW AND STATUTORY RIGHTS INCLUDING COPYRIGHT AND INTELLECTUAL PROPERTY RIGHTS TO THIS DOCUMENT. THIS DOCUMENT MUST NOT BE EDITED, PARTIALLY EXTRACTED, REPRODUCED OR DISTRIBUTED IN ANY MANNER WITHOUT KTA'S EXPRESS WRITTEN CONSENT AND UNDER NO CIRCUMSTANCES SHALL THE TRANSFER OF THIS DOCUMENT BE DEEMED A SALE OR CONSTITUTE A TRANSFER OF ANY LICENCE TO USE THE DOCUMENT. THE PDF DOCUMENT STAMPED BY KTA AS A QA CONTROLLED DOCUMENT IS THE ONLY OFFICIAL VERSION OF THIS DOCUMENT AND IS STRICTLY SUBJECT TO COPYRIGHT © THE CONTENT AND ACCURACY OF THE DOCUMENT IS STRICTLY LIMITED TO THAT SHOWN IN THE QA CONTROLLED PDF. DO NOT MEASURE FROM THE ELECTRONIC OR HARD COPY VERSIONS OF THIS DOCUMENT. VERIFY ALL DIMENSIONS ON SITE BEFORE COMMENCING SHOP DRAWINGS, FABRICATION, CONSTRUCTION OR INSTALLATION.

CLIENT	ARCHITECT
Kurraba Point Road Pty Ltd 430 TOORAK ROAD, TOORAK 3142	SUITE 41 & 42, LEVEL 4 61 MARLBOROUGH ST SURRY HILLS, NSW 2010 T 02 9698 8510 ABN 63 131 365 896 NOMINATED ARCHITECT: KOICHI TAKADA NSW ARCHITECTS 6901 VIC ARCHITECTS 16179 QLD ARCHITECTS 5590 KOICHI TAKADA.COM


CLIENT	ARCHITECT
Kurraba Point Road Pty Ltd 430 TOORAK ROAD, TOORAK 3142	SUITE 41 & 42, LEVEL 4 61 MARLBOROUGH ST SURRY HILLS, NSW 2010 T 02 9698 8510 ABN 63 131 365 896 NOMINATED ARCHITECT: KOICHI TAKADA NSW ARCHITECTS 6901 VIC ARCHITECTS 16179 QLD ARCHITECTS 5590 KOICHI TAKADA.COM

Koichi Takada Architects

PROJECT	STATUS
190 KURRABA RD 190 KURRABA RD, KURRABA POINT NSW 2089	DEVELOPMENT APPLICATION - RFI 01

DWG TITLE	DWG NO.	REVISION
R2 LEVEL 1	A102	14

SCALE	DATE
1:100@A1, 1:200@A3	02.02.2024

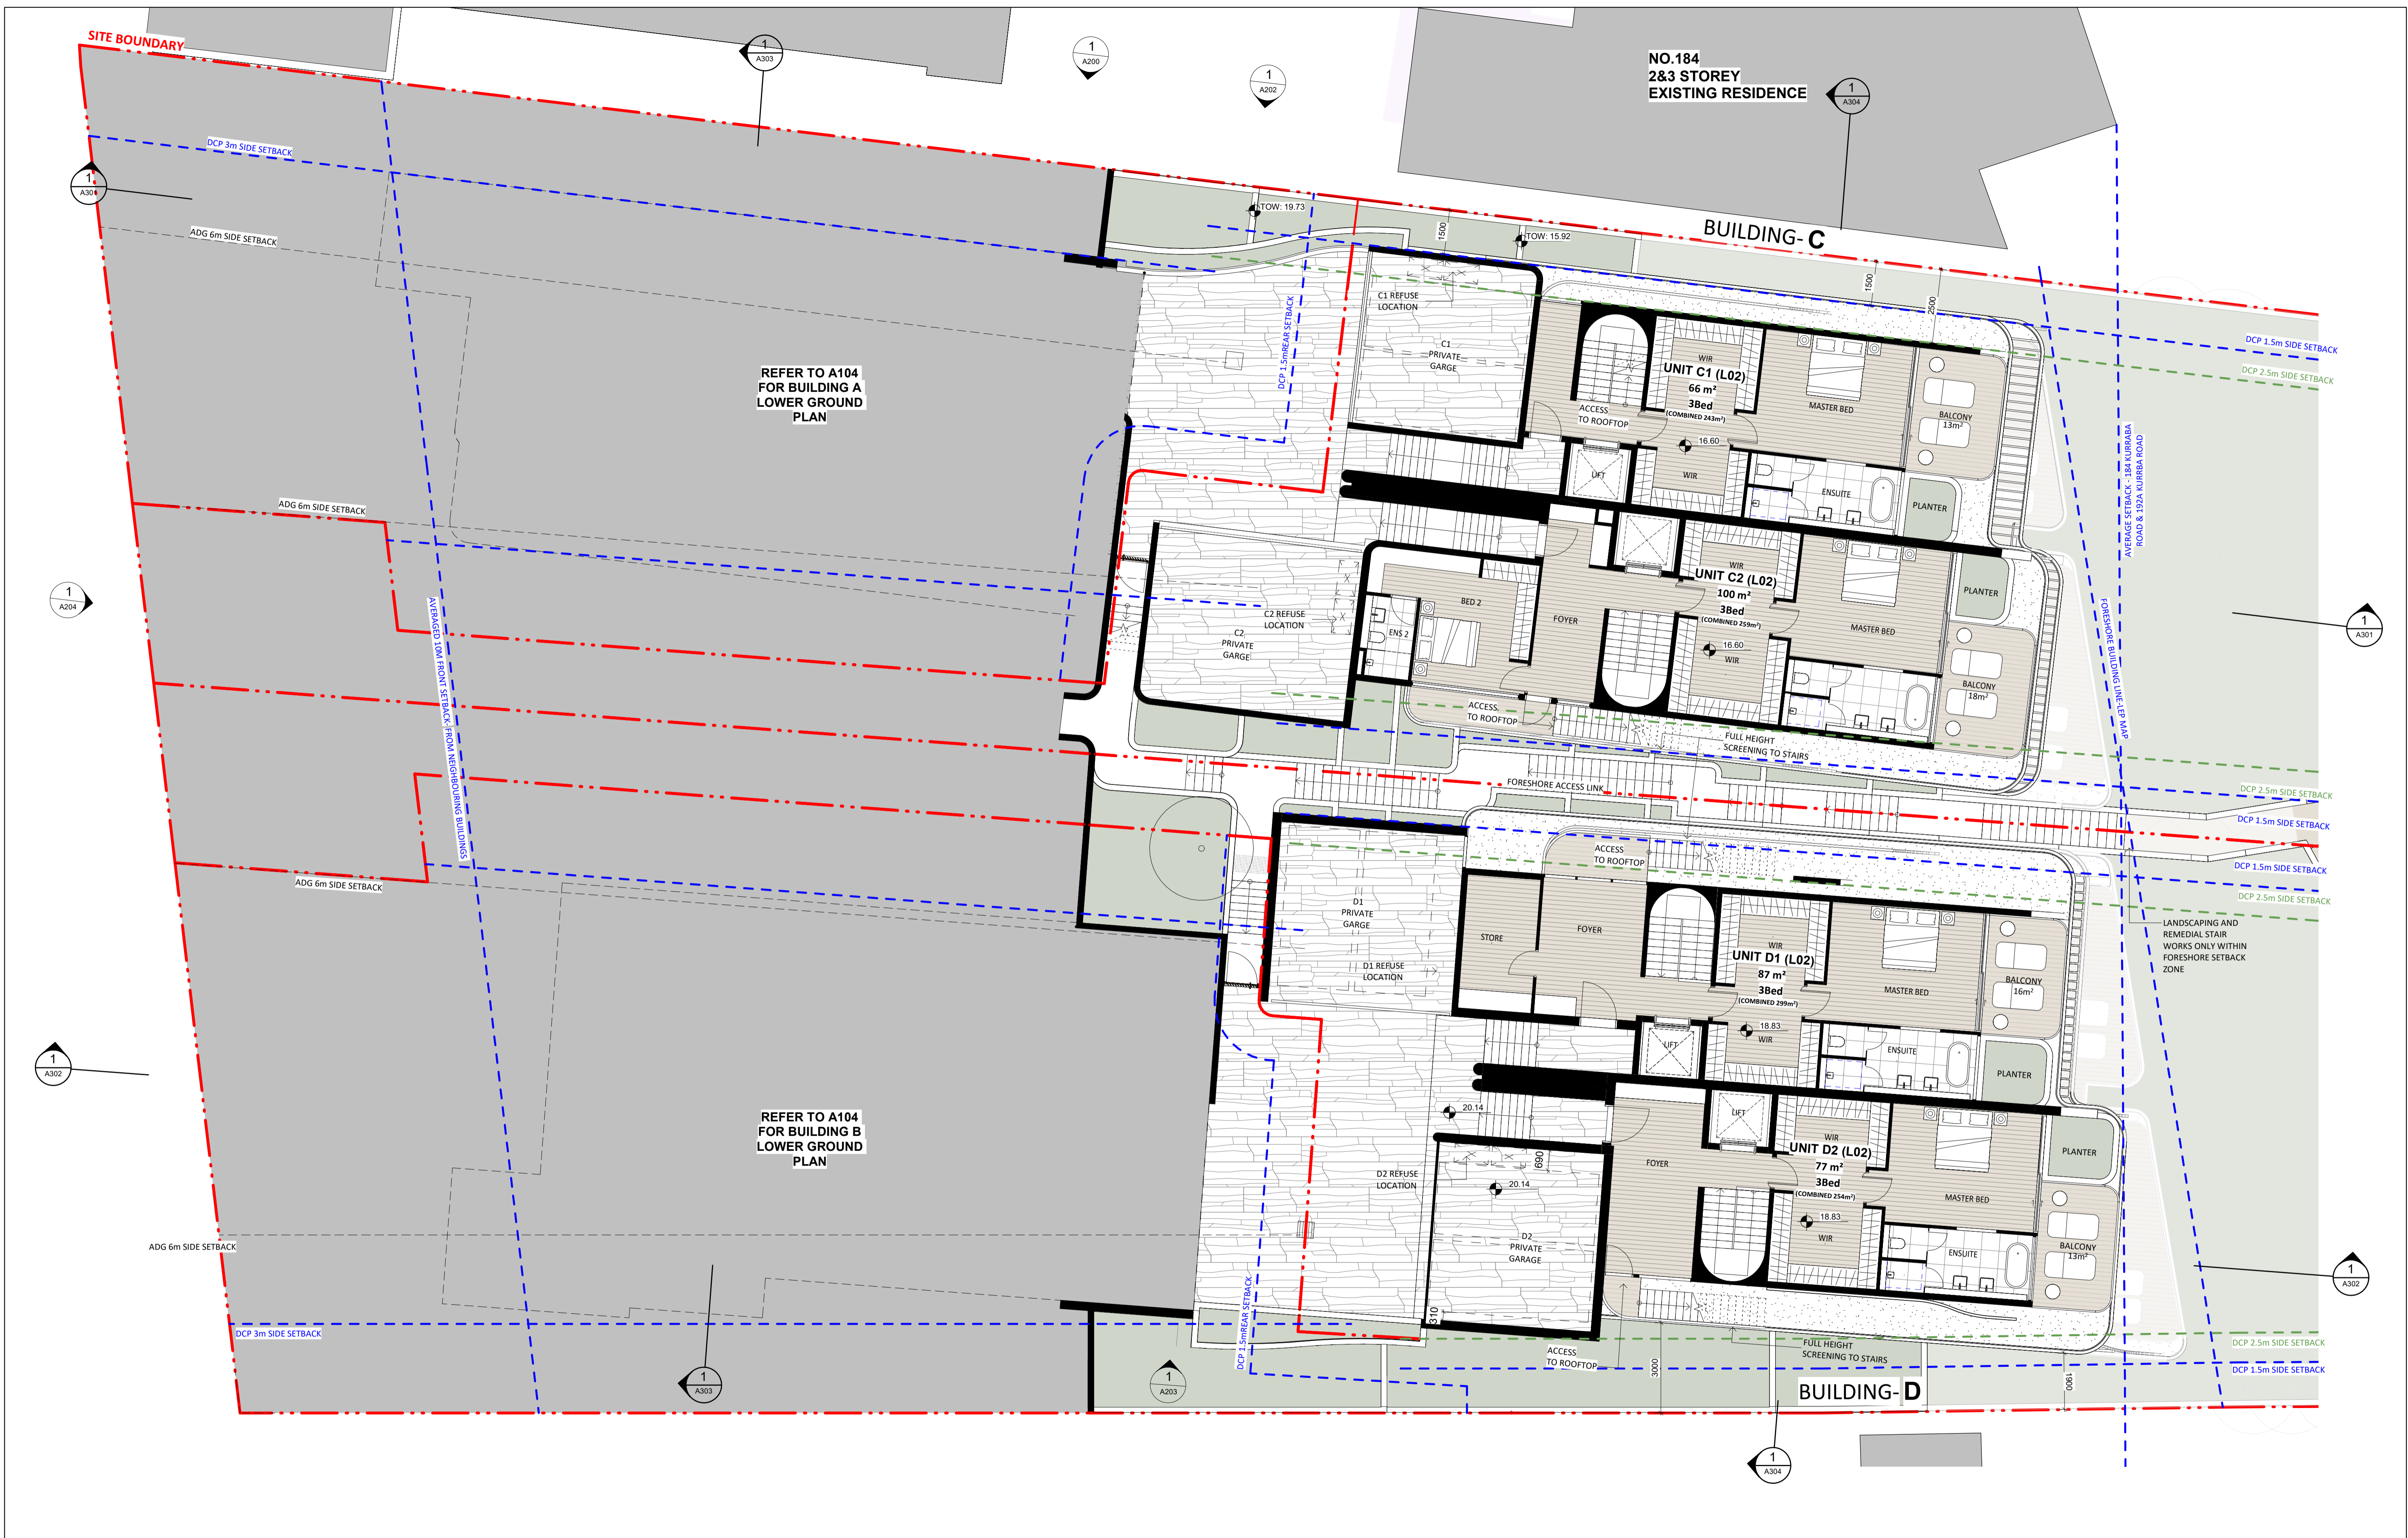

NO.	REVISION	BY	CHK	DATE	REVISION NOTES
1	FOR INFORMATION			18.11.2021	
2	FOR INFORMATION			08.12.2021	
3	FOR INFORMATION			17.12.2021	
4	PRE-LODGE			20.02.2022	
5	COORDINATION ISSUE			09.02.2022	
6	COORDINATION ISSUE	RPW	AC	13.04.2022	
7	PRESENTATION ISSUE	AL	AC	13.05.2022	
8	AMENDED COORDINATION ISSUE	AL	RPW	19.05.2022	
9	DA ISSUE	RPW	AC	08.06.2022	
10	RFI PLAN COORDINATION ISSUE	AL	RPW	14.07.2023	
11	UPDATED DRAFT ISSUE	AL	RPW	25.07.2023	
12	COUNCIL RFI COORDINATION ISSUE	AL/CR	RPW	31.07.2023	
13	COUNCIL RFI ISSUE	AL/CR	RPW	15.08.2023	
14	ISSUE FOR DA RESUBMISSION	AL	RPW	02.02.2024	

KEY PLAN	REVISION	ON HOLD
	REVISION	
	ON HOLD	

NOTES:
 KOICHI TAKADA ARCHITECTS (KTA) RETAIN ALL COMMON LAW AND STATUTORY RIGHTS INCLUDING COPYRIGHT AND INTELLECTUAL PROPERTY RIGHTS TO THIS DOCUMENT.
 THIS DOCUMENT MUST NOT BE EDITED, PARTIALLY EXTRACTED, REPRODUCED OR DISTRIBUTED IN ANY MANNER WITHOUT KTA'S EXPRESS WRITTEN CONSENT AND UNDER NO CIRCUMSTANCES SHALL THE TRANSFER OF THIS DOCUMENT BE DEEMED A SALE OR CONSTITUTE A TRANSFER OF ANY LICENCE TO USE THE DOCUMENT WITHOUT KTA'S KNOWLEDGE OR CONSENT.
 THE PDF DOCUMENT STAMPED BY KTA AS A QA CONTROLLED DOCUMENT IS THE ONLY OFFICIAL VERSION OF THIS DOCUMENT AND IS STRICTLY SUBJECT TO COPYRIGHT ©.
 THE CONTENT AND ACCURACY OF THE DOCUMENT IS STRICTLY LIMITED TO THAT DEPICTED IN THE QA CONTROLLED PDF. DO NOT MEASURE FROM THE ELECTRONIC OR HARD COPY VERSIONS OF THIS DOCUMENT.
 VERIFY ALL DIMENSIONS ON SITE BEFORE COMMENCING SHOP DRAWINGS, FABRICATION, CONSTRUCTION OR INSTALLATION.

CLIENT
 Kurraba Point Road Pty Ltd
 430 TOORAK ROAD, TOORAK 3142

ARCHITECT
 SUITE 41 & 42, LEVEL 4
 61 MARLBOROUGH ST
 SURRY HILLS, NSW 2010
 T 02 9698 8510
 ASN 63 131 365 896
 NOMINATED ARCHITECT:
 KOICHI TAKADA
 NSW ARCHITECTS 6901
 VIC ARCHITECTS 16179
 QLD ARCHITECTS 5590
 KOICHI TAKADA.COM

Koichi Takada Architects

PROJECT
 190 KURRABA RD
 190 KURRABA RD, KURRABA POINT NSW
 2089

STATUS
 DEVELOPMENT APPLICATION - RFI 01

SCALE
 1:100@A1, 1:200@A3


DWG TITLE
 R2 LEVEL 2

DWG NO.
 A103

REVISION
 14

DATE
 02.02.2024

THIS DOCUMENT IS NOT SUITABLE OR APPROVED FOR CONSTRUCTION AT ANY TIME UNLESS KTA HAS NOTATED THE STATUS TITLE AS FOR CONSTRUCTION WITHOUT THE PRESENCE OF WIP, DRAFT OR ANY OTHER FORM OF QUALIFICATION ON THE DOCUMENT.

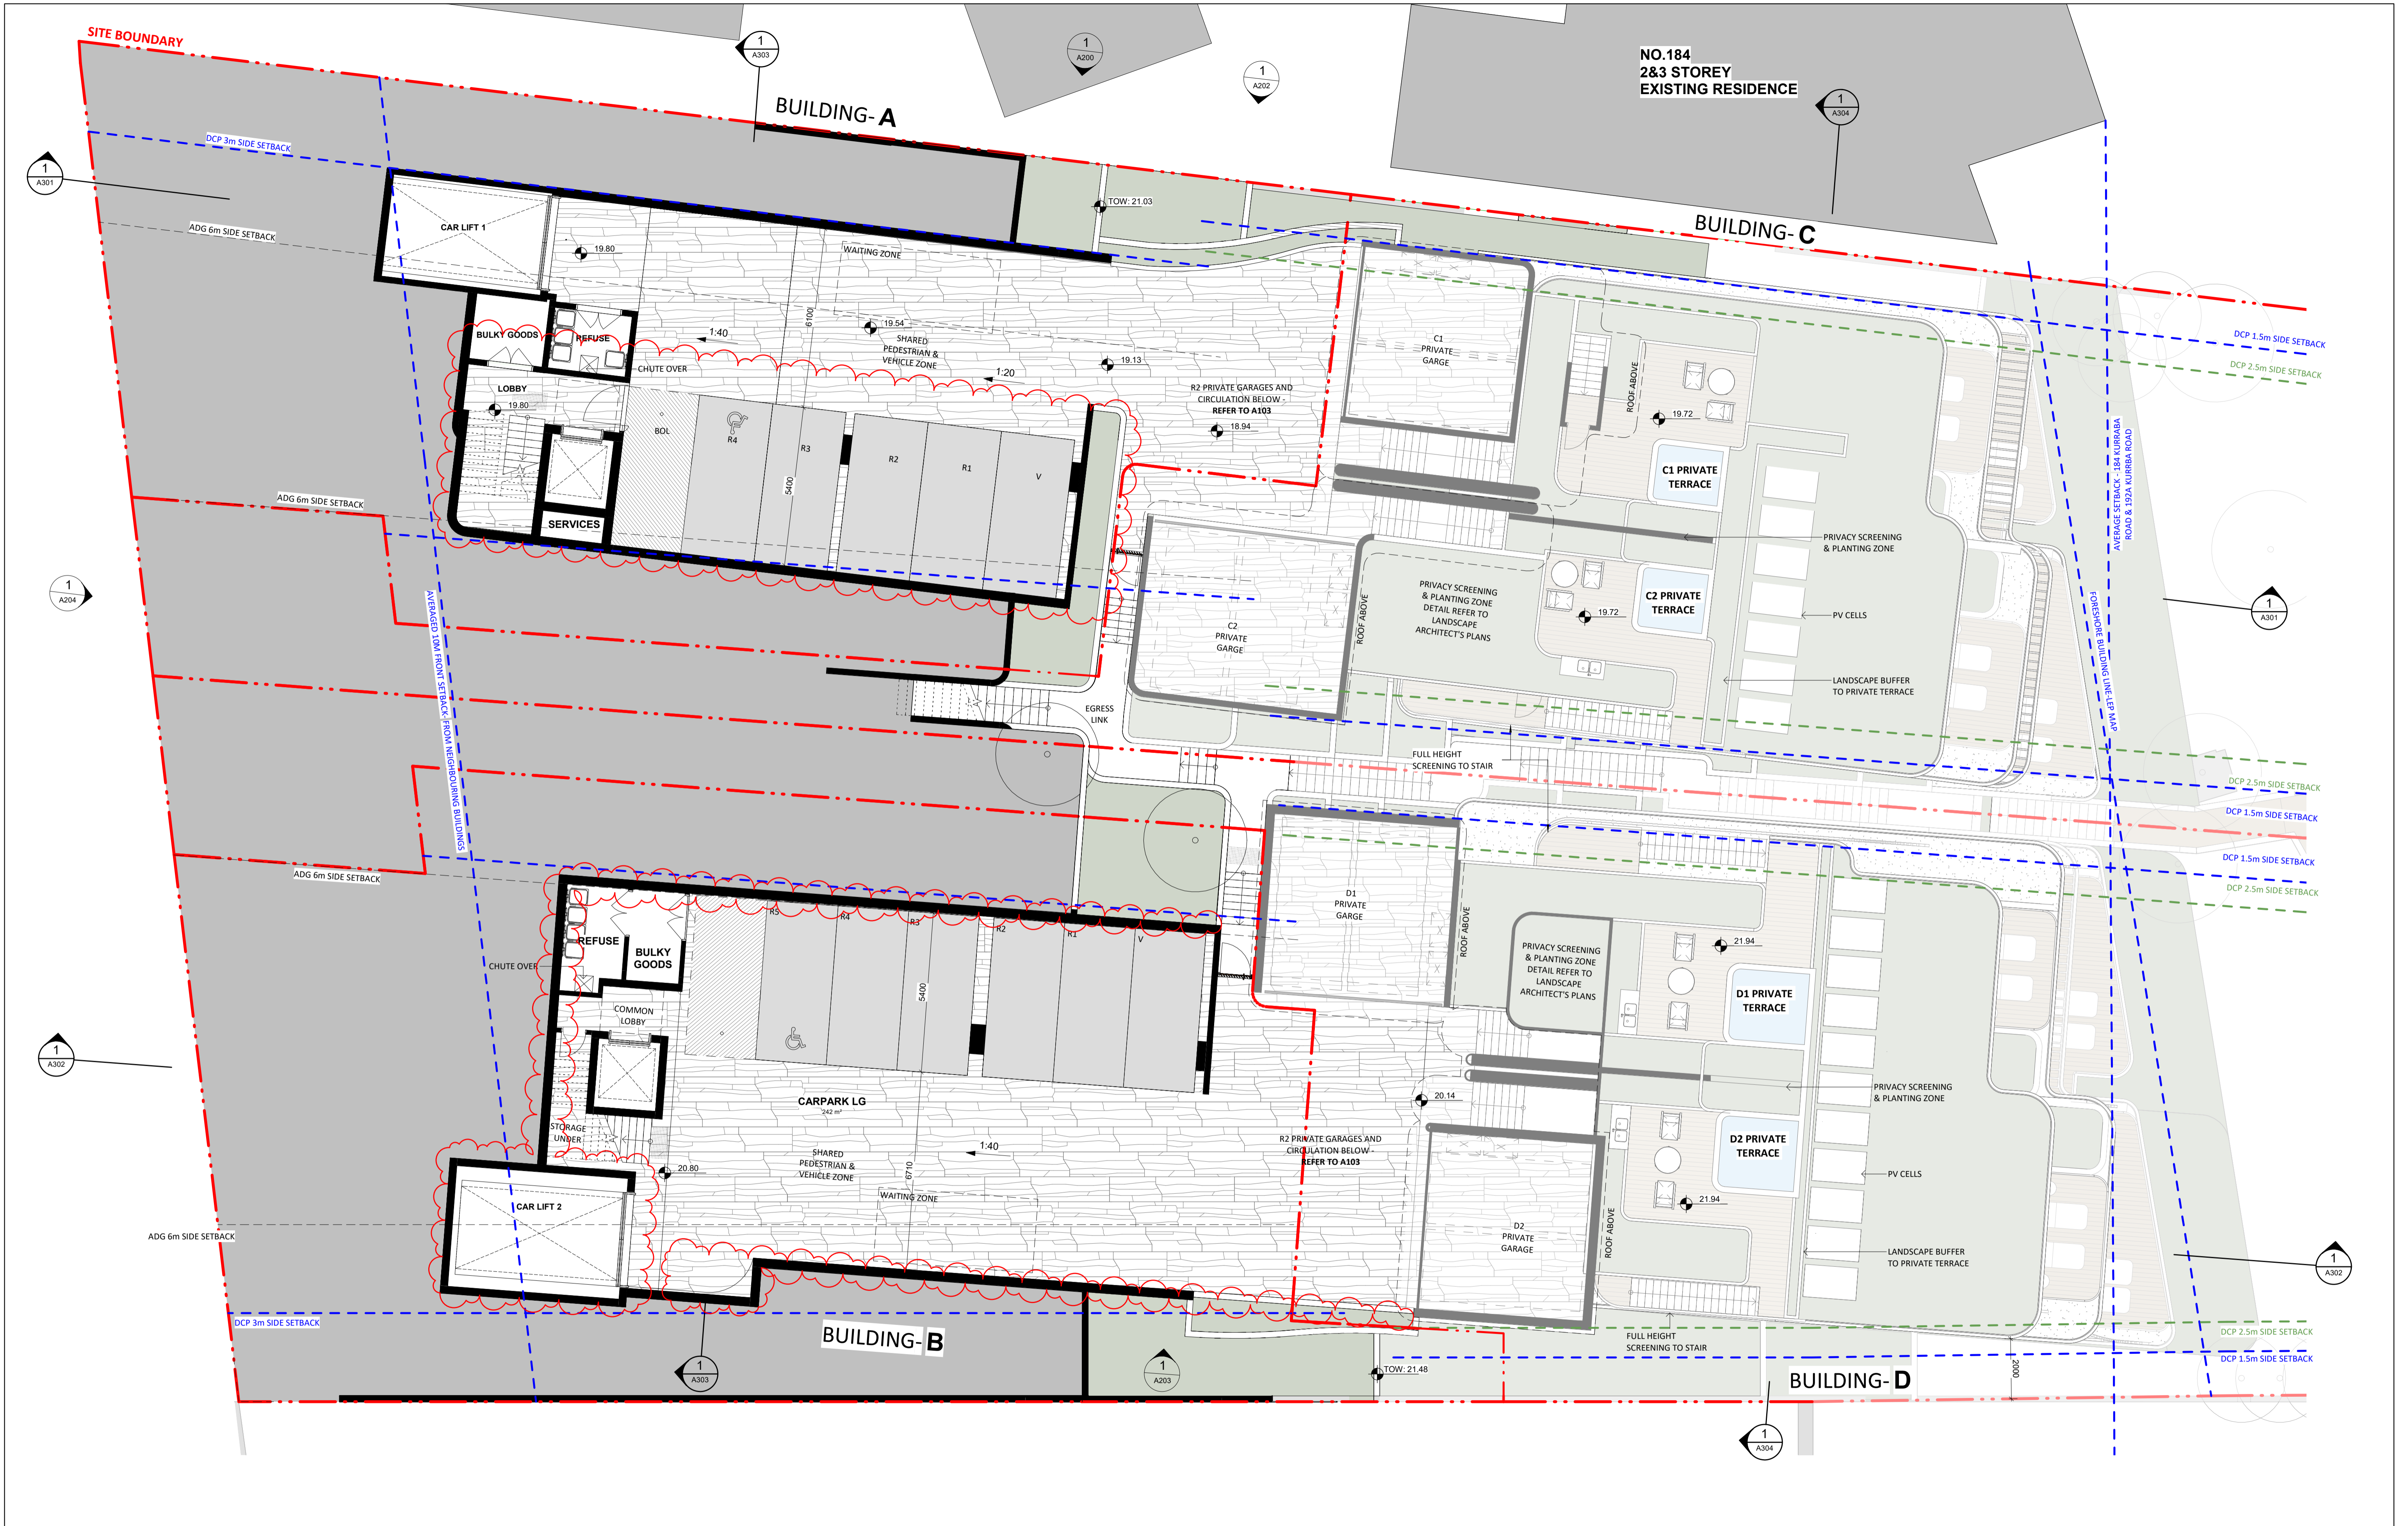

NO.	REVISION	BY	CHK	DATE	REVISION NOTES:
1	FOR INFORMATION			18.11.2021	
2	FOR INFORMATION			08.12.2021	
3	FOR INFORMATION			17.12.2021	
4	PRE-LODGE			20.01.2022	
5	COORDINATION ISSUE			09.02.2022	
6	COORDINATION ISSUE	RPW	AC	13.04.2022	
7	PRIENTATION ISSUE	AL	AC	13.05.2022	
8	AMENDED COORDINATION ISSUE	AL	RPW	19.05.2022	
9	DA ISSUE	RPW	AC	08.06.2022	
10	RFI PLAN COORDINATION ISSUE	AL	RPW	14.07.2023	
11	RFI TRAFFIC COORDINATION	AL	RPW	24.07.2023	
12	UPDATED DRAFT ISSUE	AL	RPW	25.07.2023	
13	COUNCIL RFI COORDINATION ISSUE	AL/CK	RPW	31.07.2023	
14	COUNCIL RFI ISSUE	AL/CK	RPW	15.08.2023	
15	ISSUE FOR DA RESUBMISSION	AL	RPW	02.02.2024	

KEY PLAN	NOTES
REVISION	NOTES: KOICHI TAKADA ARCHITECTS (KTA) RETAIN ALL COMMON LAW AND STATUTORY RIGHTS INCLUDING COPYRIGHT AND INTELLECTUAL PROPERTY RIGHTS TO THIS DOCUMENT. THIS DOCUMENT MUST NOT BE EDITED, PARTIALLY EXTRACTED, REPRODUCED OR DISTRIBUTED IN ANY MANNER WITHOUT KTA'S EXPRESS WRITTEN CONSENT AND UNDER NO CIRCUMSTANCES SHALL THE TRANSFER OF THIS DOCUMENT BE DEEMED A SALE OR CONSTITUTE A TRANSFER OF ANY LICENCE TO USE THE DOCUMENT. THE PDF DOCUMENT STAMPED BY KTA AS A QA CONTROLLED DOCUMENT IS THE ONLY OFFICIAL VERSION OF THIS DOCUMENT AND IS STRICTLY SUBJECT TO COPYRIGHT. THE CONTENT AND ACCURACY OF THE DOCUMENT IS STRICTLY LIMITED TO THAT SHOWN IN THE QA CONTROLLED PDF. DO NOT MEASURE FROM THE ELECTRONIC OR HARD COPY VERSIONS OF THIS DOCUMENT. VERIFY ALL DIMENSIONS ON SITE BEFORE COMMENCING SHOP DRAWINGS, FABRICATION, CONSTRUCTION OR INSTALLATION.
ON HOLD	OTHERS:

CLIENT	ARCHITECT
Kurraba Point Road Pty Ltd 430 TOORAK ROAD, TOORAK 3142	SUITE 41 & 42, LEVEL 4 61 MARLBOROUGH ST SURRY HILLS, NSW 2010 T 02 9698 8510 ASN 63 131 365 896 NOMINATED ARCHITECT: KOICHI TAKADA NSW ARCHITECTS 6901 VIC ARCHITECTS 16179 QLD ARCHITECTS 5590 KOICHI TAKADA.COM

Koichi Takada Architects

THIS DOCUMENT IS NOT SUITABLE OR APPROVED FOR CONSTRUCTION AT ANY TIME UNLESS KTA HAS NOTATED THE STATUS TITLE AS FOR CONSTRUCTION WITHOUT THE PRESENCE OF WIP, DRAFT OR ANY OTHER FORM OF QUALIFICATION ON THE DOCUMENT.

PROJECT	DWG TITLE
190 KURRABA RD 190 KURRABA RD, KURRABA POINT NSW 2089	R4 LOWER GROUND
STATUS DEVELOPMENT APPLICATION - RFI 01	DWG NO. A104
SCALE 1:100@A1, 1:200@A3	REVISION 15
DATE 02.02.2024	


GA STAMP
0 5 m





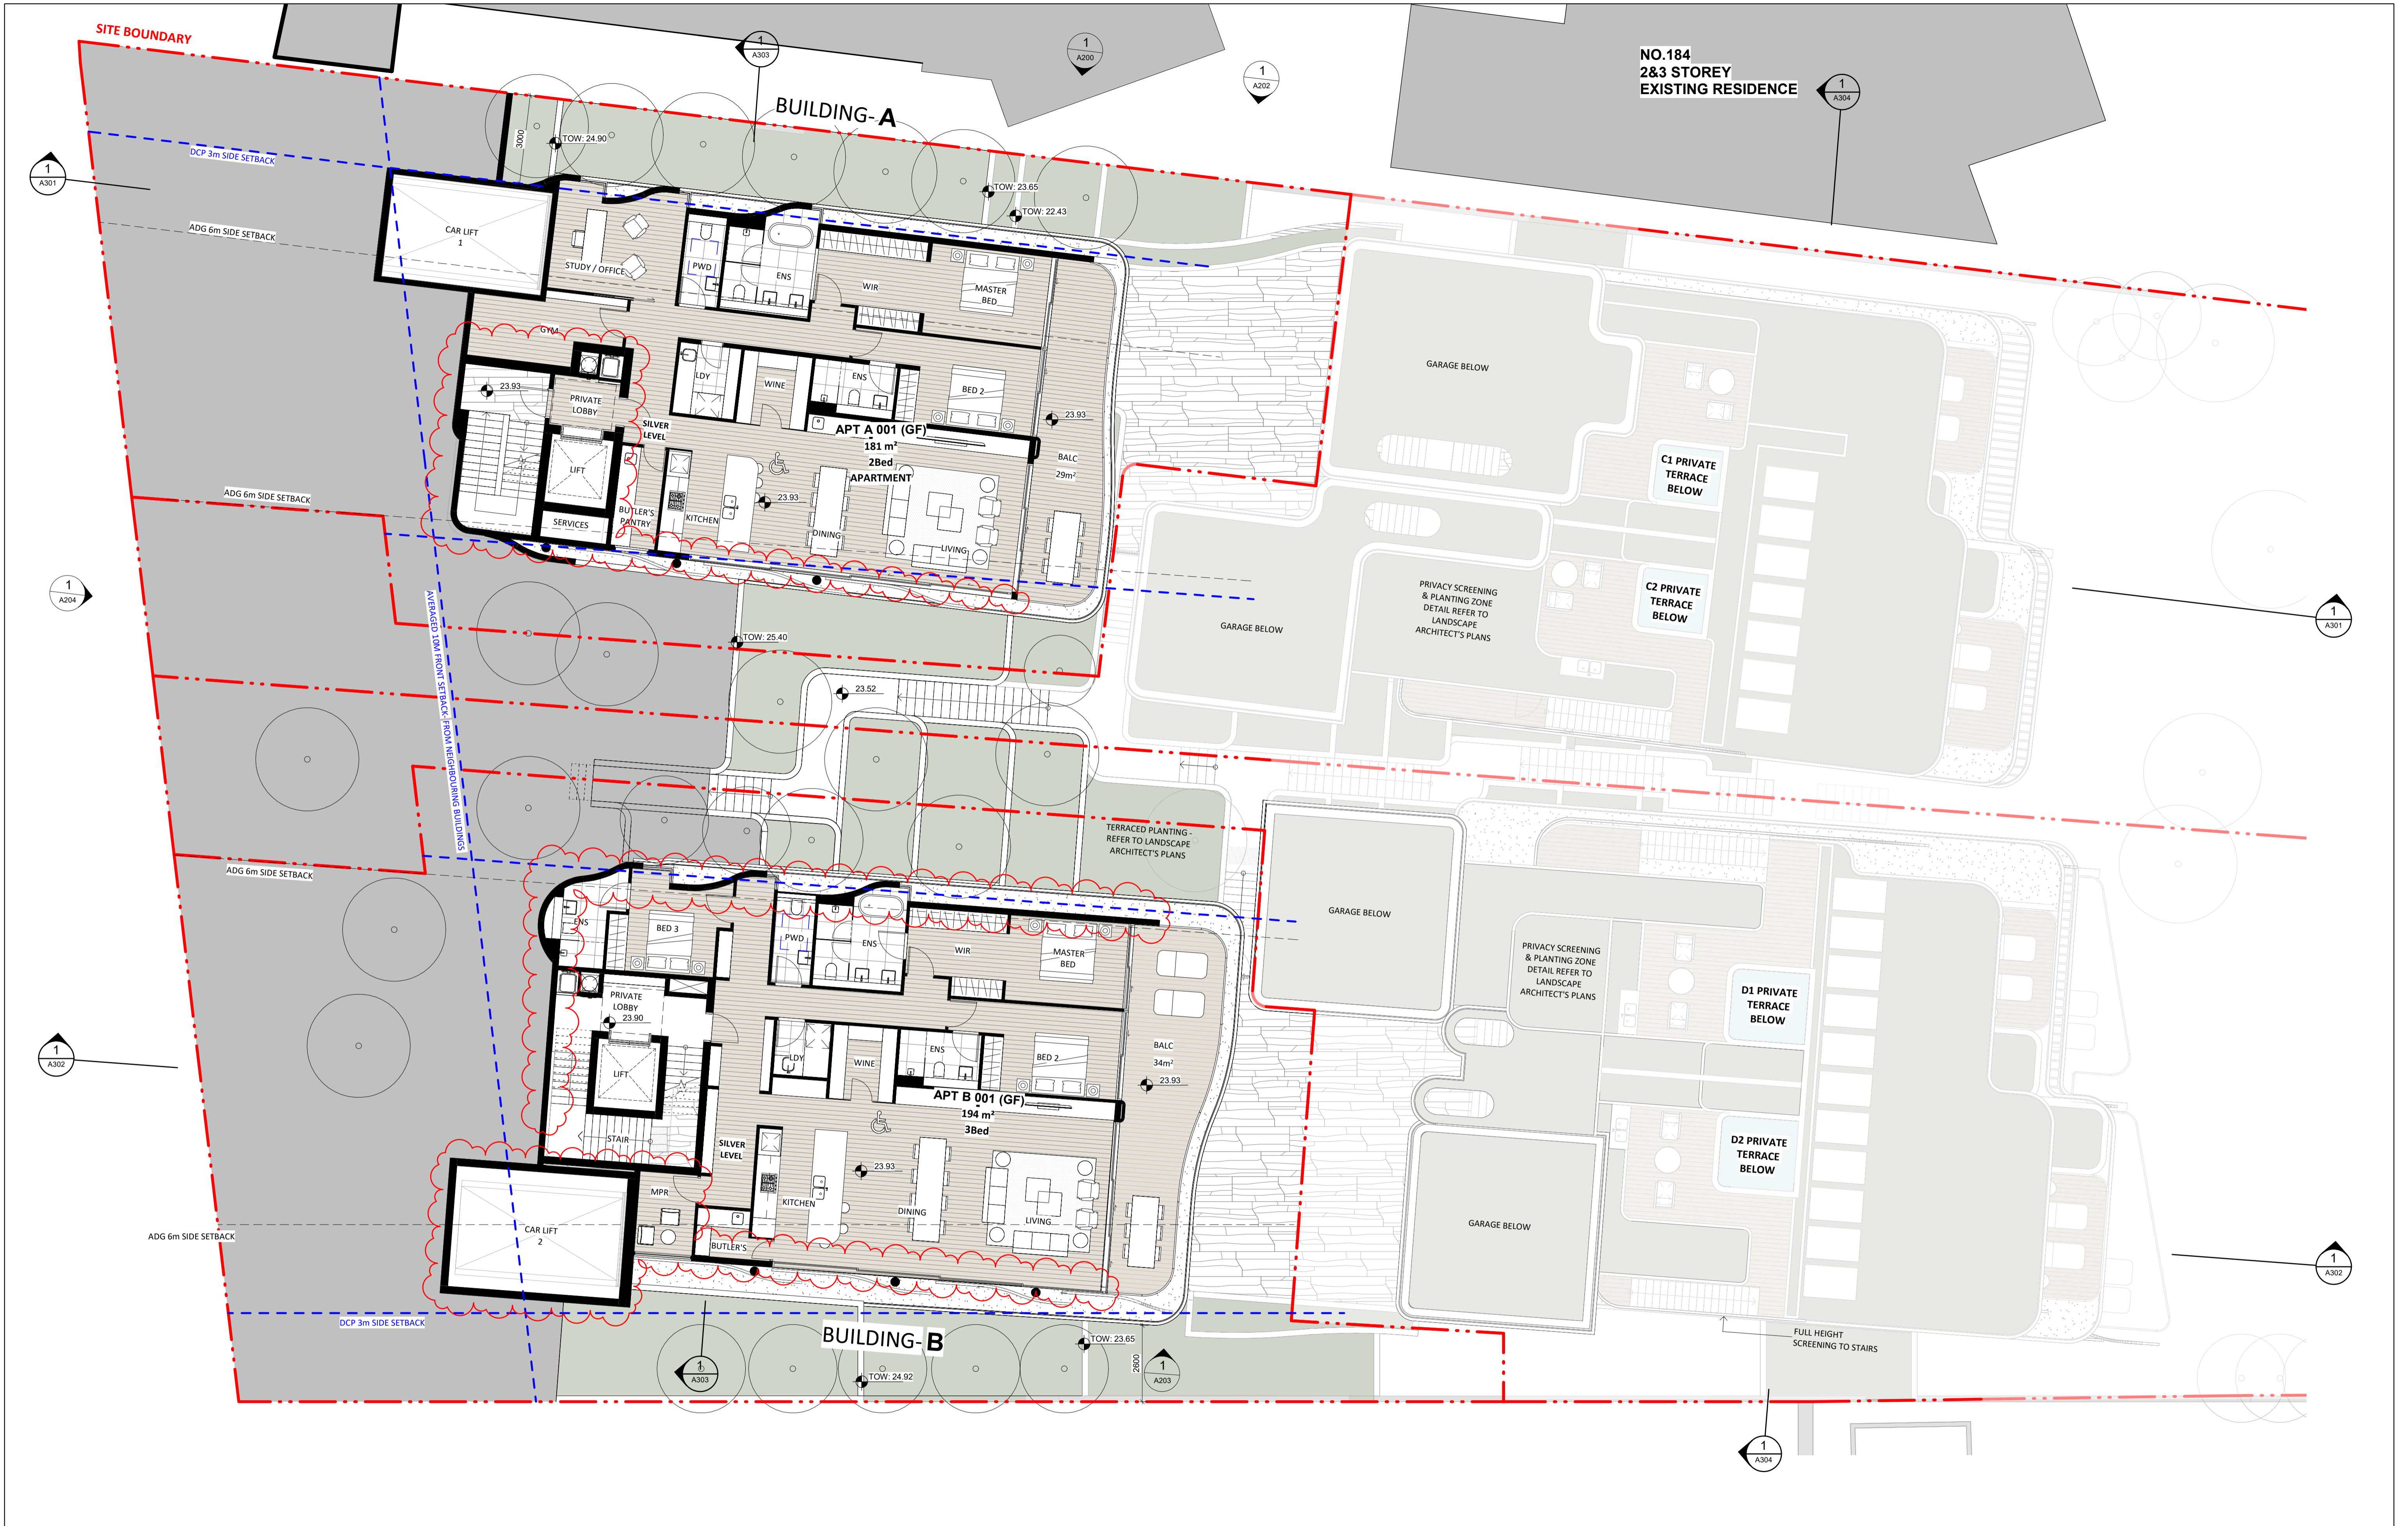

NO.	REVISION	BY	CHK	DATE	REVISION NOTES:
1	FOR INFORMATION			18.11.2021	
2	FOR INFORMATION			08.12.2021	
3	FOR INFORMATION			17.12.2021	
4	PRE-LODGE			20.01.2022	
5	COORDINATION ISSUE			09.02.2022	
6	COORDINATION ISSUE	RPW	AC	13.04.2022	
7	PRIENTATION ISSUE	AL	AC	13.05.2022	
8	AMENDED COORDINATION ISSUE	AL	RPW	19.05.2022	
9	DA ISSUE	RPW	AC	08.06.2022	
10	RFI PLAN COORDINATION ISSUE	AL	RPW	14.07.2023	
11	UPDATED DRAFT ISSUE	AL	RPW	25.07.2023	
12	COUNCIL RFI COORDINATION ISSUE	AL/DR	RPW	31.07.2023	
13	COUNCIL RFI ISSUE	AL/DR	RPW	15.08.2023	
14	ISSUE FOR DA RESUBMISSION	AL	RPW	02.02.2024	

KEY PLAN	REVISION	ON HOLD
	REVISION	
	ON HOLD	

NOTES:
 KOICHI TAKADA ARCHITECTS (KTA) RETAIN ALL COMMON LAW AND STATUTORY RIGHTS INCLUDING COPYRIGHT AND INTELLECTUAL PROPERTY RIGHTS TO THIS DOCUMENT.
 THIS DOCUMENT MUST NOT BE EDITED, PARTIALLY EXTRACTED, REPRODUCED OR DISTRIBUTED IN ANY MANNER WITHOUT KTA'S EXPRESS WRITTEN CONSENT AND UNDER NO CIRCUMSTANCES SHALL THE TRANSFER OF THIS DOCUMENT BE DEEMED A SALE OR CONSTITUTE A TRANSFER OF ANY LICENCE TO USE THE DOCUMENT WITHOUT KTA'S KNOWLEDGE OR CONSENT.
 THE PDF DOCUMENT STAMPED BY KTA AS A QA CONTROLLED DOCUMENT IS THE ONLY OFFICIAL VERSION OF THIS DOCUMENT AND IS STRICTLY SUBJECT TO COPYRIGHT.
 THE CONTENT AND ACCURACY OF THE DOCUMENT IS STRICTLY LIMITED TO THAT DEPICTED IN THE QA CONTROLLED PDF. DO NOT MEASURE FROM THE ELECTRONIC OR HARD COPY VERSIONS OF THIS DOCUMENT.
 VERIFY ALL DIMENSIONS ON SITE BEFORE COMMENCING SHOP DRAWINGS, FABRICATION, CONSTRUCTION OR INSTALLATION.

CLIENT
 Kurraba Point Road Pty Ltd
 430 TOORAK ROAD, TOORAK 3142

ARCHITECT
 SUITE 41 & 42, LEVEL 4
 61 MARLBOROUGH ST
 SURRY HILLS, NSW 2010
 T 02 9698 8510
 ABN 63 131 365 896
 NOMINATED ARCHITECT:
 KOICHI TAKADA
 NSW ARCHITECTS 6901
 VIC ARCHITECTS 16179
 QLD ARCHITECTS 5590
 KOICHI TAKADA.COM

GA STAMP


Koichi Takada Architects

PROJECT
 190 KURRABA RD
 190 KURRABA RD, KURRABA POINT NSW
 2089

STATUS
 DEVELOPMENT APPLICATION - RFI 01

SCALE
 1:100@A1, 1:200@A3

DWG TITLE	REVISION	DATE
R4 GROUND	14	02.02.2024

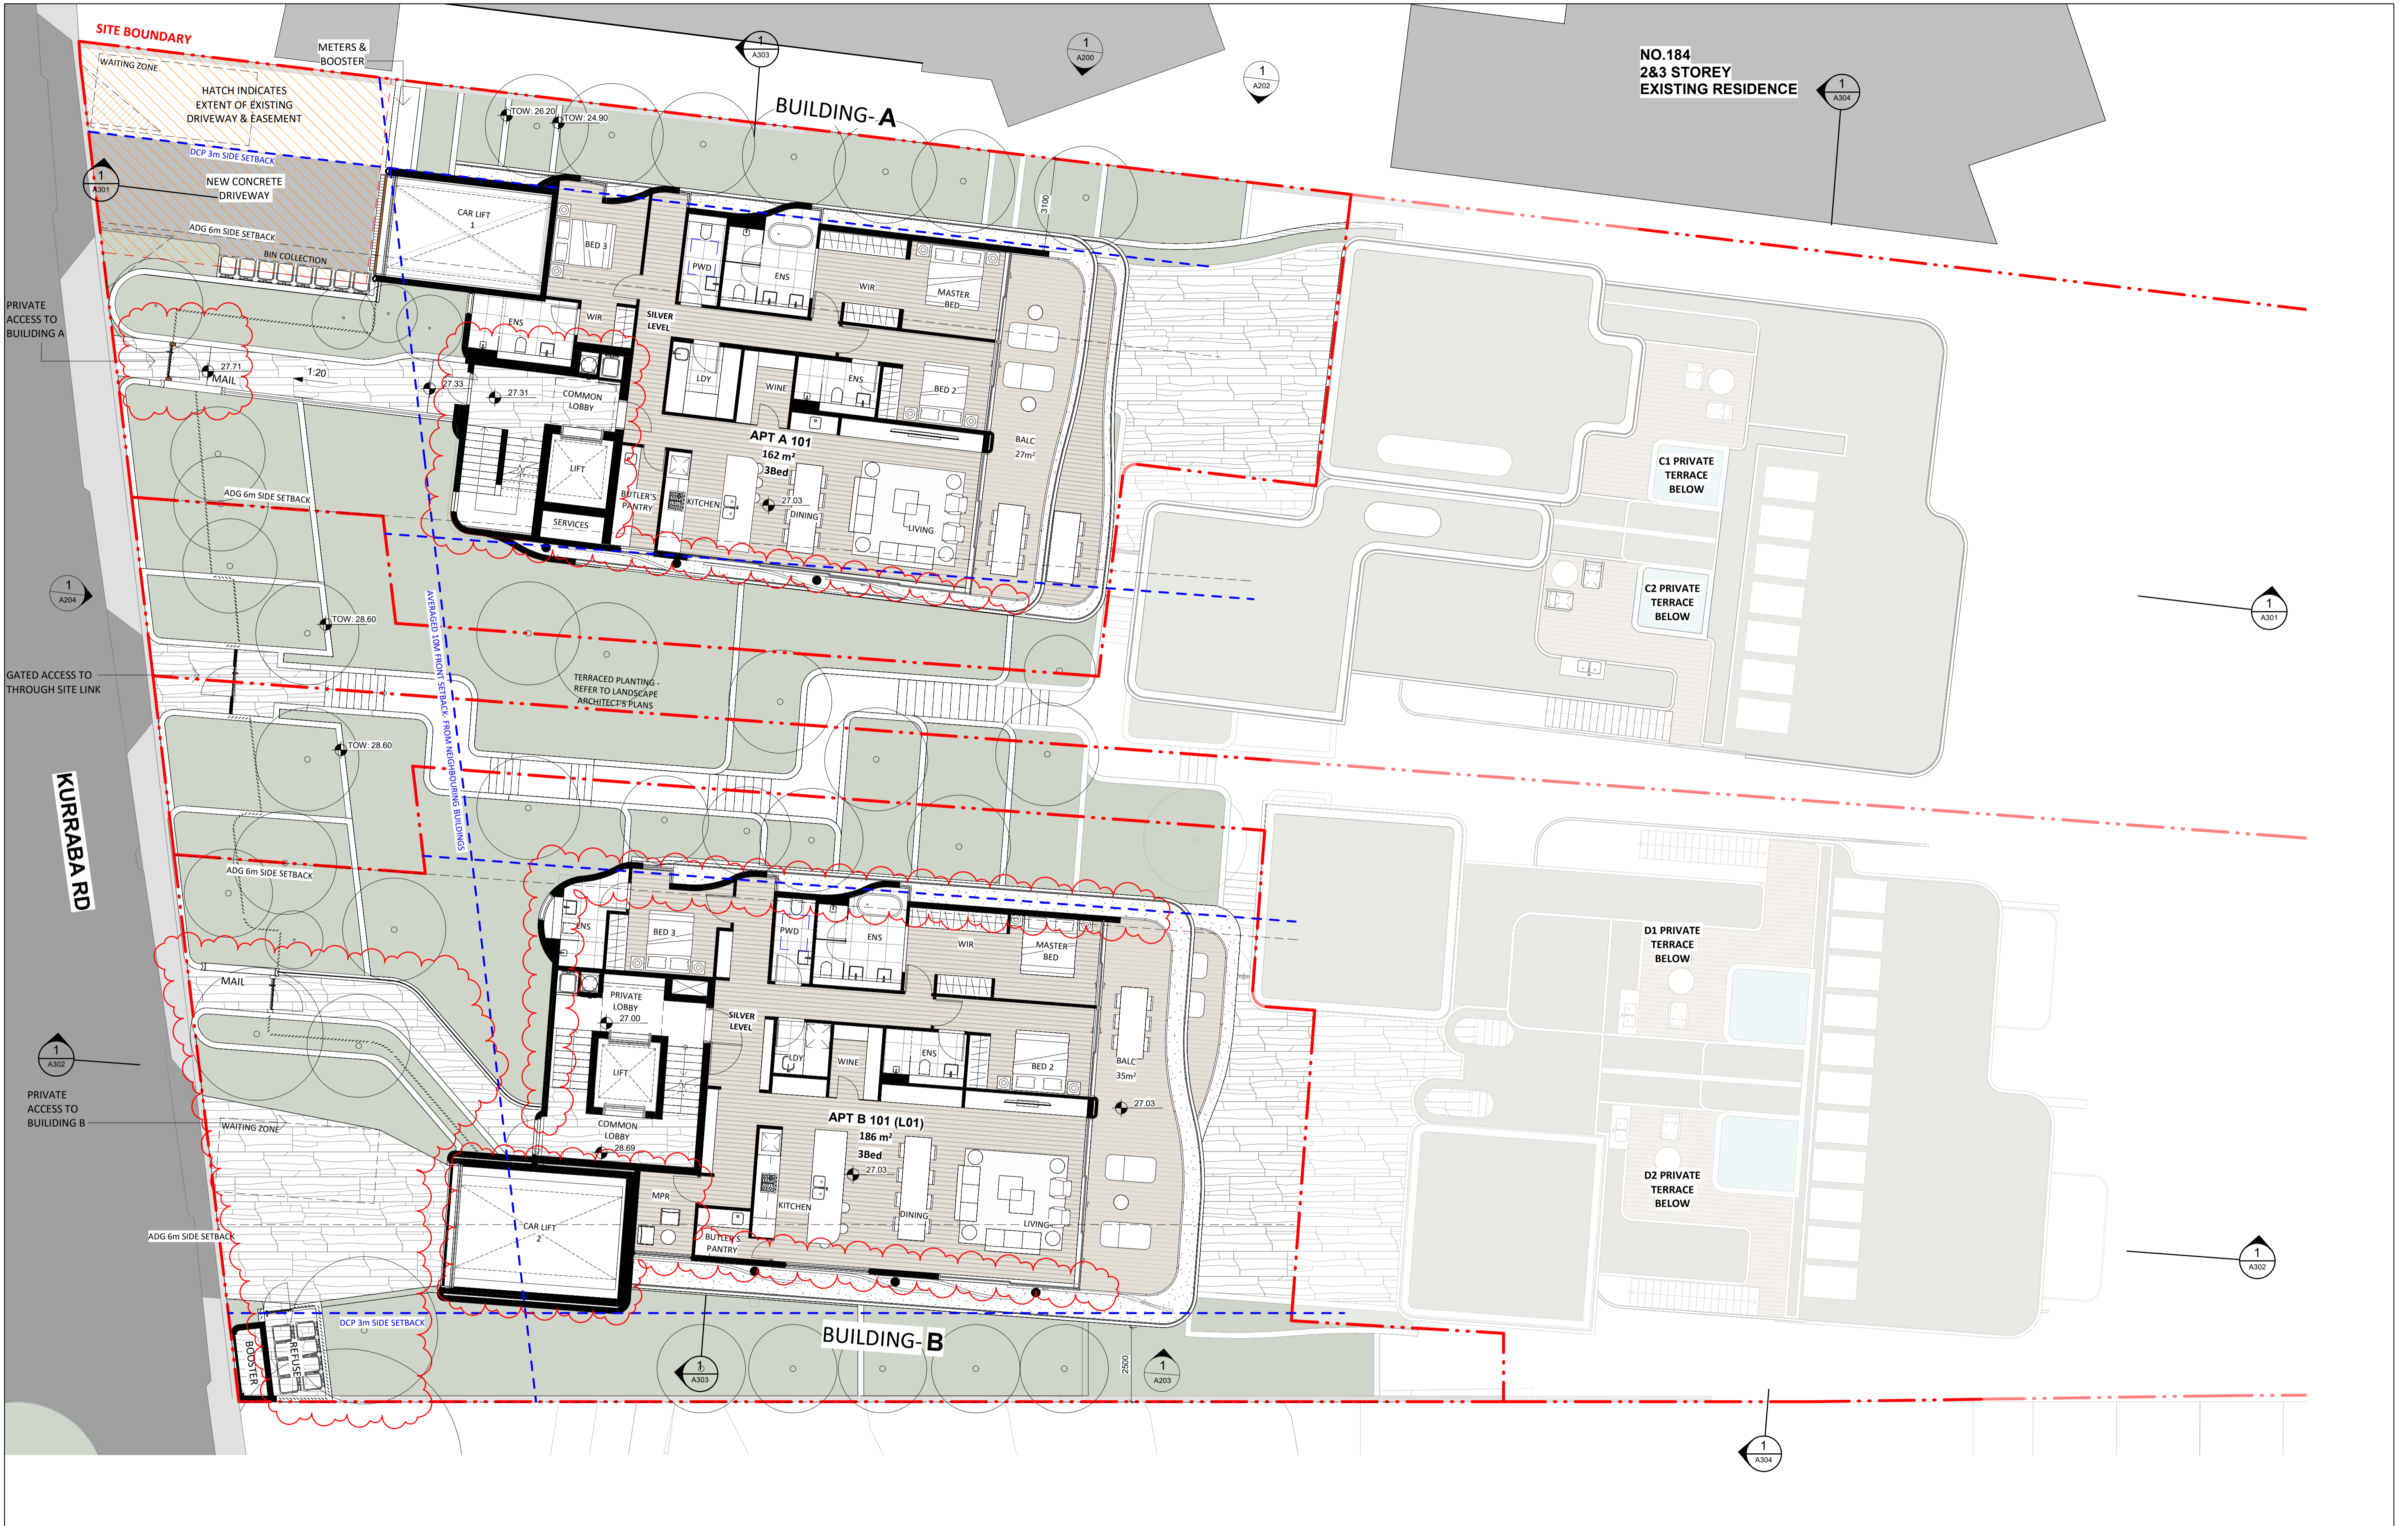

NO.	REVISION	BY	CHK	DATE	REVISION NOTES
1	FOR INFORMATION			08.12.2021	
2	FOR INFORMATION			17.02.2021	
3	COORDINATION ISSUE			09.02.2020	
4	COORDINATION ISSUE			18.03.2022	
5	COORDINATION ISSUE	RPW	AC	13.04.2022	
6	PRESENTATION ISSUE	AL	AC	13.05.2022	
7	COORDINATION ISSUE	RPW	RPW	18.05.22	
8	AMENDED COORDINATION ISSUE	AL	RPW	19.05.2022	
9	DA ISSUE	RPW	AC	08.06.2022	
10	RP1 PLAN COORDINATION ISSUE	AL	RPW	14.07.2023	
11	RP1 TRAFFIC COORDINATION	AL	RPW	24.07.2023	
12	UPDATED DRAFT ISSUE	AL	RPW	25.07.2023	
13	COUNCIL RP1 COORDINATION ISSUE	AL/CK	RPW	31.07.2023	
14	COUNCIL RP1 ISSUE	AL/CK	RPW	15.08.2023	
15	ISSUE FOR DA RESUBMISSION	AL	RPW	02.02.2024	

KEY PLAN	NOTES
REVISION	OTHERS
ON HOLD	

NOTES:
 KOICHI TAKADA ARCHITECTS (KTA) RETAIN ALL COMMON LAW AND STATUTORY RIGHTS INCLUDING COPYRIGHT AND INTELLECTUAL PROPERTY RIGHTS TO THIS DOCUMENT.
 THIS DOCUMENT MUST NOT BE EDITED, PARTIALLY EXTRACTED, REPRODUCED OR DISTRIBUTED IN ANY MANNER WITHOUT KTA'S EXPRESS WRITTEN CONSENT AND UNDER NO CIRCUMSTANCES SHALL THE TRANSFER OF THIS DOCUMENT BE DEEMED A SALE OR CONSTITUTE A TRANSFER OF ANY LICENCE TO USE THE DOCUMENT WITHOUT KTA'S KNOWLEDGE OR CONSENT.
 THE PDF DOCUMENT STAMPED BY KTA AS A QA CONTROLLED DOCUMENT IS THE ONLY OFFICIAL VERSION OF THIS DOCUMENT AND IS STRICTLY SUBJECT TO COPYRIGHT.
 THE CONTENT AND ACCURACY OF THE DOCUMENT IS STRICTLY LIMITED TO THAT DEPICTED IN THE QA CONTROLLED PDF. DO NOT MEASURE FROM THE ELECTRONIC OR HARD COPY VERSIONS OF THIS DOCUMENT.
 VERIFY ALL DIMENSIONS ON SITE BEFORE COMMENCING SHOP DRAWINGS, FABRICATION, CONSTRUCTION OR INSTALLATION.

CLIENT
 Kurraba Point Road Pty Ltd
 430 TOORAK ROAD, TOORAK 3142

ARCHITECT
 SUITE 41 & 42, LEVEL 4
 61 MARLBOROUGH ST
 SURRY HILLS, NSW 2010
 T 02 9698 8510
 ASN 63 131 365 896
 NOMINATED ARCHITECT:
 KOICHI TAKADA
 NSW ARCHITECTS 6901
 VIC ARCHITECTS 16179
 QLD ARCHITECTS 5590
 KOICHI TAKADA.COM

Koichi Takada Architects

PROJECT
 190 KURRABA RD
 190 KURRABA RD, KURRABA POINT NSW
 2089

STATUS
 DEVELOPMENT APPLICATION - RFI 01

DWG TITLE
 R4 LEVEL 1

DWG NO.
 A106

REVISION
 16


SCALE
 1:100@A1, 1:200@A3

DATE
 02.02.2024

GA STAMP

0 5 m

THIS DOCUMENT IS NOT SUITABLE OR APPROVED FOR CONSTRUCTION AT ANY TIME UNLESS KTA HAVE NOTATED THE STATUS TITLE AS FOR CONSTRUCTION WITHOUT THE PRESENCE OF 'WIP', 'DRAFT' OR ANY OTHER FORM OF QUALIFICATION ON THE DOCUMENT.

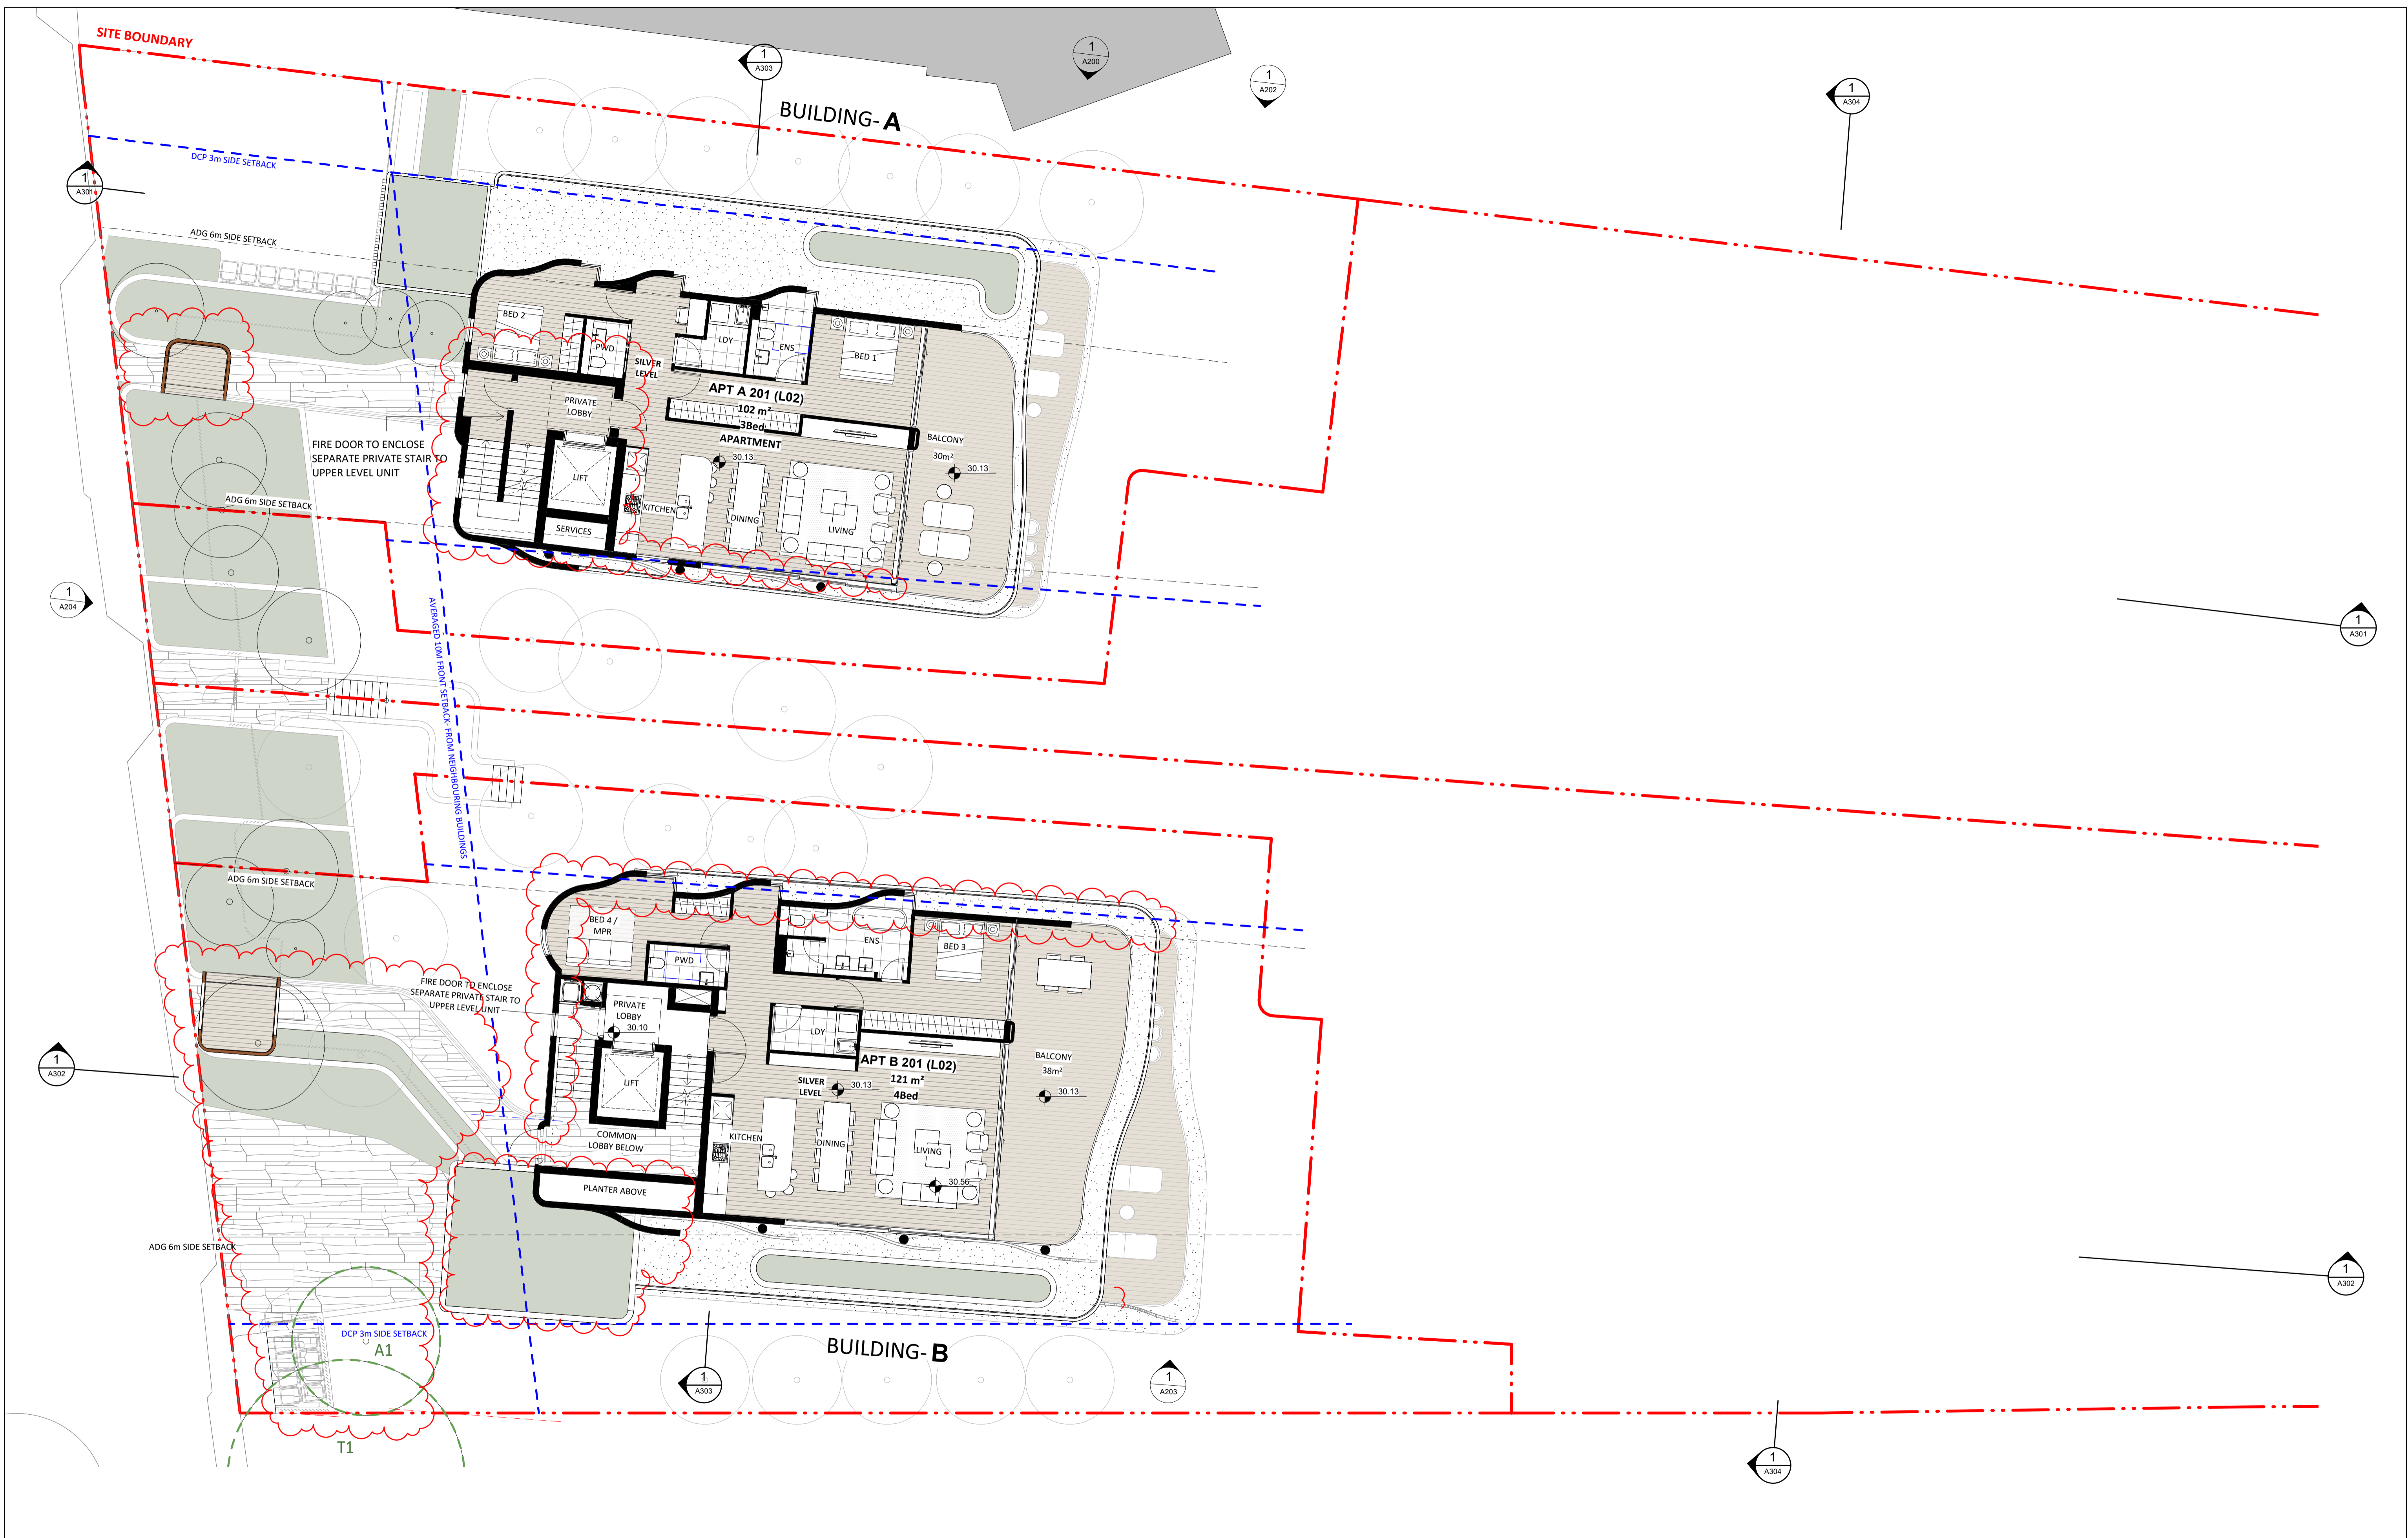

NO.	REVISION	BY	CHK	DATE	REVISION NOTES:
1	FOR INFORMATION			18.11.2021	
2	FOR INFORMATION			18.12.2021	
3	FOR INFORMATION			17.12.2021	
4	PRE-LODGE			20.01.2022	
5	COORDINATION ISSUE			09.02.2022	
6	COORDINATION ISSUE			18.03.2022	
7	COORDINATION ISSUE			09.04.2022	
8	PRESENTATION ISSUE	RPW	AC	13.05.2022	
9	AMENDED COORDINATION ISSUE	AL	RPW	19.05.2022	
10	DA ISSUE	RPW	AC	08.06.2022	
11	RP PLAN COORDINATION ISSUE	AL	RPW	14.07.2023	
12	UPDATED DRAFT ISSUE	AL	RPW	25.07.2023	
13	COUNCIL RFI COORDINATION ISSUE	AL/CK	RPW	11.07.2023	
14	COUNCIL RFI ISSUE	AL/CK	RPW	15.08.2023	
15	ISSUE FOR DA RESUBMISSION	AL	RPW	02.02.2024	

KEY PLAN	NOTES
REVISION ON HOLD	NOTES: KOICHI TAKADA ARCHITECTS (KTA) RETAIN ALL COMMON LAW AND STATUTORY RIGHTS INCLUDING COPYRIGHT AND INTELLECTUAL PROPERTY RIGHTS TO THIS DOCUMENT. THIS DOCUMENT MUST NOT BE EDITED, PARTIALLY EXTRACTED, REPRODUCED OR DISTRIBUTED IN ANY MANNER WITHOUT KTA'S EXPRESS WRITTEN CONSENT AND UNDER NO CIRCUMSTANCES SHALL THE TRANSFER OF THIS DOCUMENT BE DEEMED A SALE OR CONSTITUTE A TRANSFER OF ANY LICENCE TO USE THE DOCUMENT WITHOUT KTA'S KNOWLEDGE OR CONSENT. THE PDF DOCUMENT STAMPED BY KTA AS A QA CONTROLLED DOCUMENT IS THE ONLY OFFICIAL VERSION OF THIS DOCUMENT AND IS STRICTLY SUBJECT TO COPYRIGHT. THE CONTENT AND ACCURACY OF THE DOCUMENT IS STRICTLY LIMITED TO THAT DEPICTED IN THE QA CONTROLLED PDF. DO NOT MEASURE FROM THE ELECTRONIC OR HARD COPY VERSIONS OF THIS DOCUMENT. VERIFY ALL DIMENSIONS ON SITE BEFORE COMMENCING SHOP DRAWINGS, FABRICATION, CONSTRUCTION OR INSTALLATION.

CLIENT	ARCHITECT
Kurraba Point Road Pty Ltd 430 TOORAK ROAD, TOORAK 3142	SUITE 41 & 42, LEVEL 4 61 MARLBOROUGH ST SURRY HILLS, NSW 2010 T 02 9698 8510 ABN 63 131 365 896 NOMINATED ARCHITECT: KOICHI TAKADA NSW ARCHITECTS 6901 VIC ARCHITECTS 16179 QLD ARCHITECTS 5590 KOICHI TAKADA.COM

CLIENT	ARCHITECT
Kurraba Point Road Pty Ltd 430 TOORAK ROAD, TOORAK 3142	SUITE 41 & 42, LEVEL 4 61 MARLBOROUGH ST SURRY HILLS, NSW 2010 T 02 9698 8510 ABN 63 131 365 896 NOMINATED ARCHITECT: KOICHI TAKADA NSW ARCHITECTS 6901 VIC ARCHITECTS 16179 QLD ARCHITECTS 5590 KOICHI TAKADA.COM


Koichi Takada Architects

PROJECT	DWG TITLE
190 KURRABA RD 190 KURRABA RD, KURRABA POINT NSW 2089	R4 LEVEL 2

STATUS	DWG NO.	REVISION
DEVELOPMENT APPLICATION - RFI 01	A107	15

SCALE	DATE
1:100@A1, 1:200@A3	02.02.2024

THIS DOCUMENT IS NOT SUITABLE OR APPROVED FOR CONSTRUCTION AT ANY TIME UNLESS KTA HAVE NOTATED THE STATUS TITLE AS FOR CONSTRUCTION WITHOUT THE PRESENCE OF 'WIP', 'DRAFT' OR ANY OTHER FORM OF QUALIFICATION ON THE DOCUMENT.

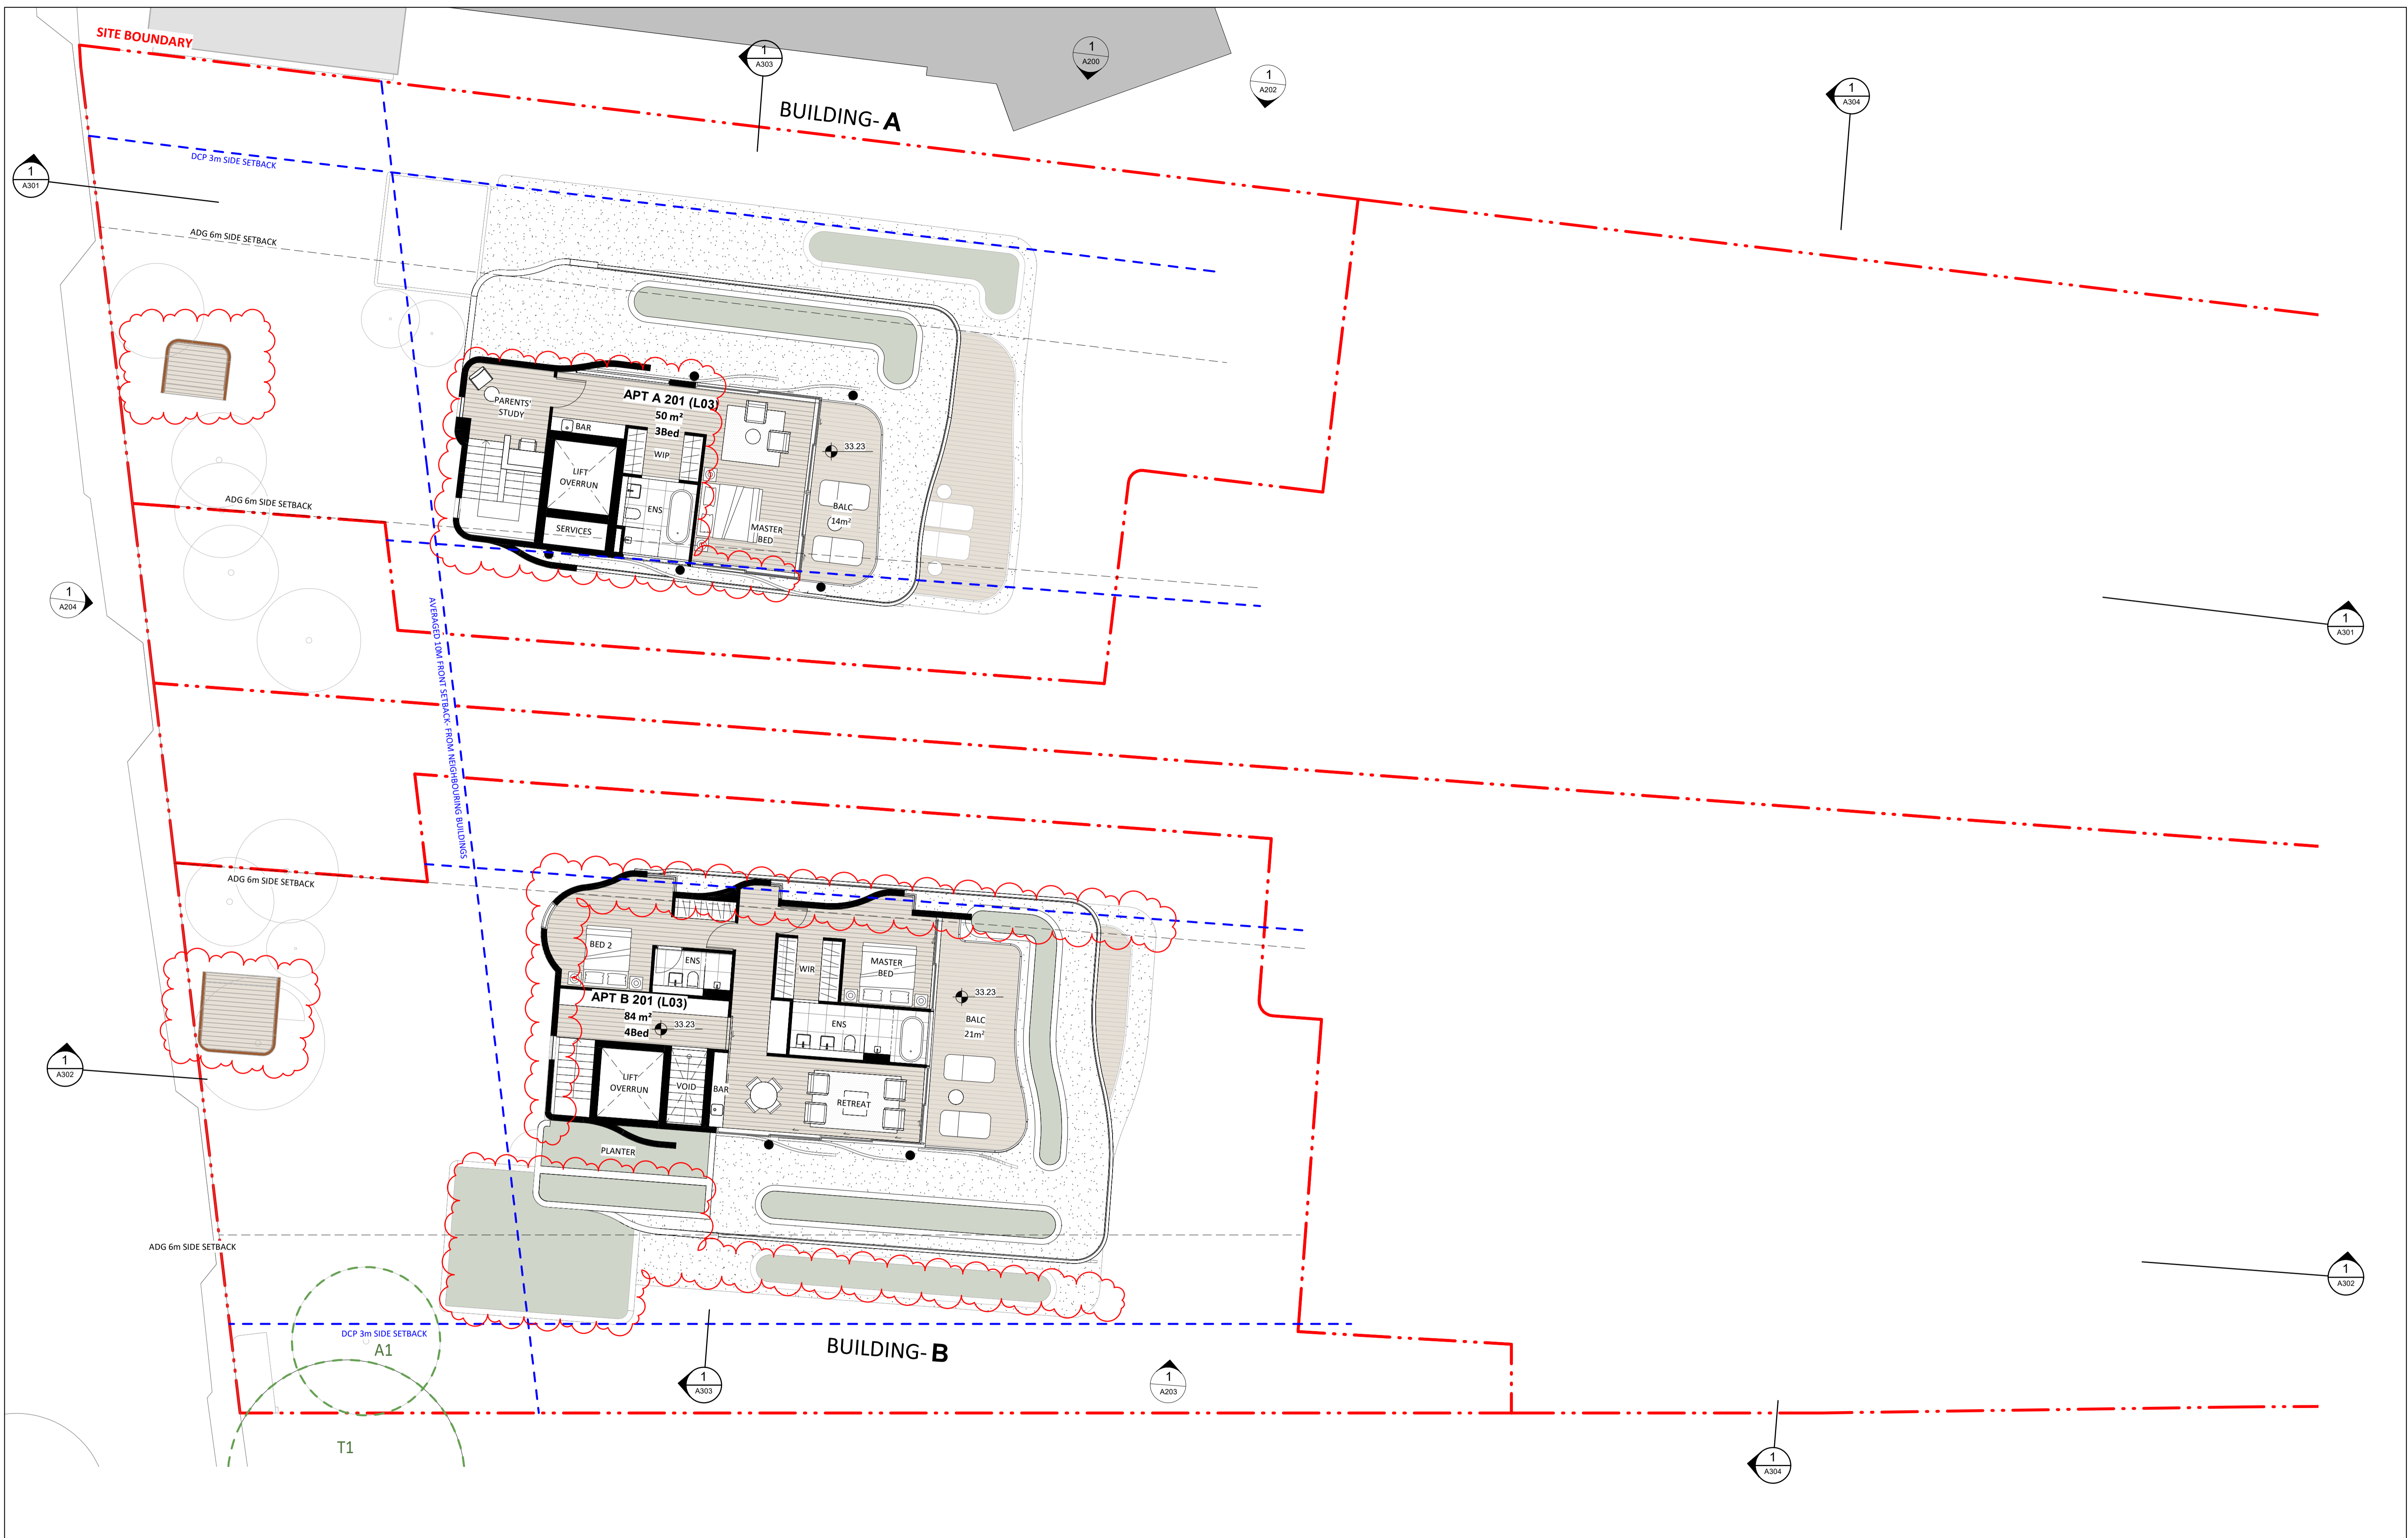

NO.	REVISION	BY	CHK	DATE	REVISION NOTES
1	FOR INFORMATION			18.11.2021	
2	FOR INFORMATION			08.12.2021	
3	FOR INFORMATION			17.12.2021	
4	PRE-LODGE			20.01.2022	
5	COORDINATION ISSUE			09.02.2022	
6	COORDINATION ISSUE	RPW	JAC	13.04.2022	
7	PRIENTATION ISSUE	AL	JAC	13.05.2022	
8	AMENDED COORDINATION ISSUE	AL	RPW	19.05.2022	
9	DA ISSUE	RPW	JAC	08.06.2022	
10	RFI PLAN COORDINATION ISSUE	AL	RPW	14.07.2023	
11	UPDATED DRAFT ISSUE	AL	RPW	25.07.2023	
12	COUNCIL RFI COORDINATION ISSUE	AL/DR	RPW	31.07.2023	
13	COUNCIL RFI ISSUE	AL/DR	RPW	15.08.2023	
14	ISSUE FOR DA RESUBMISSION	AL	RPW	02.02.2024	

KEY PLAN	NOTES
REVISION ON HOLD	NOTES: KOICHI TAKADA ARCHITECTS (KTA) RETAIN ALL COMMON LAW AND STATUTORY RIGHTS INCLUDING COPYRIGHT AND INTELLECTUAL PROPERTY RIGHTS TO THIS DOCUMENT. THIS DOCUMENT MUST NOT BE EDITED, PARTIALLY EXTRACTED, REPRODUCED OR DISTRIBUTED IN ANY MANNER WITHOUT KTA'S EXPRESS WRITTEN CONSENT AND UNDER NO CIRCUMSTANCES SHALL THE TRANSFER OF THIS DOCUMENT BE DEEMED A SALE OR CONSTITUTE A TRANSFER OF ANY LICENCE TO USE THE DOCUMENT WITHOUT KTA'S KNOWLEDGE OR CONSENT. THE PDF DOCUMENT STAMPED BY KTA AS A QA CONTROLLED DOCUMENT IS THE ONLY OFFICIAL VERSION OF THIS DOCUMENT AND IS STRICTLY SUBJECT TO COPYRIGHT © THE CONTENT AND ACCURACY OF THE DOCUMENT IS STRICTLY LIMITED TO THAT DEPICTED IN THE QA CONTROLLED PDF. DO NOT MEASURE FROM THE ELECTRONIC OR HARD COPY VERSIONS OF THIS DOCUMENT. VERIFY ALL DIMENSIONS ON SITE BEFORE COMMENCING SHOP DRAWINGS, FABRICATION, CONSTRUCTION OR INSTALLATION.

CLIENT	ARCHITECT
Kurraba Point Road Pty Ltd 430 TOORAK ROAD, TOORAK 3142	SUITE 41 & 42, LEVEL 4 61 MARLBOROUGH ST SURREY HILLS, NSW 2010 T 02 9698 8510 ABN 63 131 365 896 NOMINATED ARCHITECT: KOICHI TAKADA NSW ARCHITECTS 6901 VIC ARCHITECTS 16179 QLD ARCHITECTS 5590 KOICHI TAKADA.COM

GA STAMP	PROJECT	DWG TITLE
	190 KURRABA RD 190 KURRABA RD, KURRABA POINT NSW 2089	R4 LEVEL 3


STATUS	DWG NO.	REVISION
DEVELOPMENT APPLICATION - RFI 01	A108	14

SCALE	DATE
1:100@A1, 1:200@A3	02.02.2024

Koichi Takada Architects

THIS DOCUMENT IS NOT SUITABLE OR APPROVED FOR CONSTRUCTION AT ANY TIME UNLESS KTA HAVE NOTATED THE STATUS TITLE AS FOR CONSTRUCTION WITHOUT THE PRESENCE OF 'WIP', 'DRAFT' OR ANY OTHER FORM OF QUALIFICATION ON THE DOCUMENT.

0 5 m

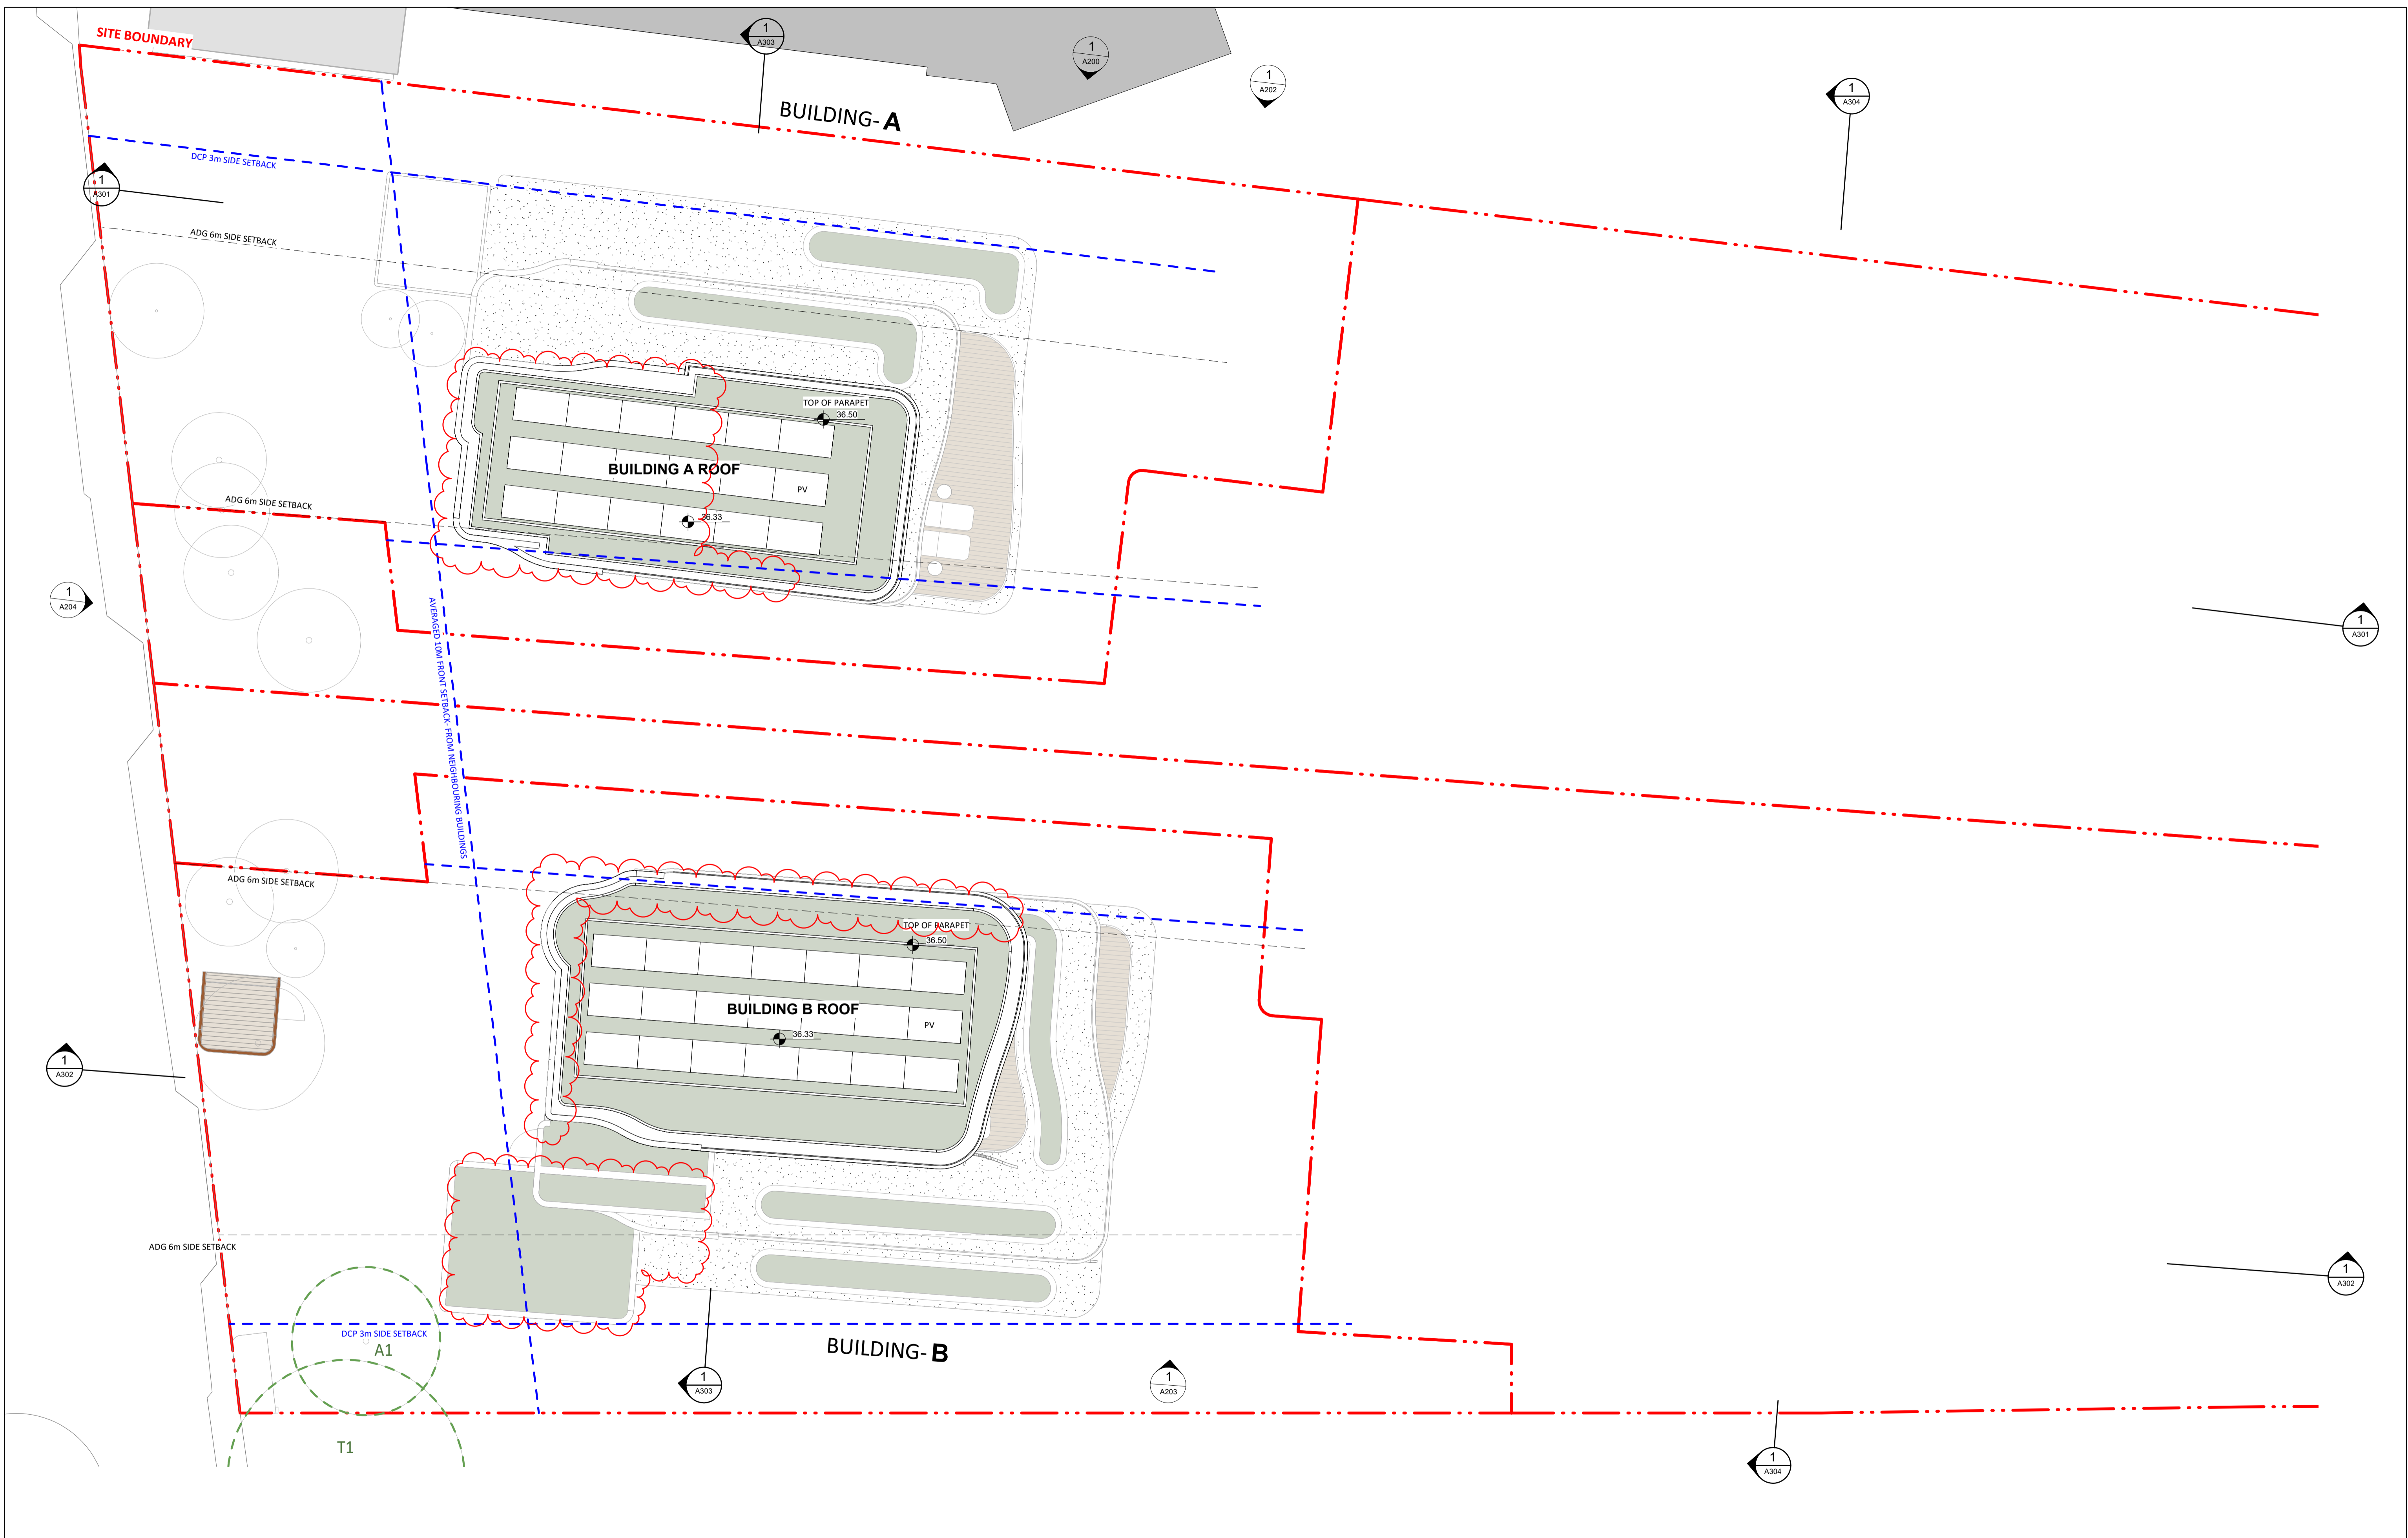

NO.	REVISION	BY	CHK	DATE	REVISION NOTES:
1	FOR INFORMATION			18.11.2021	
2	FOR INFORMATION			08.12.2021	
3	FOR INFORMATION			17.12.2021	
4	PRE-LODGE			20.01.2022	
5	COORDINATION ISSUE			09.02.2022	
6	COORDINATION ISSUE	RPW	JAC	13.04.2022	
7	PRESENTATION ISSUE	AL	JAC	13.05.2022	
8	AMENDED COORDINATION ISSUE	AL	RPW	19.05.2022	
9	DA ISSUE	RPW	JAC	08.06.2022	
10	RFI PLAN COORDINATION ISSUE	AL	RPW	14.07.2023	
11	UPDATED DRAFT ISSUE	AL	RPW	25.07.2023	
12	COUNCIL RFI COORDINATION ISSUE	AL/CR	RPW	31.07.2023	
13	COUNCIL RFI ISSUE	AL/CR	RPW	15.08.2023	
14	ISSUE FOR DA RESUBMISSION	AL	RPW	02.02.2024	

KEY PLAN
REVISION ON HOLD OTHER

NOTES:
 KOICHI TAKADA ARCHITECTS (KTA) RETAIN ALL COMMON LAW AND STATUTORY RIGHTS INCLUDING COPYRIGHT AND INTELLECTUAL PROPERTY RIGHTS TO THIS DOCUMENT.
 THIS DOCUMENT MUST NOT BE EDITED, PARTIALLY EXTRACTED, REPRODUCED OR DISTRIBUTED IN ANY MANNER WITHOUT KTA'S EXPRESS WRITTEN CONSENT AND UNDER NO CIRCUMSTANCES SHALL THE TRANSFER OF THIS DOCUMENT BE DEEMED A SALE OR CONSTITUTE A TRANSFER OF ANY LICENCE TO USE THE DOCUMENT WITHOUT KTA'S KNOWLEDGE OR CONSENT.
 THE PDF DOCUMENT STAMPED BY KTA AS A QA CONTROLLED DOCUMENT IS THE ONLY OFFICIAL VERSION OF THIS DOCUMENT AND IS STRICTLY SUBJECT TO COPYRIGHT.
 THE CONTENT AND ACCURACY OF THE DOCUMENT IS STRICTLY LIMITED TO THAT DENOTED IN THE QA CONTROLLED PDF. DO NOT MEASURE FROM THE ELECTRONIC OR HARD COPY VERSIONS OF THIS DOCUMENT.
 VERIFY ALL DIMENSIONS ON SITE BEFORE COMMENCING SHOP DRAWINGS, FABRICATION, CONSTRUCTION OR INSTALLATION.

CLIENT
 Kurraba Point Road Pty Ltd
 430 TOORAK ROAD, TOORAK 3142

ARCHITECT
 SUITE 41 & 42, LEVEL 4
 61 MARLBOROUGH ST
 SURRY HILLS, NSW 2010
 T 02 9698 8510
 ABN 63 131 365 896
 NOMINATED ARCHITECT:
 KOICHI TAKADA
 NSW ARCHITECTS 6901
 VIC ARCHITECTS 16179
 QLD ARCHITECTS 5590
 KOICHI.TAKADA.COM

Koichi Takada Architects

GA STAMP

PROJECT
 190 KURRABA RD
 190 KURRABA RD, KURRABA POINT NSW
 2089

DWG TITLE
 R4 ROOF

STATUS
 DEVELOPMENT APPLICATION - RFI 01

DWG NO.
 A109




REVISION
 14

SCALE
 1:100@A1, 1:200@A3

DATE
 02.02.2024

0 5 m

THIS DOCUMENT IS NOT SUITABLE OR APPROVED FOR CONSTRUCTION AT ANY TIME UNLESS KTA HAVE NOTATED THE STATUS TITLE AS FOR CONSTRUCTION WITHOUT THE PRESENCE OF 'WIP', 'DRAFT' OR ANY OTHER FORM OF QUALIFICATION ON THE DOCUMENT.

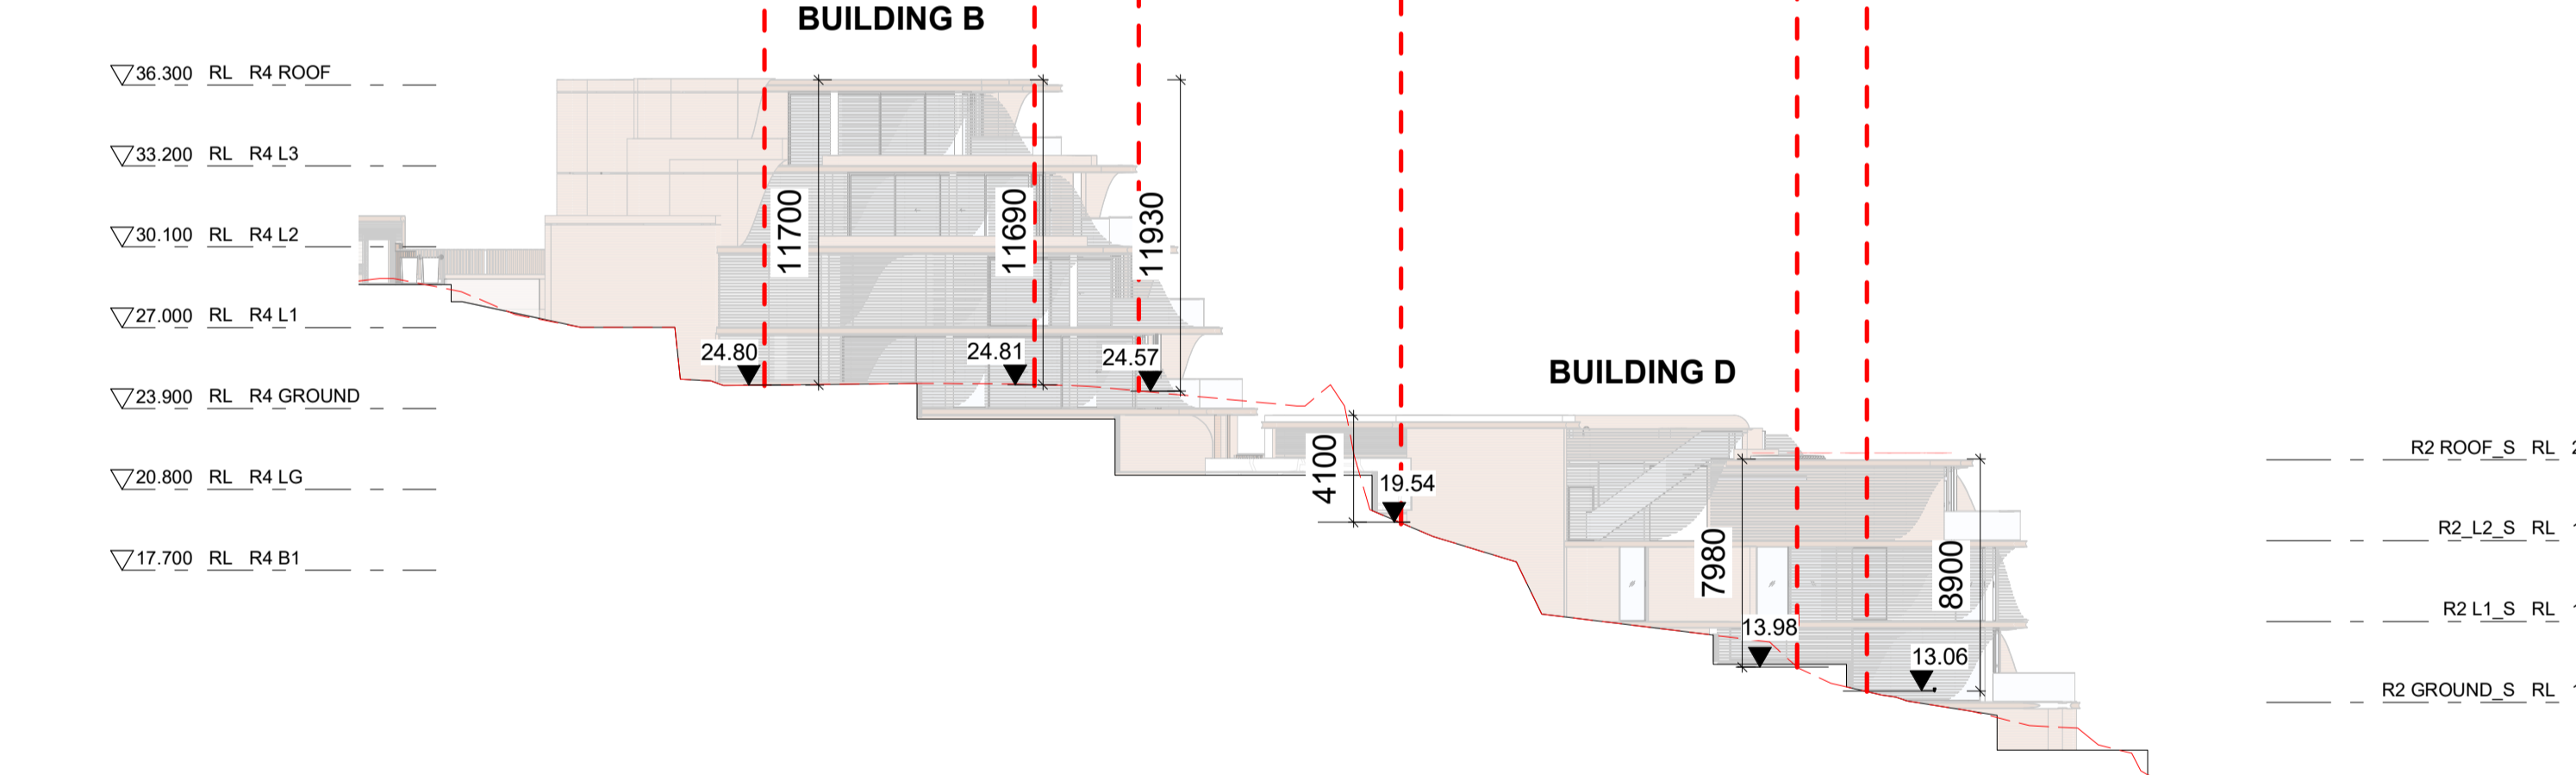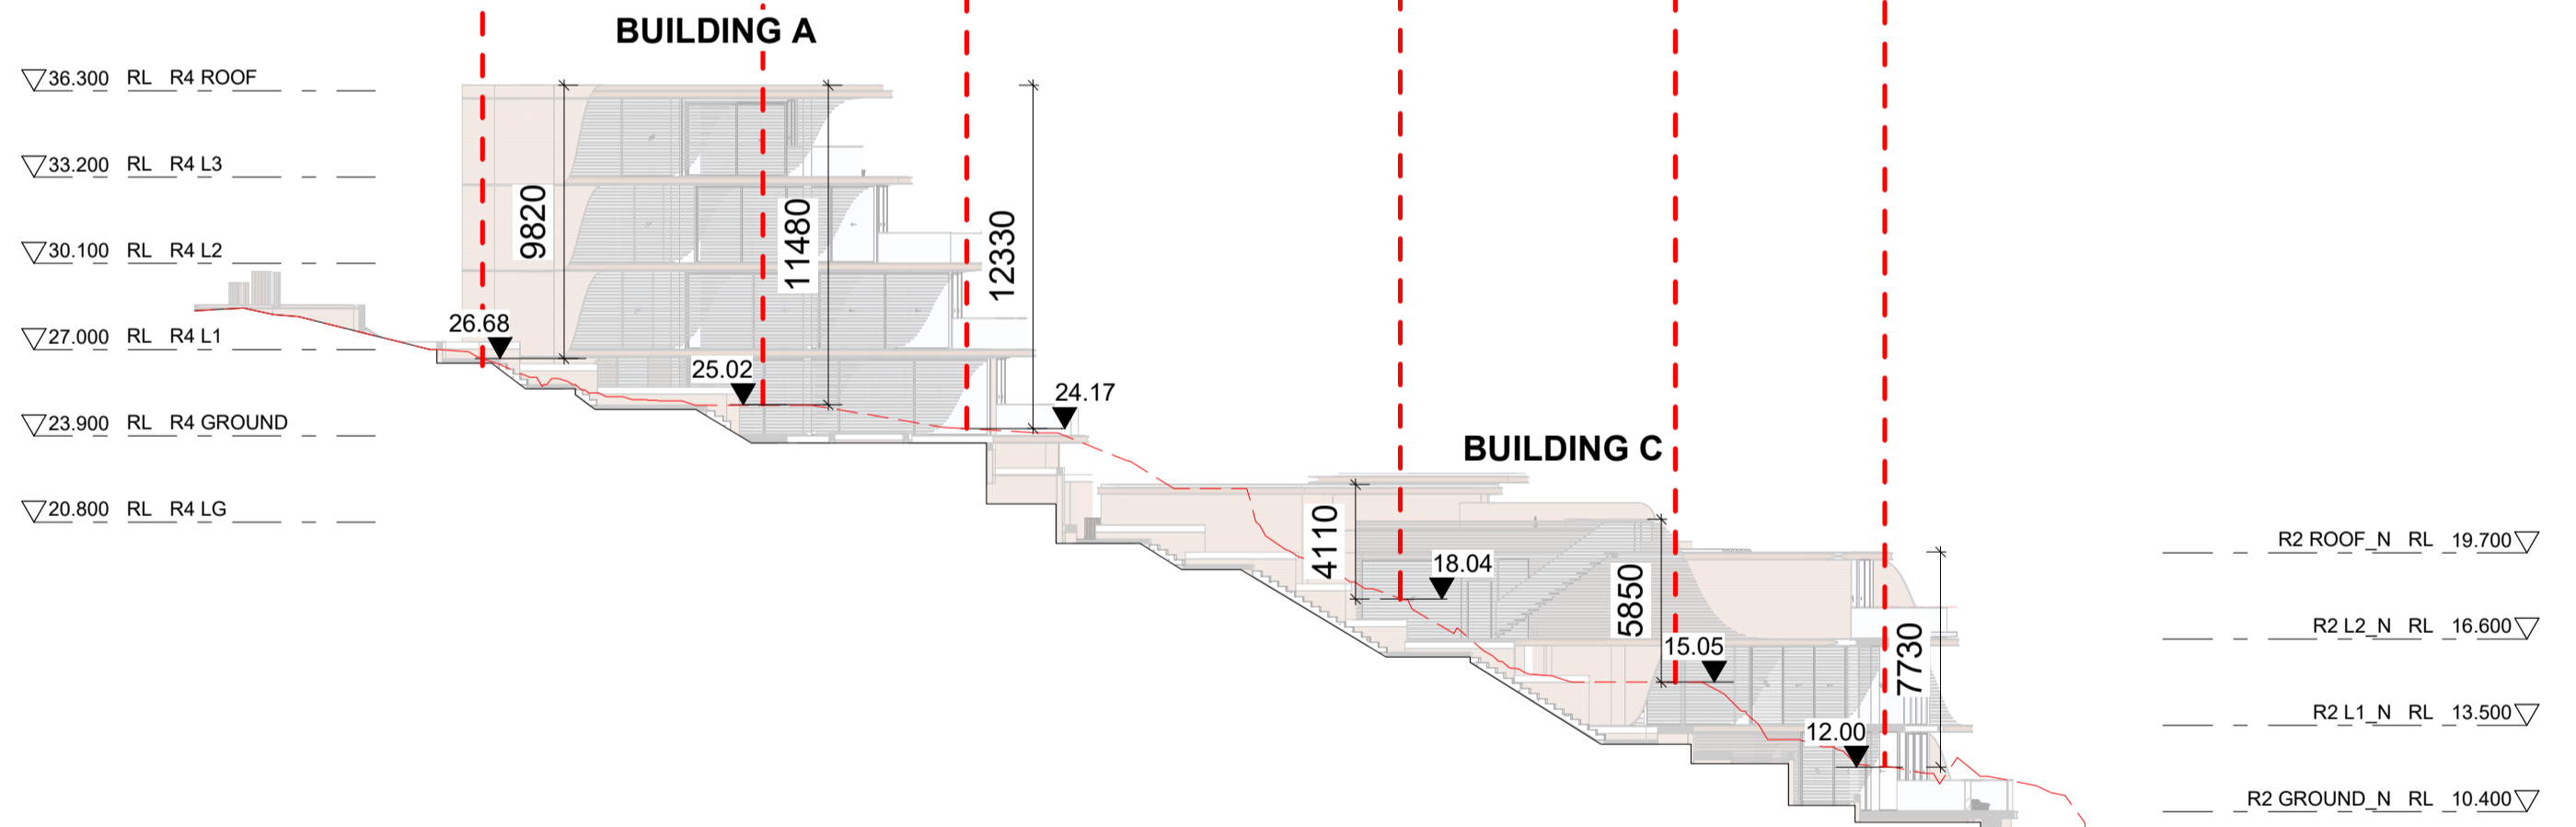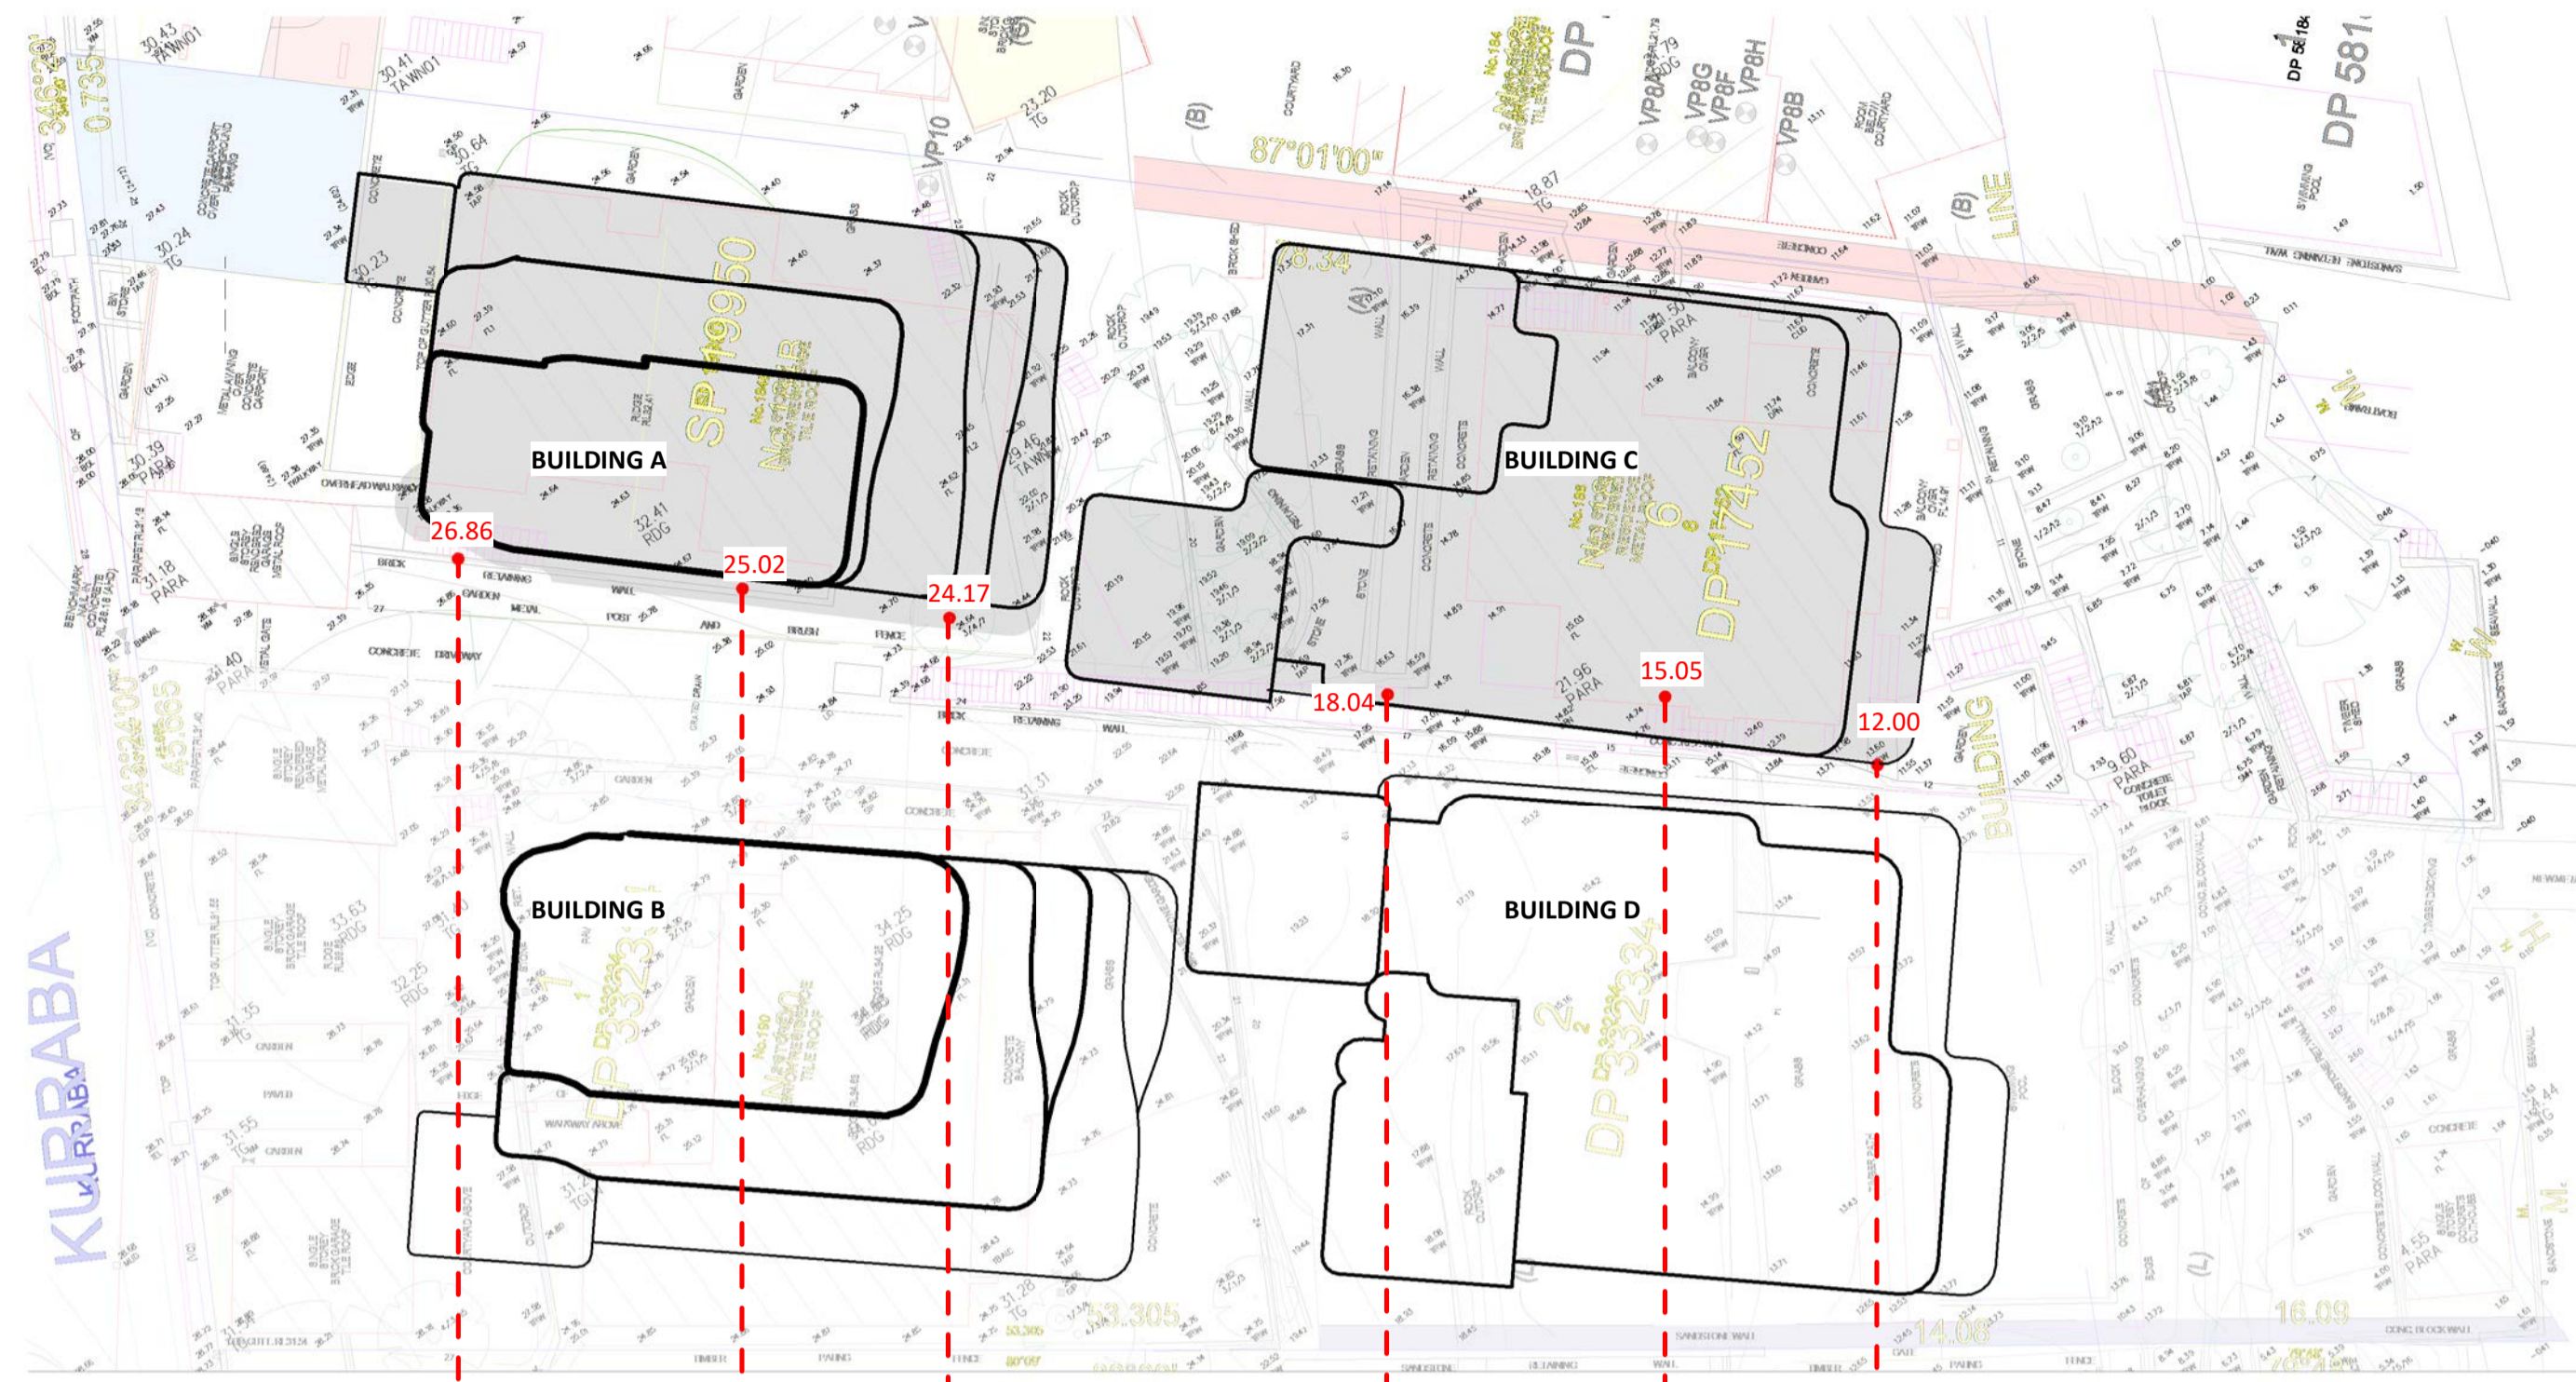

EXISTING GROUND LINE
IN ACCORDANCE WITH
BETTAR v COUNCIL

EXISTING GROUND LINE
IN ACCORDANCE WITH
BETTAR v COUNCIL

NO.	REVISION	BY	CHK	DATE	REVISION NOTES:
1	FOR INFORMATION			17.12.2021	
2	PRE-COORDINATION			20.11.2022	
3	COORDINATION ISSUE			09.02.2023	
4	AMENDED COORDINATION ISSUE	AL	RPW	19.05.2023	
5	DA ISSUE	RPW	AL	08.06.2023	
6	COUNCIL RFI COORDINATION ISSUE	AL/CK	RPW	31.07.2023	
7	COUNCIL RFI ISSUE	AL/CK	RPW	15.08.2023	
8	ISSUE FOR DA RESUBMISSION	AL	RPW	02.02.2024	

KEY PLAN
CLOUD LEGEND
REVISION
ON HOLD

NOTES:
KOICHI TAKADA ARCHITECTS (KTA) RETAIN ALL COMMON LAW AND STATUTORY RIGHTS INCLUDING COPYRIGHT AND INTELLECTUAL PROPERTY RIGHTS TO THIS DOCUMENT.
THIS DOCUMENT MUST NOT BE EDITED, PARTIALLY EXTRACTED, REPRODUCED OR DISTRIBUTED IN ANY MANNER WITHOUT KTA'S EXPRESS WRITTEN CONSENT AND UNDER NO CIRCUMSTANCES SHALL THE TRANSFER OF THIS DOCUMENT BE DEEMED A SALE OR CONSTITUTE A TRANSFER OF ANY LICENSE TO USE THE DOCUMENT WITHOUT KTA'S KNOWLEDGE OR CONSENT.
THE PDF DOCUMENT STAMPED BY KTA AS A QA CONTROLLED DOCUMENT IS THE ONLY OFFICIAL VERSION OF THIS DOCUMENT AND IS STRICTLY SUBJECT TO COPYRIGHT ©
THE CONTENT AND ACCURACY OF THE DOCUMENT IS STRICTLY LIMITED TO THAT SHOWN IN THE QA CONTROLLED PDF.
DO NOT MEASURE FROM THE ELECTRONIC OR HARD COPY VERSIONS OF THIS DOCUMENT.
VERIFY ALL DIMENSIONS ON SITE BEFORE COMMENCING SHOP DRAWINGS, FABRICATION, CONSTRUCTION OR INSTALLATION.

CLIENT
Kurraba Point Road Pty Ltd
430 TOORAK ROAD, TOORAK 3142

ARCHITECT
SUITE 41 & 42, LEVEL 4
61 MARLBOROUGH ST
SURRY HILLS, NSW 2010
T 02 9698 8510
ASN 63 131 365 896
NOMINATED ARCHITECT:
KOICHI TAKADA
NSW ARCHITECTS 6901
VIC ARCHITECTS 16179
QLD ARCHITECTS 5590
KOICHI.TAKADA.COM

Koichi Takada Architects

PROJECT
190 KURRABA RD
190 KURRABA RD, KURRABA POINT NSW 2089

STATUS
DEVELOPMENT APPLICATION - RFI 01


DWG TITLE
BUILDING HEIGHT

DWG NO.
A110

REVISION
8


SCALE
1:250@A1, 1:500@A3

DATE
02.02.2024

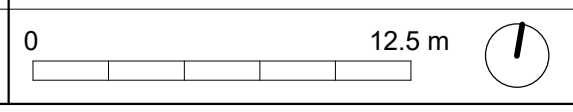

THIS DOCUMENT IS NOT SUITABLE OR APPROVED FOR CONSTRUCTION AT ANY TIME UNLESS KTA HAVE NOTATED THE STATUS TITLE AS FOR CONSTRUCTION WITHOUT THE PRESENCE OF WIP, DRAFT OR ANY OTHER FORM OF QUALIFICATION ON THE DOCUMENT.

184B - 190 KURRABA ROAD,
KURRABA POINT NSW 2089

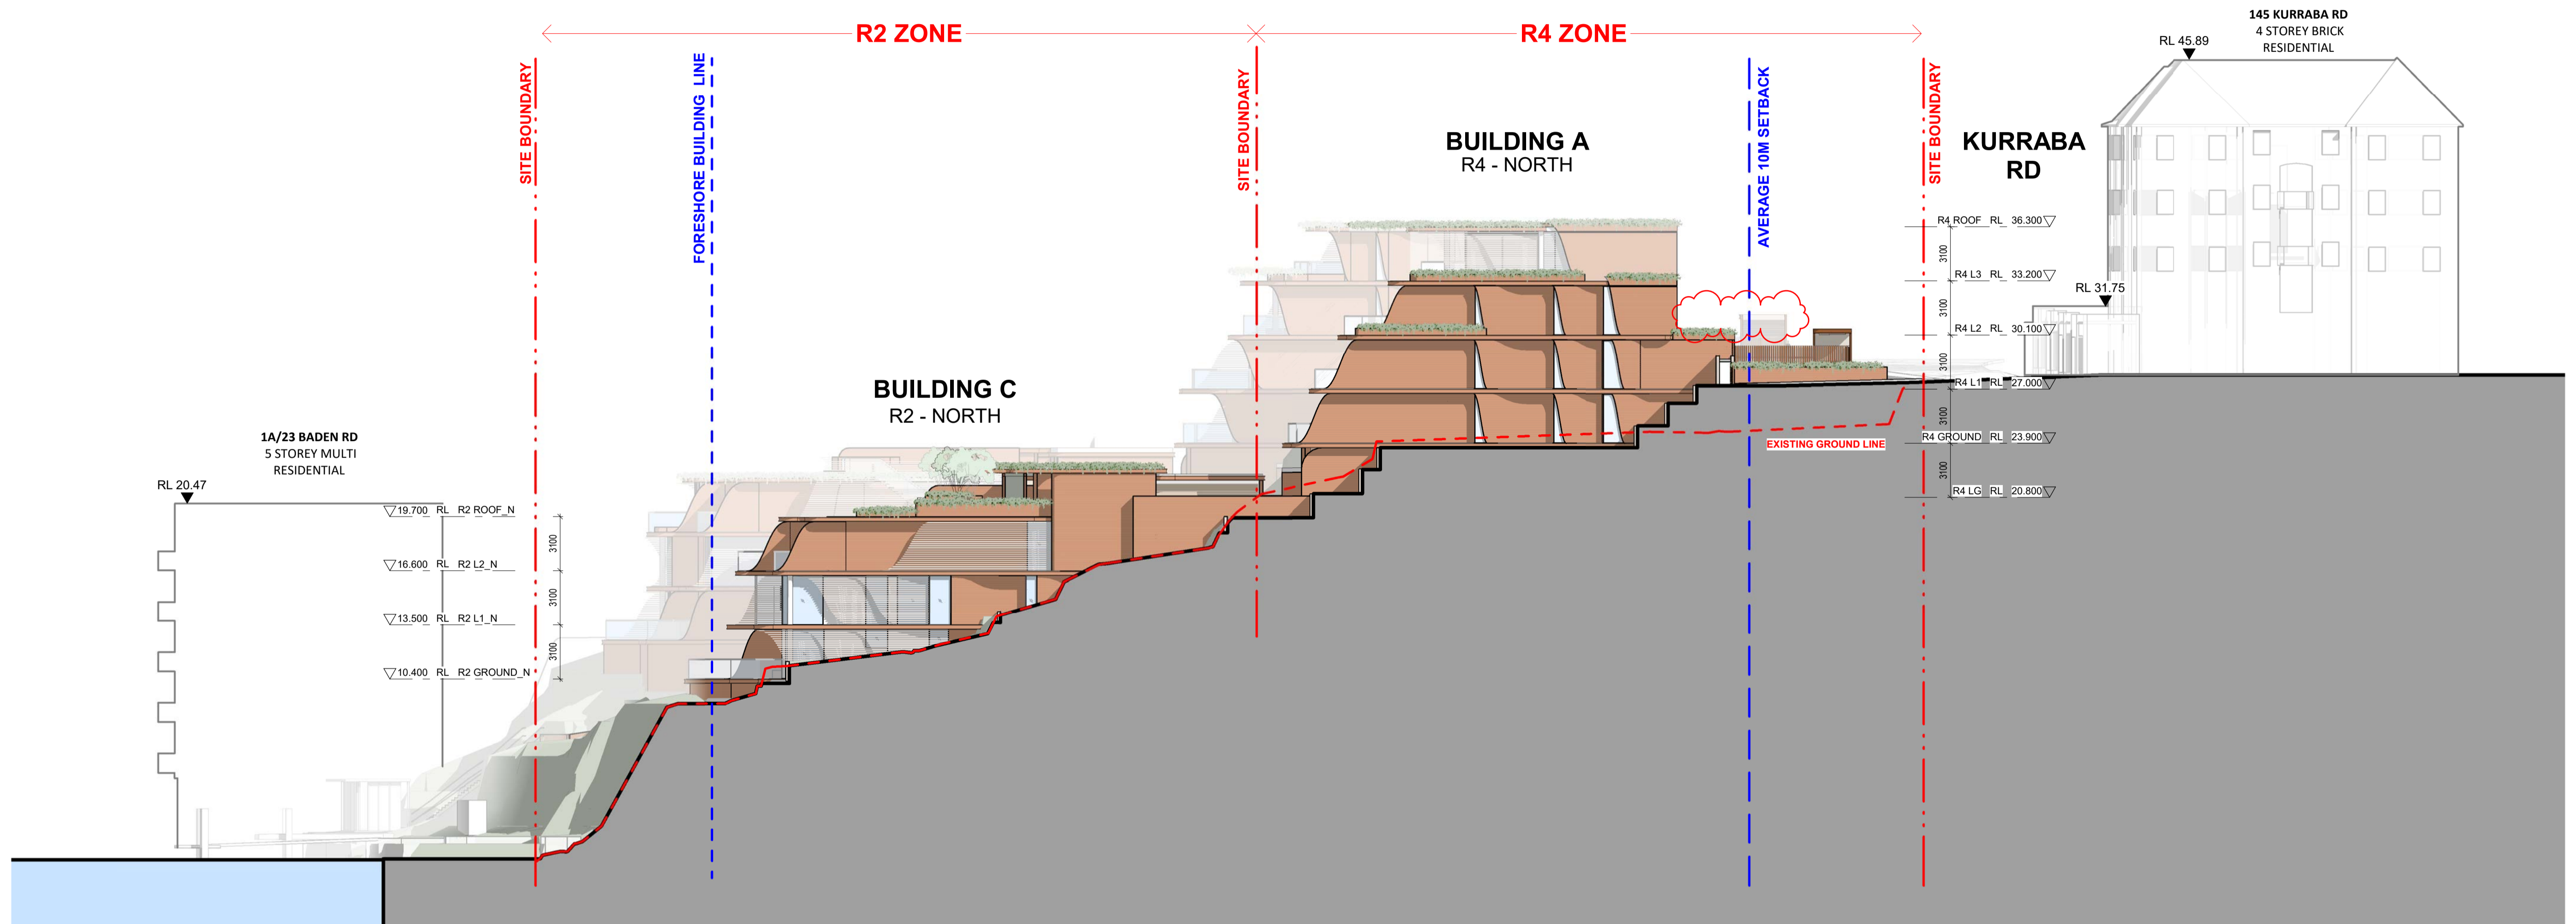

NO.	REVISION	BY	CHK	DATE
1	DA ISSUE	RPW	AG	08.06.2022
2	COUNCIL RFI COORDINATION ISSUE	ALDK	RPW	31.07.2023
3	COUNCIL RFI ISSUE	ALDK	RPW	15.08.2023
4	ISSUE FOR DA RESUBMISSION	AL	RPW	02.02.2024

REVISION NOTES:

KEY PLAN
CLOUD LEGEND
REVISION
ON HOLD

NOTES:
KOICHI TAKADA ARCHITECTS (KTA) RETAIN ALL COMMON LAW AND STATUTORY RIGHTS INCLUDING COPYRIGHT AND INTELLECTUAL PROPERTY RIGHTS TO THIS DOCUMENT.
THIS DOCUMENT MUST NOT BE EDITED, PARTIALLY EXTRACTED, REPRODUCED OR DISTRIBUTED IN ANY MANNER WITHOUT KTA'S EXPRESS WRITTEN CONSENT AND UNDER NO CIRCUMSTANCES SHALL THE TRANSFER OF THIS DOCUMENT BE DEEMED A SALE OR CONSTITUTE A TRANSFER OF ANY LICENCE TO USE THE DOCUMENT WITHOUT KTA'S KNOWLEDGE OR CONSENT.
THE PDF DOCUMENT STAMPED BY KTA AS A 'QA CONTROLLED DOCUMENT' IS THE ONLY OFFICIAL VERSION OF THIS DOCUMENT AND IS STRICTLY SUBJECT TO COPYRIGHT.
THE CONTENT AND ACCURACY OF THE DOCUMENT IS STRICTLY LIMITED TO THAT SHOWN IN THE QA CONTROLLED PDF.
DO NOT MEASURE FROM THE ELECTRONIC OR HARD COPY VERSIONS OF THIS DOCUMENT.
VERIFY ALL DIMENSIONS ON SITE BEFORE COMMENCING SHOP DRAWINGS, FABRICATION, CONSTRUCTION OR INSTALLATION.

OTHERS:

CLIENT
Kurraba Point Road Pty Ltd
430 TOORAK ROAD, TOORAK 3142

ARCHITECT
SUITE 41 & 42, LEVEL 4
61 MARLBOROUGH ST
SURRY HILLS, NSW 2010
T 02 9698 8510
ABN 63 131 365 896
NOMINATED ARCHITECT:
KOICHI TAKADA
NSW ARCHITECTS 6901
VIC ARCHITECTS 16179
QLD ARCHITECTS 5590
KOICHIKAKADA.COM

Koichi Takada Architects

GA STAMP

THIS DOCUMENT IS NOT SUITABLE OR APPROVED FOR CONSTRUCTION AT ANY TIME UNLESS KTA HAVE NOTATED THE STATUS TITLE AS FOR CONSTRUCTION WITHOUT THE PRESENCE OF 'WIP', 'DRAFT' OR ANY OTHER FORM OF QUALIFICATION ON THE DOCUMENT.

PROJECT
190 KURRABA RD
190 KURRABA RD, KURRABA POINT NSW
2089

STATUS
DEVELOPMENT APPLICATION - RFI 01

SCALE
1:200@A1, 1:400@A3

DWG TITLE
OVERALL NORTH ELEVATION

DWG NO.
A200

REVISION
4

DATE
02.02.2024

184B - 190 KURRABA ROAD,
KURRABA POINT NSW 2089



- R4 ROOF_RL 36.300▽
- R4 L3_RL 33.200▽
- R4 L2_RL 30.100▽
- R4 L1_RL 27.000▽
- R4 GROUND_RL 23.900▽
- R2 ROOF_S_RL 21.933▽
- R4 LG_RL 20.800▽
- R2 ROOF_N_RL 19.700▽
- R2 L2_S_RL 18.833▽
- R2 L2_N_RL 16.600▽
- R2 L1_S_RL 15.733▽
- R2 L1_N_RL 13.500▽
- R2 GROUND_S_RL 12.633▽
- R2 GROUND_N_RL 10.400▽

LEGEND	
AL 01	ALUMINIUM BATTEN
AS 01	LIGHT COLOUR ALU. SCREEN
BR 01	EARTH TONE RED BRICK
CN	CONCRETE
GL 01	CLEAR GLASS
GL 02	GLASS BALUSTRADE
RND 01	LIGHT COLOUR RENDER
RND 02	EARTH TONE COLOUR RENDER
ST 01	SANDSTONE CLADDING
ST 02	PAVING STONE

NO.	REVISION	BY	CHK	DATE	REVISION NOTES:
1	FOR INFORMATION			08.12.2021	
2	FOR INFORMATION			17.12.2021	
3	PRE-LODGE			20.01.2022	
4	COORDINATION ISSUE			09.02.2022	
5	ELEVATION REFERENCE ISSUE	RPW	AC	08.05.2022	
6	AMENDED COORDINATION ISSUE	AL	RPW	19.05.2022	
7	DA ISSUE	RPW	AC	08.06.2022	
8	COUNCIL RFI COORDINATION ISSUE	AL/CK	RPW	31.07.2023	
9	COUNCIL RFI ISSUE	AL/CK	RPW	15.08.2023	
10	ISSUE FOR DA RESUBMISSION	AL	RPW	02.02.2024	

KEY PLAN
CLOUD LEGEND
REVISION
ON HOLD

NOTES:
KOICHI TAKADA ARCHITECTS (KTA) RETAIN ALL COMMON LAW AND STATUTORY RIGHTS INCLUDING COPYRIGHT AND INTELLECTUAL PROPERTY RIGHTS TO THIS DOCUMENT.
THIS DOCUMENT MUST NOT BE EDITED, PARTIALLY EXTRACTED, REPRODUCED OR DISTRIBUTED IN ANY MANNER WITHOUT KTA'S EXPRESS WRITTEN CONSENT AND UNDER NO CIRCUMSTANCES SHALL THE TRANSFER OF THIS DOCUMENT BE DEEMED A SALE OR CONSTITUTE A TRANSFER OF ANY LICENCE TO USE THE DOCUMENT WITHOUT KTA'S KNOWLEDGE OR CONSENT.
THIS DOCUMENT IS THE ONLY OFFICIAL VERSION OF THIS DOCUMENT AND IS STRICTLY SUBJECT TO COPYRIGHT.
THE CONTENT AND ACCURACY OF THIS DOCUMENT IS STRICTLY LIMITED TO THAT SHOWN IN THE DA CONTROLLED PDF.
DO NOT MEASURE FROM THE ELECTRONIC OR HARD COPY VERSIONS OF THIS DOCUMENT.
VERIFY ALL DIMENSIONS ON SITE BEFORE COMMENCING SHOP DRAWINGS, FABRICATION, CONSTRUCTION OR INSTALLATION.

CLIENT
Kurraba Point Road Pty Ltd
430 TOORAK ROAD, TOORAK 3142

ARCHITECT
SUITE 41 & 42, LEVEL 4
61 MARLBOROUGH ST
SURRY HILLS, NSW 2010
T 02 9698 8510
ASN 63 131 365 896
NOMINATED ARCHITECT:
KOICHI TAKADA
NSW ARCHITECTS 6901
VIC ARCHITECTS 16179
QLD ARCHITECTS 5590
KOICHI TAKADA.COM

Koichi Takada Architects

GA STAMP

THIS DOCUMENT IS NOT SUITABLE OR APPROVED FOR CONSTRUCTION AT ANY TIME UNLESS KTA HAVE NOTATED THE STATUS TITLE AS FOR CONSTRUCTION WITHOUT THE PRESENCE OF 'WIP', 'DRAFT' OR ANY OTHER FORM OF QUALIFICATION ON THE DOCUMENT.

PROJECT
190 KURRABA RD
190 KURRABA RD, KURRABA POINT NSW 2089

STATUS
DEVELOPMENT APPLICATION - RFI 01

DWG TITLE
ELEVATION - EAST

DWG NO.
A201

SCALE
1:100@A1, 1:200@A3

REVISION	DATE
10	02.02.2024

184B - 190 KURRABA ROAD,
KURRABA POINT NSW 2089

R2 ZONE

R4 ZONE

FORESHORE BUILDING LINE

SITE BOUNDARY

AVERAGE 10M SETBACK


SITE BOUNDARY

BUILDING B (BEYOND)
R4 - SOUTH

BUILDING A
R4 - NORTH

BUILDING D (BEYOND)
R2 - SOUTH

BUILDING C
R2 - NORTH

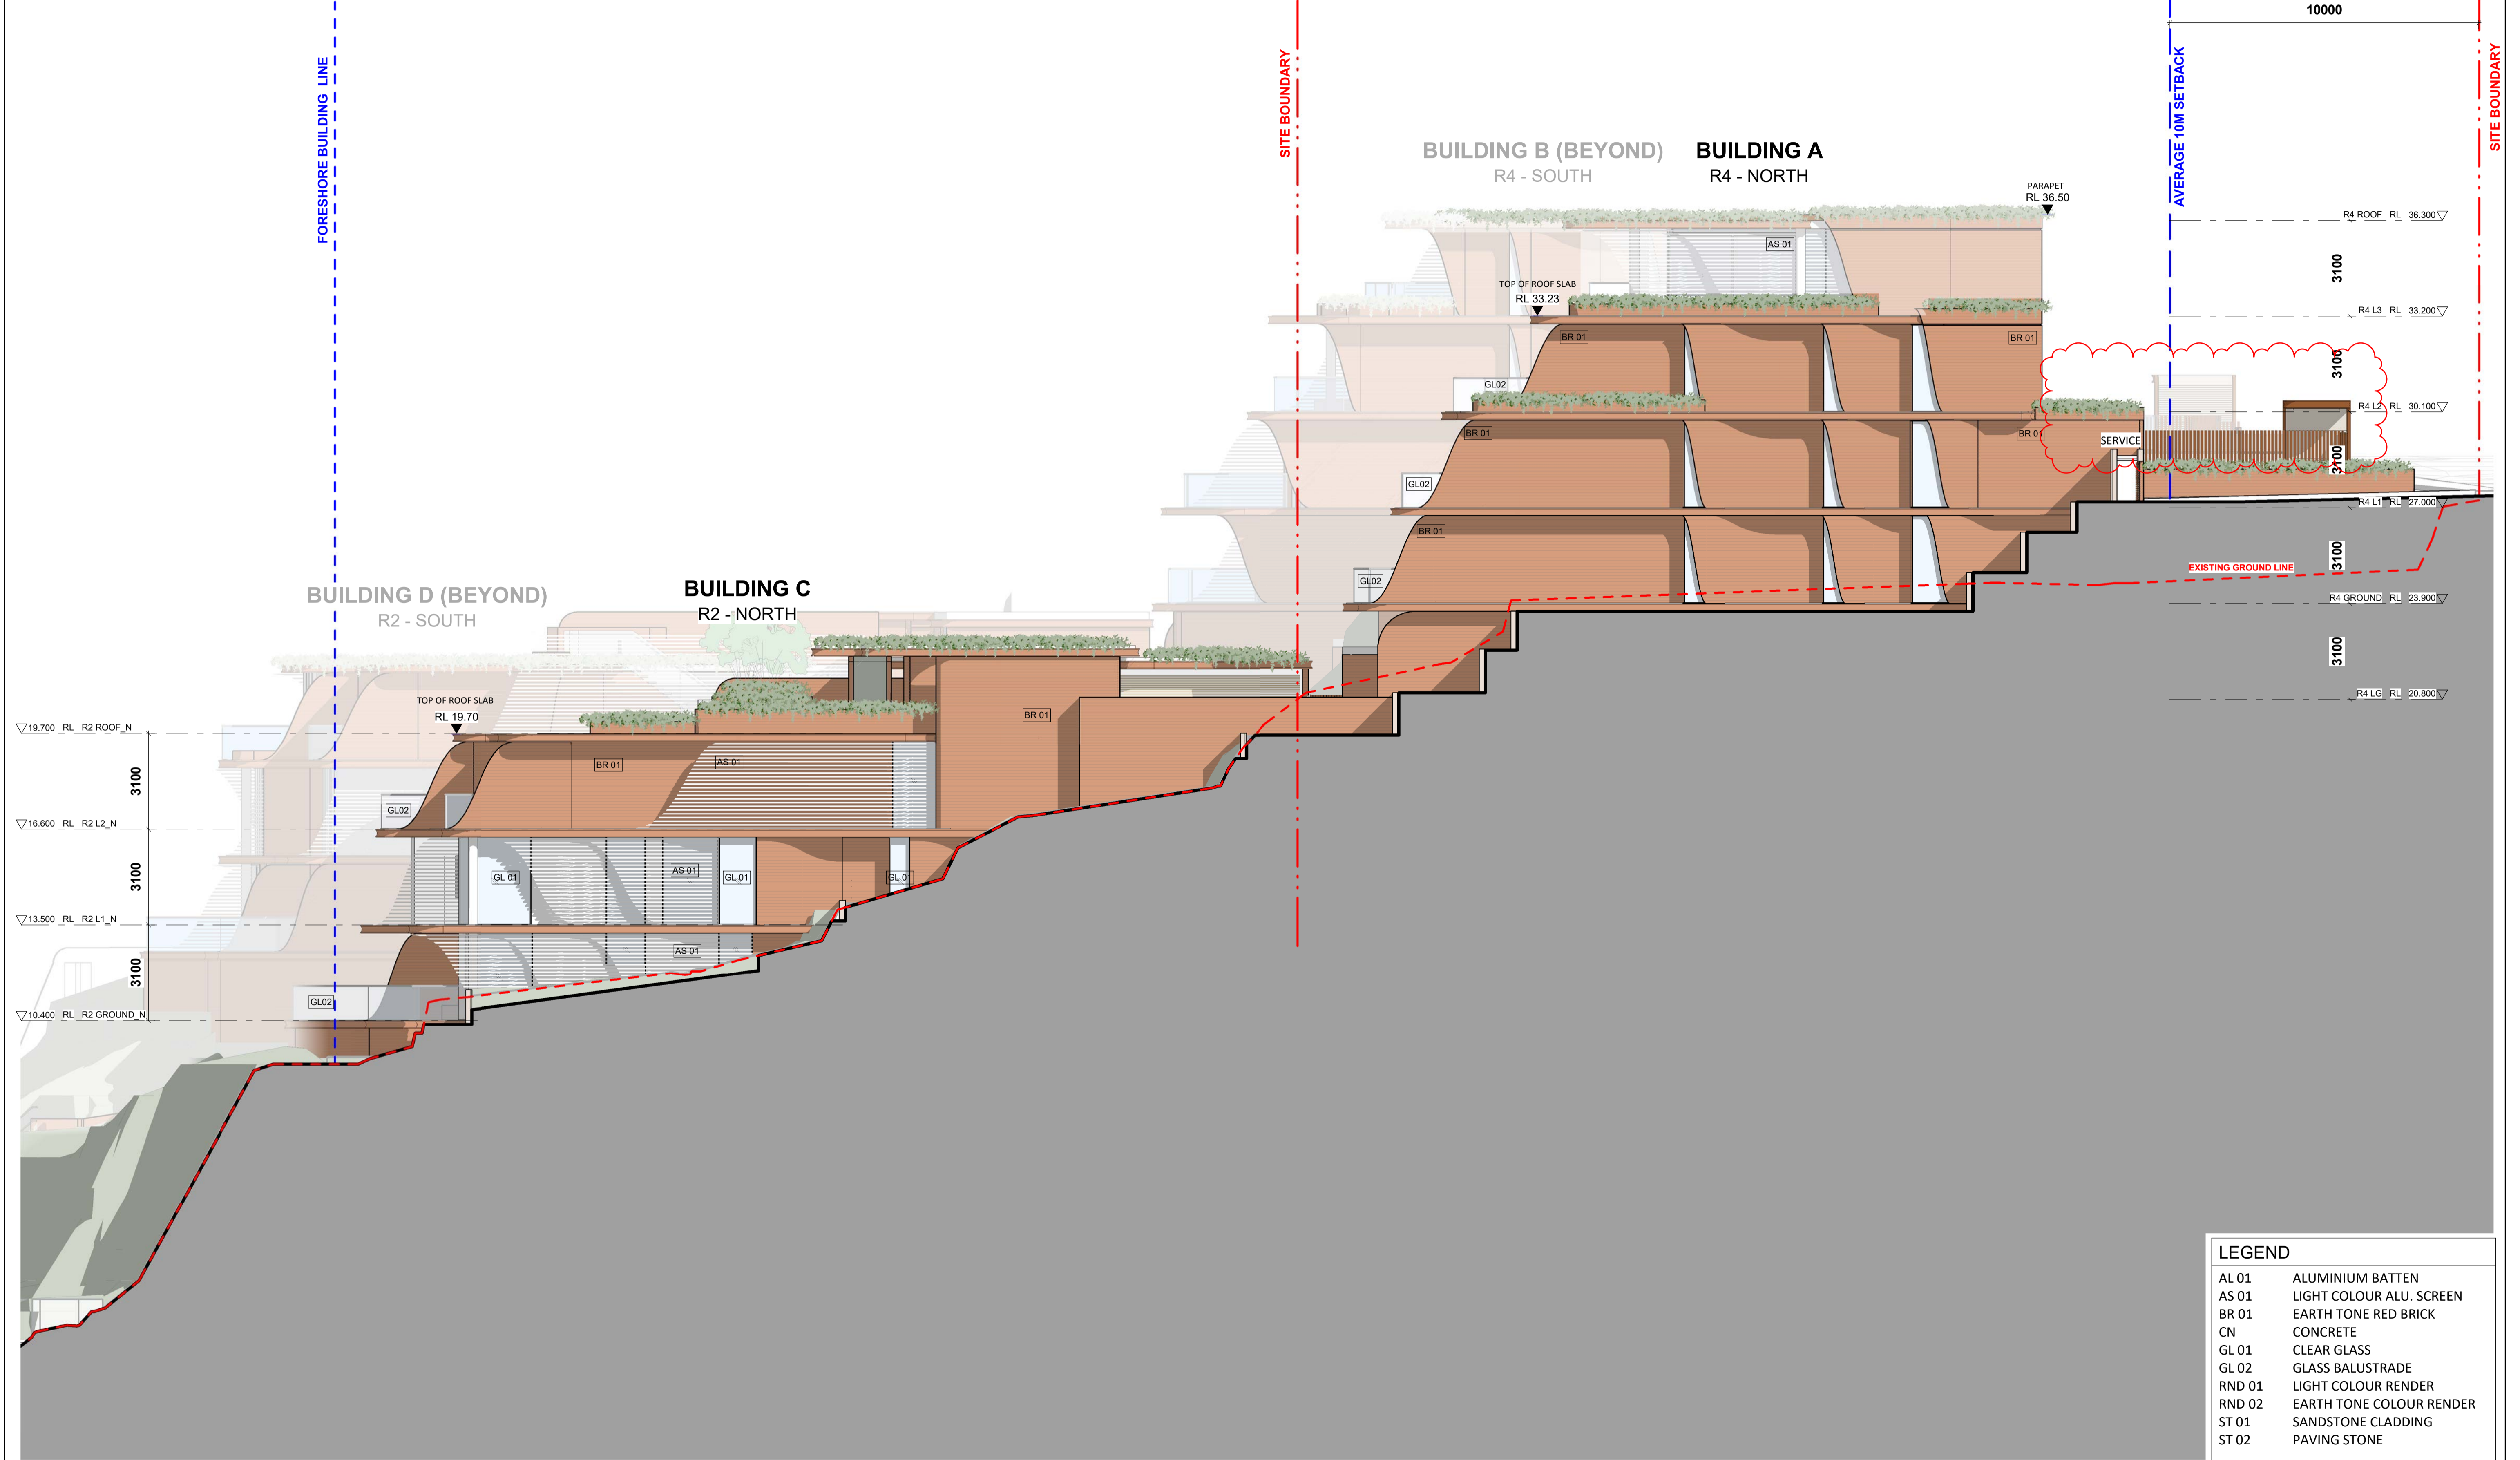

LEGEND	
AL 01	ALUMINIUM BATTEN
AS 01	LIGHT COLOUR ALU. SCREEN
BR 01	EARTH TONE RED BRICK
CN	CONCRETE
GL 01	CLEAR GLASS
GL 02	GLASS BALUSTRADE
RND 01	LIGHT COLOUR RENDER
RND 02	EARTH TONE COLOUR RENDER
ST 01	SANDSTONE CLADDING
ST 02	PAVING STONE

NO.	REVISION	BY	CHK	DATE	REVISION NOTES:
1	FOR INFORMATION			08.12.2021	
2	FOR INFORMATION			17.12.2021	
3	PRE-LODGE			20.01.2022	
4	COORDINATION ISSUE			09.02.2022	
5	ELEVATION REFERENCE ISSUE	RPW	AC	08.05.2022	
6	AMENDED COORDINATION ISSUE	AL	RPW	19.05.2022	
7	DA ISSUE	RPW	AC	08.06.2022	
8	COUNCIL RFI COORDINATION ISSUE	AL/CK	RPW	31.07.2023	
9	COUNCIL RFI ISSUE	AL/CK	RPW	15.08.2023	
10	ISSUE FOR DA RESUBMISSION	AL	RPW	02.02.2024	

KEY PLAN
CLOUD LEGEND
REVISION
ON HOLD

NOTES:
KOICHI TAKADA ARCHITECTS (KTA) RETAIN ALL COMMON LAW AND STATUTORY RIGHTS INCLUDING COPYRIGHT AND INTELLECTUAL PROPERTY RIGHTS TO THIS DOCUMENT.
THIS DOCUMENT MUST NOT BE EDITED, PARTIALLY EXTRACTED, REPRODUCED OR DISTRIBUTED IN ANY MANNER WITHOUT KTA'S EXPRESS WRITTEN CONSENT AND UNDER NO CIRCUMSTANCES SHALL THE TRANSFER OF THIS DOCUMENT BE DEEMED A SALE OR CONSTITUTE A TRANSFER OF ANY LICENCE TO USE THE DOCUMENT WITHOUT KTA'S KNOWLEDGE OR CONSENT.
THE PDF DOCUMENT STAMPED BY KTA AS A 'QA CONTROLLED DOCUMENT' IS THE ONLY OFFICIAL VERSION OF THIS DOCUMENT AND IS STRICTLY SUBJECT TO COPYRIGHT ©.
THE CONTENT AND ACCURACY OF THE DOCUMENT IS STRICTLY LIMITED TO THAT DEPICTED IN THE 'QA CONTROLLED PDF'. DO NOT MEASURE FROM THE ELECTRONIC OR HARD COPY VERSIONS OF THIS DOCUMENT.
VERIFY ALL DIMENSIONS ON SITE BEFORE COMMENCING SHOP DRAWINGS, FABRICATION, CONSTRUCTION OR INSTALLATION.

CLIENT
Kurraba Point Road Pty Ltd
430 TOORAK ROAD, TOORAK 3142

ARCHITECT
SUITE 41 & 42, LEVEL 4
61 MARLBOROUGH ST
SURRY HILLS, NSW 2010
T 02 9698 8510
ABN 63 131 365 896
NOMINATED ARCHITECT:
KOICHI TAKADA
NSW ARCHITECTS 6901
VIC ARCHITECTS 16179
QLD ARCHITECTS 5590
KOICHI TAKADA.COM

Koichi Takada Architects

PROJECT
190 KURRABA RD
190 KURRABA RD, KURRABA POINT NSW
2089

STATUS
DEVELOPMENT APPLICATION - RFI 01


SCALE
1:100@A1, 1:200@A3

DWG TITLE	REVISION	DATE
ELEVATION - NORTH	10	02.02.2024

184B - 190 KURRABA ROAD,
KURRABA POINT NSW 2089

R4 ZONE

R2 ZONE

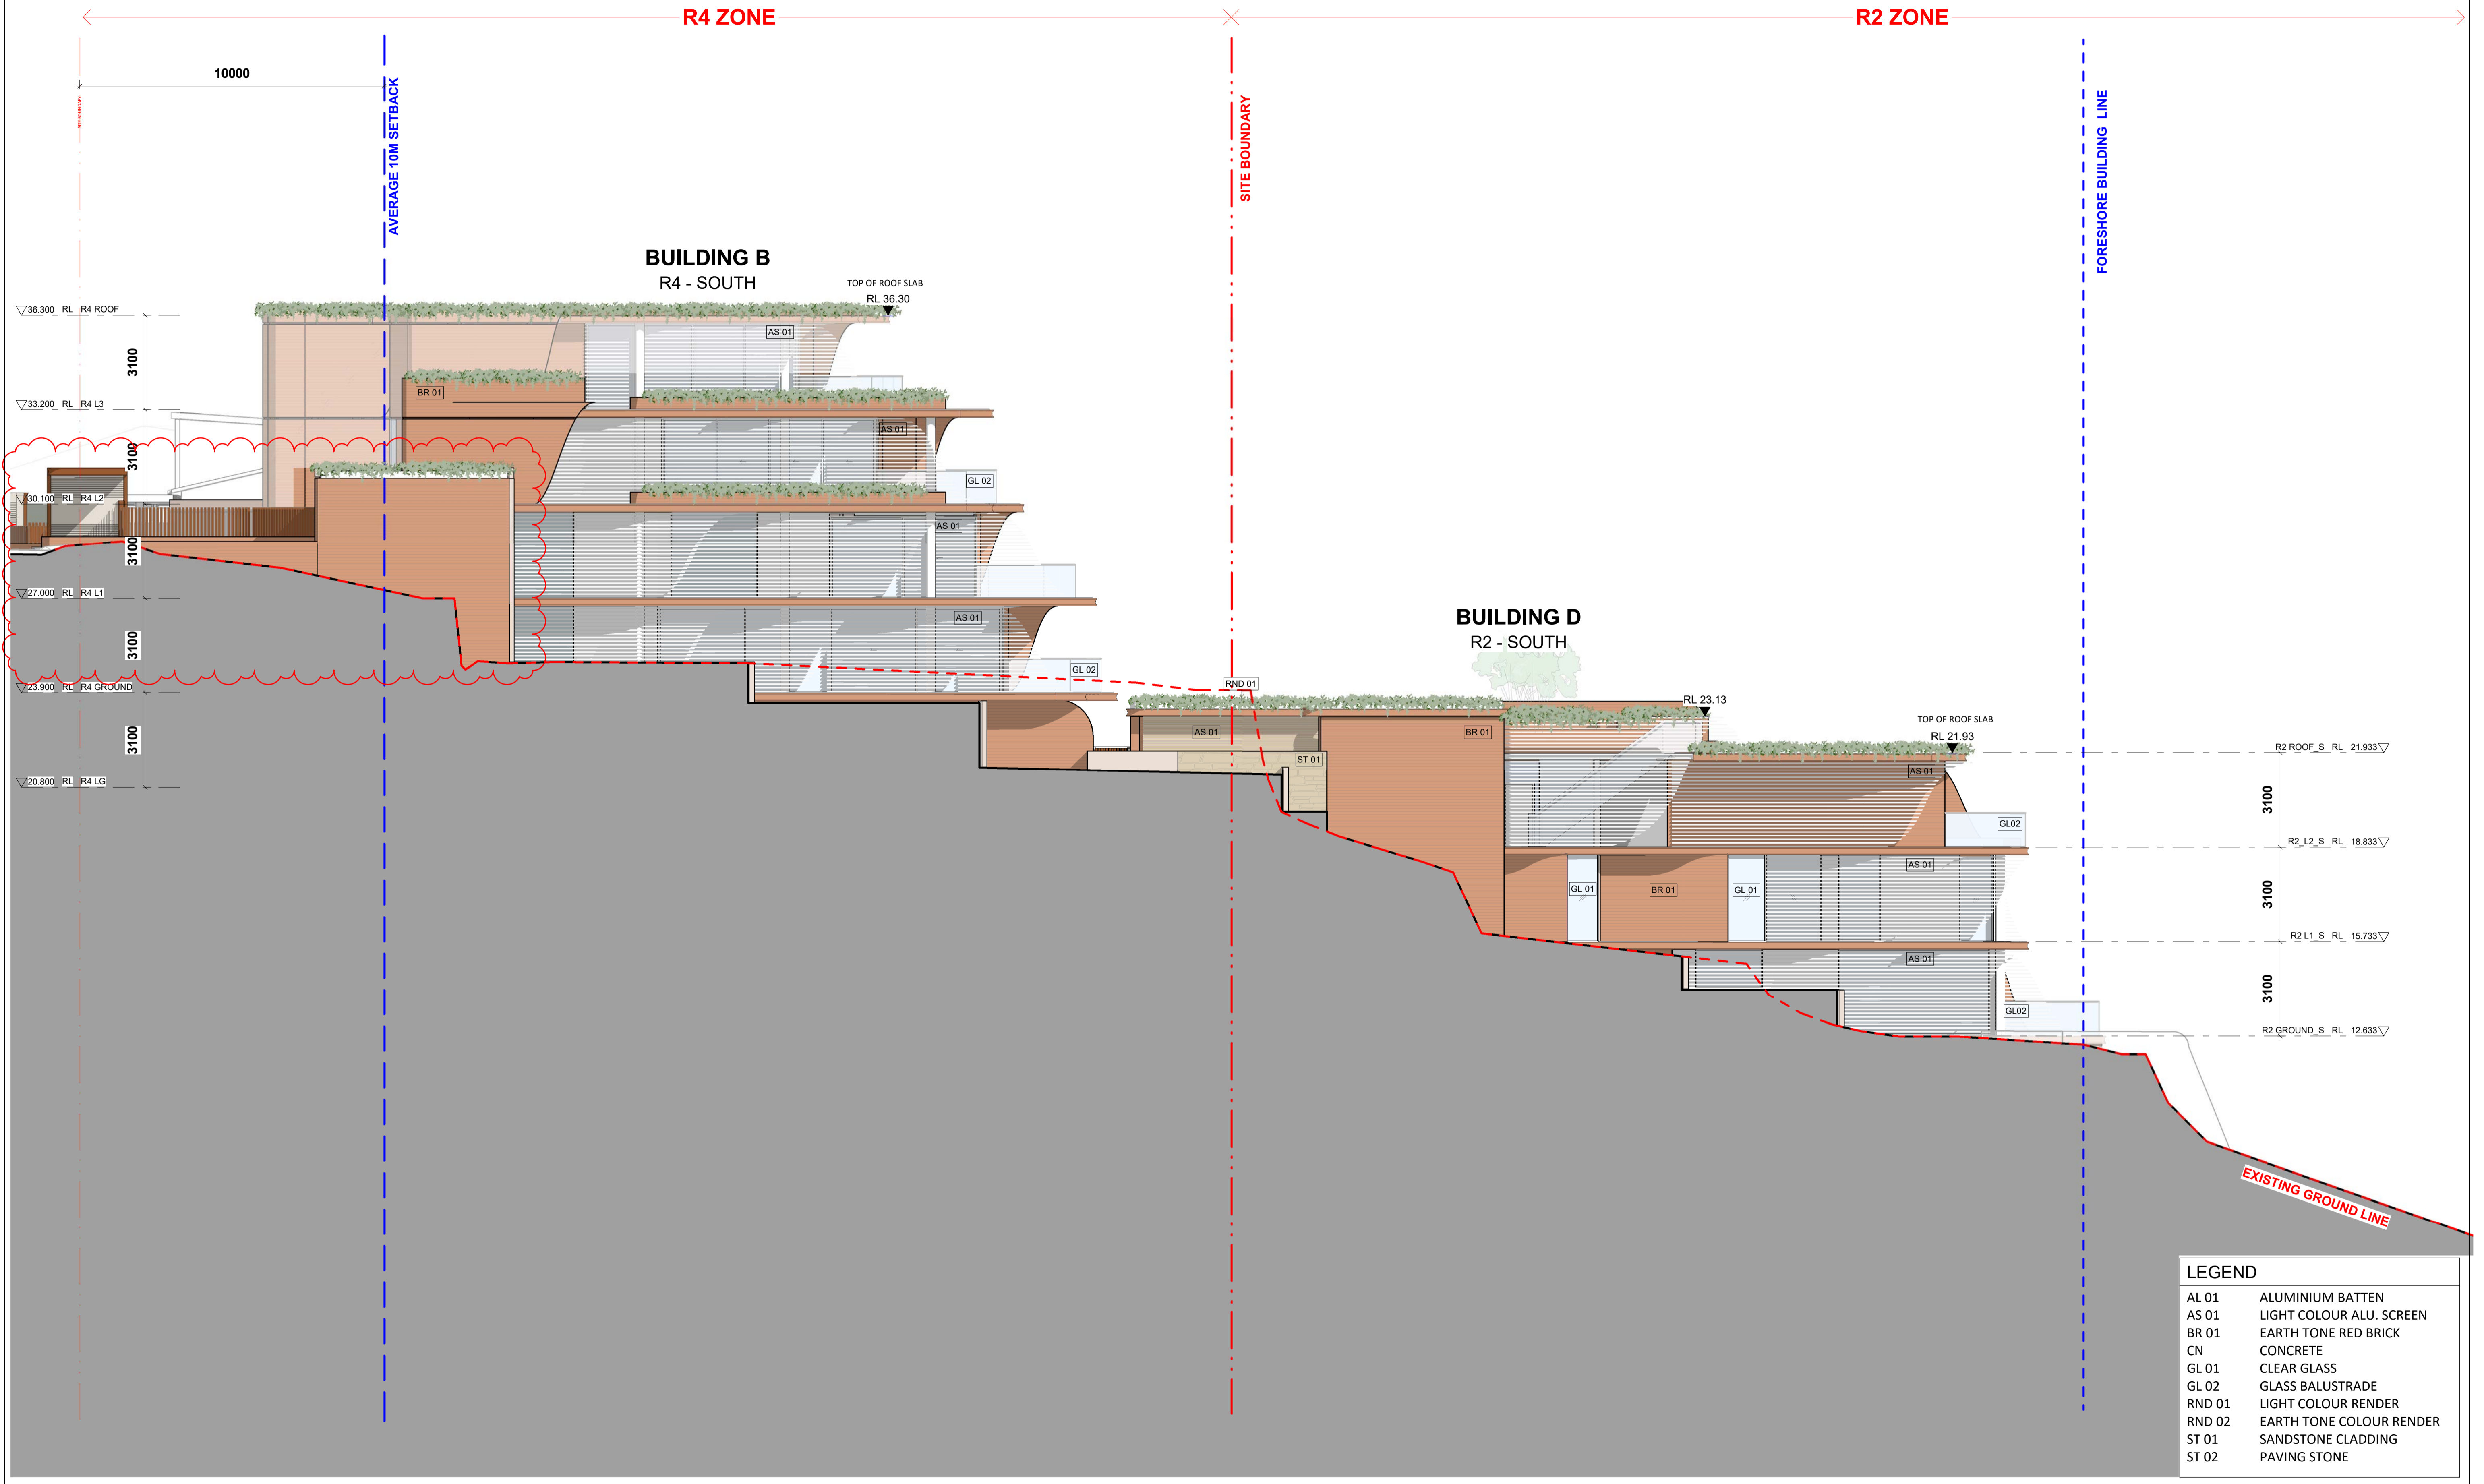

LEGEND	
AL 01	ALUMINIUM BATTEN
AS 01	LIGHT COLOUR ALU. SCREEN
BR 01	EARTH TONE RED BRICK
CN	CONCRETE
GL 01	CLEAR GLASS
GL 02	GLASS BALUSTRADE
RND 01	LIGHT COLOUR RENDER
RND 02	EARTH TONE COLOUR RENDER
ST 01	SANDSTONE CLADDING
ST 02	PAVING STONE

NO.	REVISION	BY	CHK	DATE	REVISION NOTES:
1	FOR INFORMATION			08.12.2021	
2	FOR INFORMATION			17.12.2021	
3	PRE LODGEMENT			20.01.2022	
4	COORDINATION ISSUE			09.02.2022	
5	ELEVATION REFERENCE ISSUE	RPW	AC	08.05.2022	
6	AMENDED COORDINATION ISSUE	AL	RPW	19.05.2022	
7	DA ISSUE	RPW	AC	08.06.2022	
8	COUNCIL RFI COORDINATION ISSUE	AL/CK	RPW	31.07.2023	
9	COUNCIL RFI ISSUE	AL/CK	RPW	15.08.2023	
10	ISSUE FOR DA RESUBMISSION	AL	RPW	02.02.2024	

KEY PLAN
CLOUD LEGEND
REVISION
ON HOLD

NOTES:
KOICHI TAKADA ARCHITECTS (KTA) RETAIN ALL COMMON LAW AND STATUTORY RIGHTS INCLUDING COPYRIGHT AND INTELLECTUAL PROPERTY RIGHTS TO THIS DOCUMENT.
THIS DOCUMENT MUST NOT BE EDITED, PARTIALLY EXTRACTED, REPRODUCED OR DISTRIBUTED IN ANY MANNER WITHOUT KTA'S EXPRESS WRITTEN CONSENT AND UNDER NO CIRCUMSTANCES SHALL THE TRANSFER OF THIS DOCUMENT BE DEEMED A SALE OR CONSTITUTE A TRANSFER OF ANY LICENCE TO USE THE DOCUMENT WITHOUT KTA'S KNOWLEDGE OR CONSENT.
THE PDF DOCUMENT STAMPED BY KTA AS A QA CONTROLLED DOCUMENT IS THE ONLY OFFICIAL VERSION OF THIS DOCUMENT AND IS STRICTLY SUBJECT TO COPYRIGHT ©.
THE CONTENT AND ACCURACY OF THE DOCUMENT IS STRICTLY LIMITED TO THAT DEPICTED IN THE QA CONTROLLED PDF. DO NOT MEASURE FROM THE ELECTRONIC OR HARD COPY VERSIONS OF THIS DOCUMENT.
VERIFY ALL DIMENSIONS ON SITE BEFORE COMMENCING SHOP DRAWINGS, FABRICATION, CONSTRUCTION OR INSTALLATION.

CLIENT
Kurraba Point Road Pty Ltd
430 TOORAK ROAD, TOORAK 3142

ARCHITECT
SUITE 41 & 42, LEVEL 4
61 MARLBOROUGH ST
SURRY HILLS, NSW 2010
T 02 9698 8510
ASN 63 131 365 896
NOMINATED ARCHITECT:
KOICHI TAKADA
NSW ARCHITECTS 6901
VIC ARCHITECTS 16179
QLD ARCHITECTS 5590
KOICHI TAKADA.COM


Koichi Takada Architects

THIS DOCUMENT IS NOT SUITABLE OR APPROVED FOR CONSTRUCTION AT ANY TIME UNLESS KTA HAVE NOTATED THE STATUS TITLE AS FOR CONSTRUCTION WITHOUT THE PRESENCE OF 'WIP', 'DRAFT' OR ANY OTHER FORM OF QUALIFICATION ON THE DOCUMENT.

PROJECT	DWG TITLE
190 KURRABA RD 190 KURRABA RD, KURRABA POINT NSW 2089	ELEVATION - SOUTH
STATUS DEVELOPMENT APPLICATION - RFI 01	DWG NO. A203
SCALE 1:100@A1, 1:200@A3	REVISION 10
DATE 02.02.2024	

GA STAMP	PROJECT	DWG TITLE
	190 KURRABA RD 190 KURRABA RD, KURRABA POINT NSW 2089	ELEVATION - SOUTH
	STATUS DEVELOPMENT APPLICATION - RFI 01	DWG NO. A203
	SCALE 1:100@A1, 1:200@A3	REVISION 10
	DATE 02.02.2024	

184B - 190 KURRABA ROAD,
KURRABA POINT NSW 2089

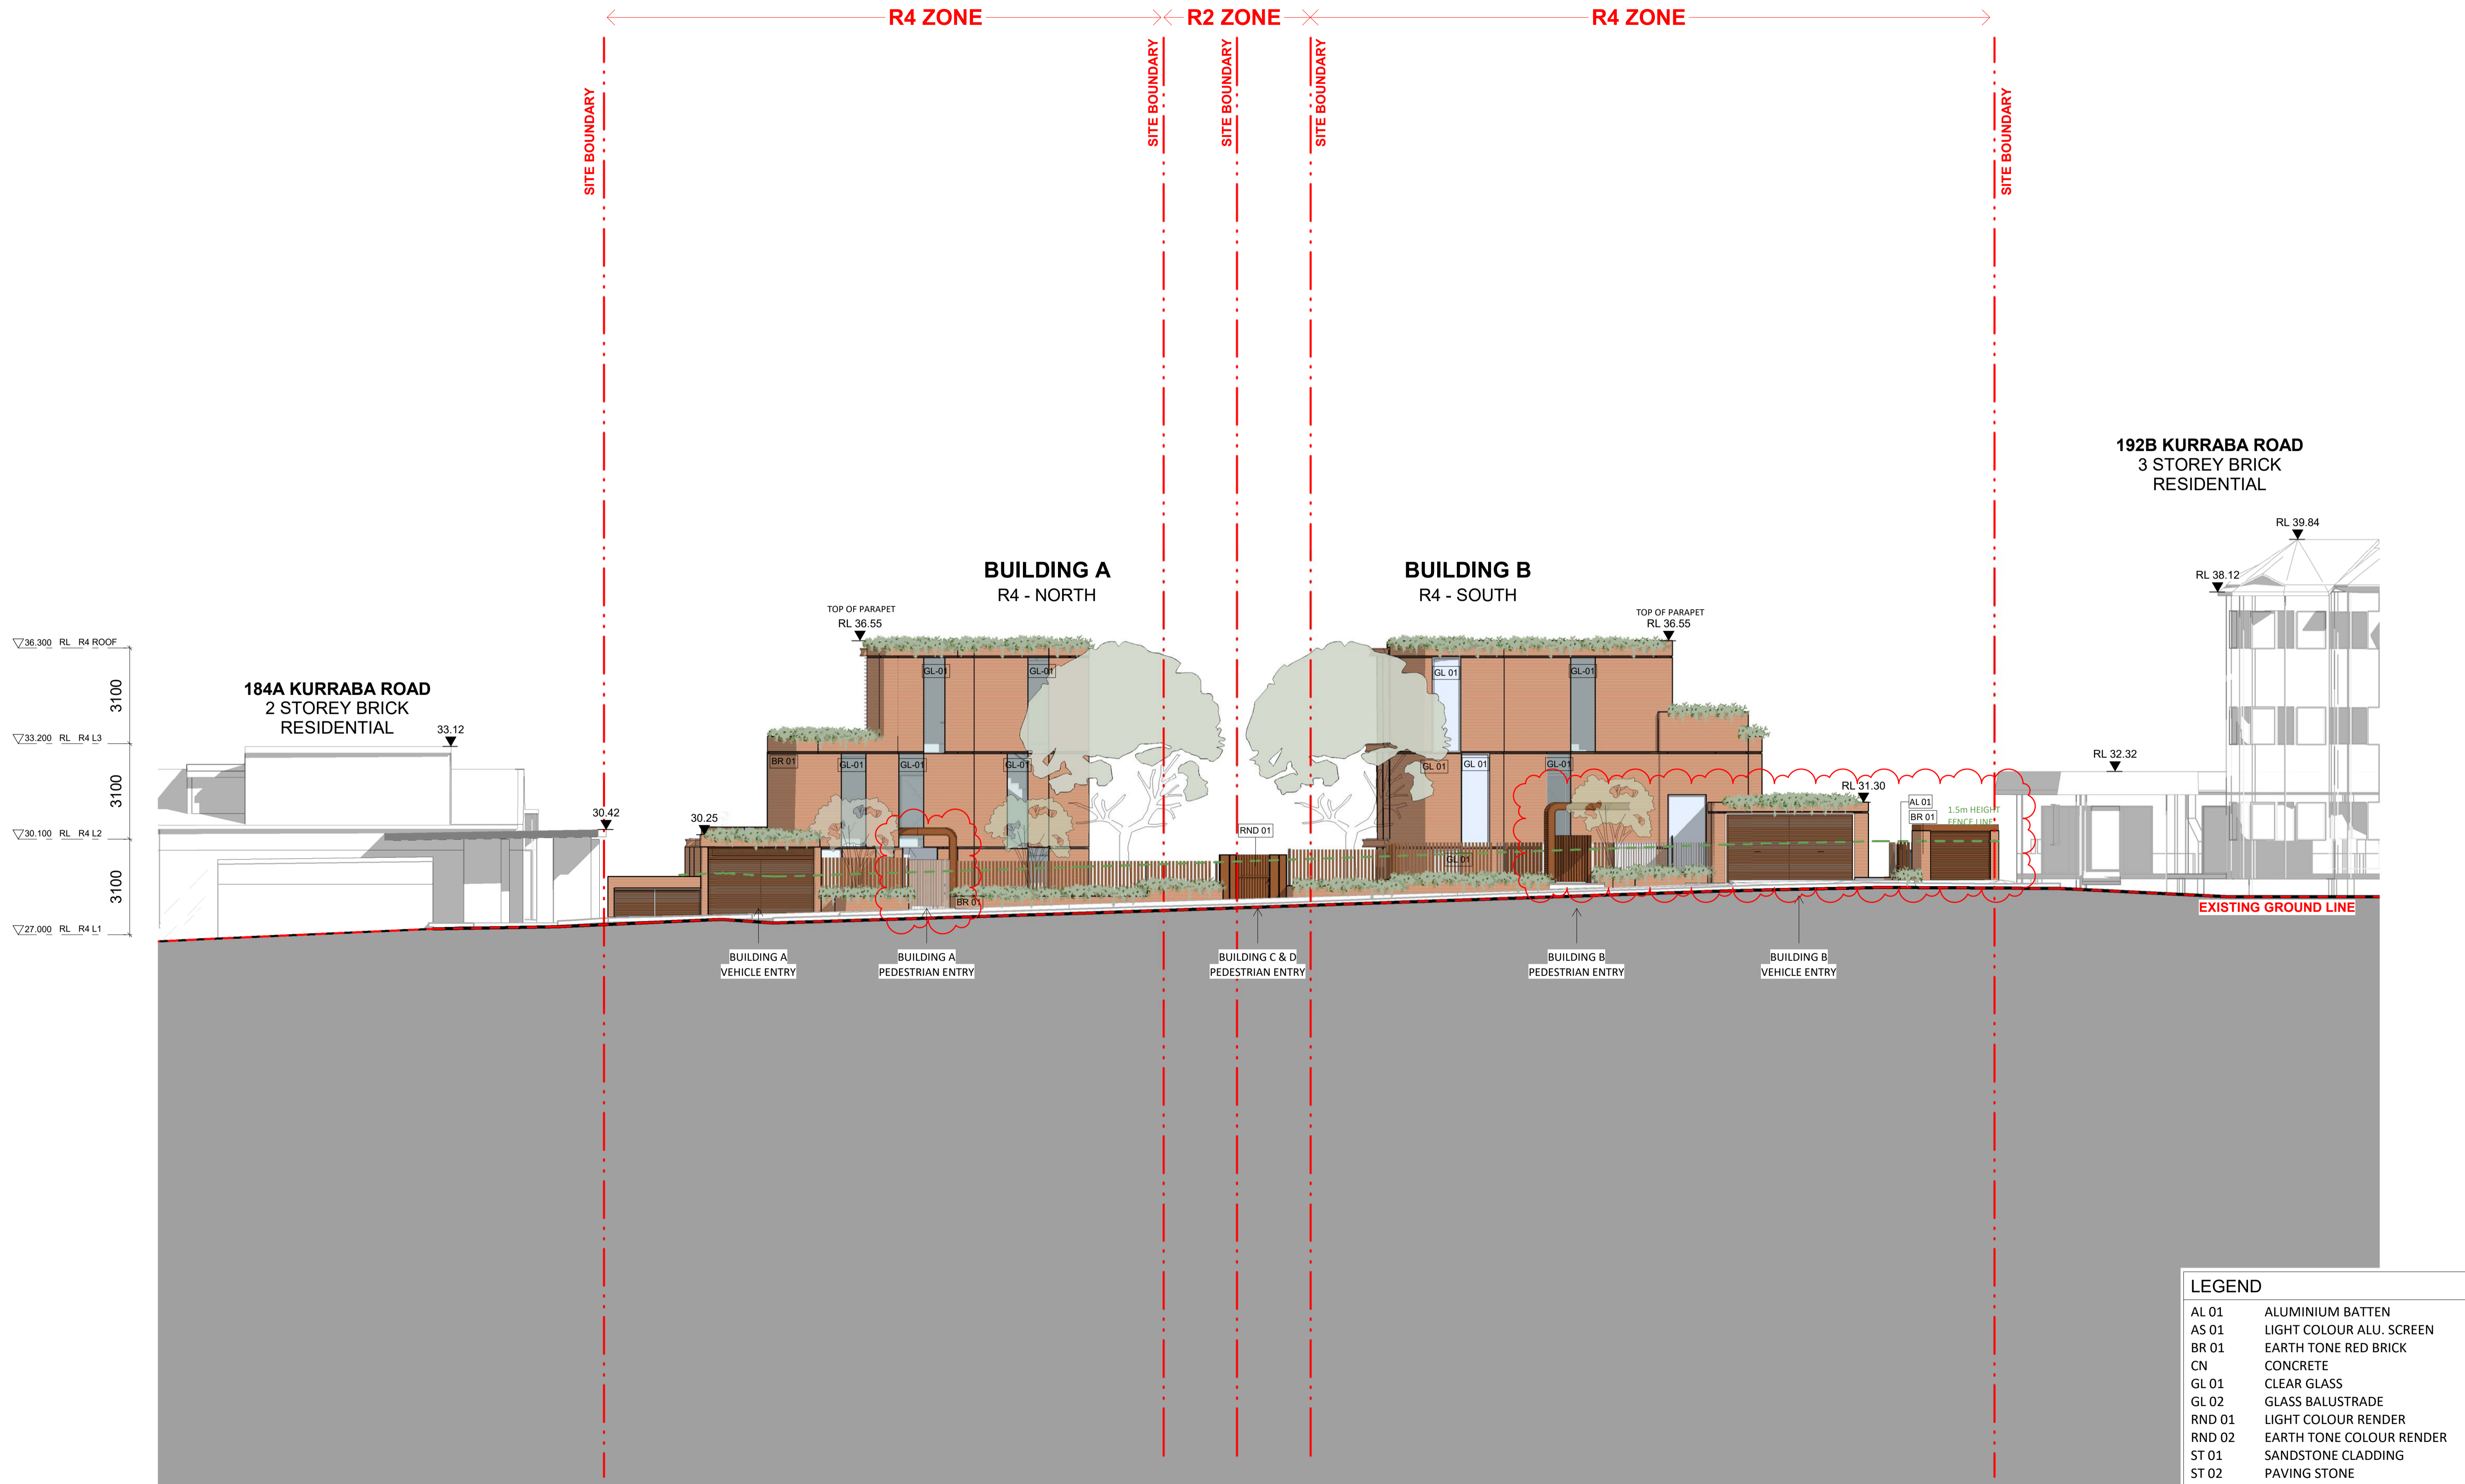

192B KURRABA ROAD
3 STOREY BRICK
RESIDENTIAL

184A KURRABA ROAD
2 STOREY BRICK
RESIDENTIAL

BUILDING A
R4 - NORTH

BUILDING B
R4 - SOUTH

LEGEND

AL 01	ALUMINIUM BATTEN
AS 01	LIGHT COLOUR ALU. SCREEN
BR 01	EARTH TONE RED BRICK
CN	CONCRETE
GL 01	CLEAR GLASS
GL 02	GLASS BALUSTRADE
RND 01	LIGHT COLOUR RENDER
RND 02	EARTH TONE COLOUR RENDER
ST 01	SANDSTONE CLADDING
ST 02	PAVING STONE

NO.	REVISION	BY	CHK	DATE	REVISION NOTES:
1	FOR INFORMATION			08.12.2021	
2	FOR INFORMATION			17.12.2021	
3	PRE-LODGE			20.01.2022	
4	COORDINATION ISSUE			09.02.2022	
5	COORDINATION ISSUE			18.03.2022	
6	ELEVATION REFERENCE ISSUE	RPW	AC	05.05.2022	
7	AMENDED COORDINATION ISSUE	AL	RPW	19.05.2022	
8	DA ISSUE	RPW	AC	08.06.2022	
9	COUNCIL RFI COORDINATION ISSUE	AL/CK	RPW	31.07.2023	
10	COUNCIL RFI ISSUE	AL/CK	RPW	15.08.2023	
11	ISSUE FOR DA RESUBMISSION	AL	RPW	02.02.2024	

KEY PLAN

CLOUD LEGEND

REVISION

ON HOLD

NOTES:
KOICHI TAKADA ARCHITECTS (KTA) RETAIN ALL COMMON LAW AND STATUTORY RIGHTS INCLUDING COPYRIGHT AND INTELLECTUAL PROPERTY RIGHTS TO THIS DOCUMENT. THIS DOCUMENT MUST NOT BE EDITED, PARTIALLY EXTRACTED, REPRODUCED OR DISTRIBUTED IN ANY MANNER WITHOUT KTA'S EXPRESS WRITTEN CONSENT AND UNDER NO CIRCUMSTANCES SHALL THE TRANSFER OF THIS DOCUMENT BE DEEMED A SALE OR CONSTITUTE A TRANSFER OF ANY LICENCE TO USE THE DOCUMENT. THE PDF DOCUMENT STAMPED BY KTA AS A 'QA CONTROLLED DOCUMENT' IS THE ONLY OFFICIAL VERSION OF THIS DOCUMENT AND IS STRICTLY SUBJECT TO COPYRIGHT ©. THE CONTENT AND ACCURACY OF THE DOCUMENT IS STRICTLY LIMITED TO THAT DEPICTED IN THE QA CONTROLLED PDF. DO NOT MEASURE FROM THE ELECTRONIC OR HARD COPY VERSIONS OF THIS DOCUMENT. VERIFY ALL DIMENSIONS ON SITE BEFORE COMMENCING SHOP DRAWINGS, FABRICATION, CONSTRUCTION OR INSTALLATION.

CLIENT
Kurraba Point Road Pty Ltd
430 TOORAK ROAD, TOORAK 3142

ARCHITECT
SUITE 41 & 42, LEVEL 4
61 MARLBOROUGH ST
SURRY HILLS, NSW 2010
T 02 9698 8510
ASN 63 131 365 696
NOMINATED ARCHITECT:
KOICHI TAKADA
NSW ARCHITECTS 6901
VIC ARCHITECTS 16179
QLD ARCHITECTS 5590
KOICHI TAKADA.COM

Koichi Takada Architects

PROJECT
190 KURRABA RD
190 KURRABA RD, KURRABA POINT NSW
2089

STATUS
DEVELOPMENT APPLICATION - RFI 01

GA STAMP

THIS DOCUMENT IS NOT SUITABLE OR APPROVED FOR CONSTRUCTION AT ANY TIME UNLESS KTA HAVE NOTATED THE STATUS TITLE AS FOR CONSTRUCTION WITHOUT THE PRESENCE OF 'WIP', 'DRAFT' OR ANY OTHER FORM OF QUALIFICATION ON THE DOCUMENT.

DWG TITLE
ELEVATION - WEST

DWG NO.
A204

SCALE
1:100@A1, 1:200@A3


REVISION
11

DATE
02.02.2024

184B - 190 KURRABA ROAD,
KURRABA POINT NSW 2089

R4 ZONE

R2 ZONE

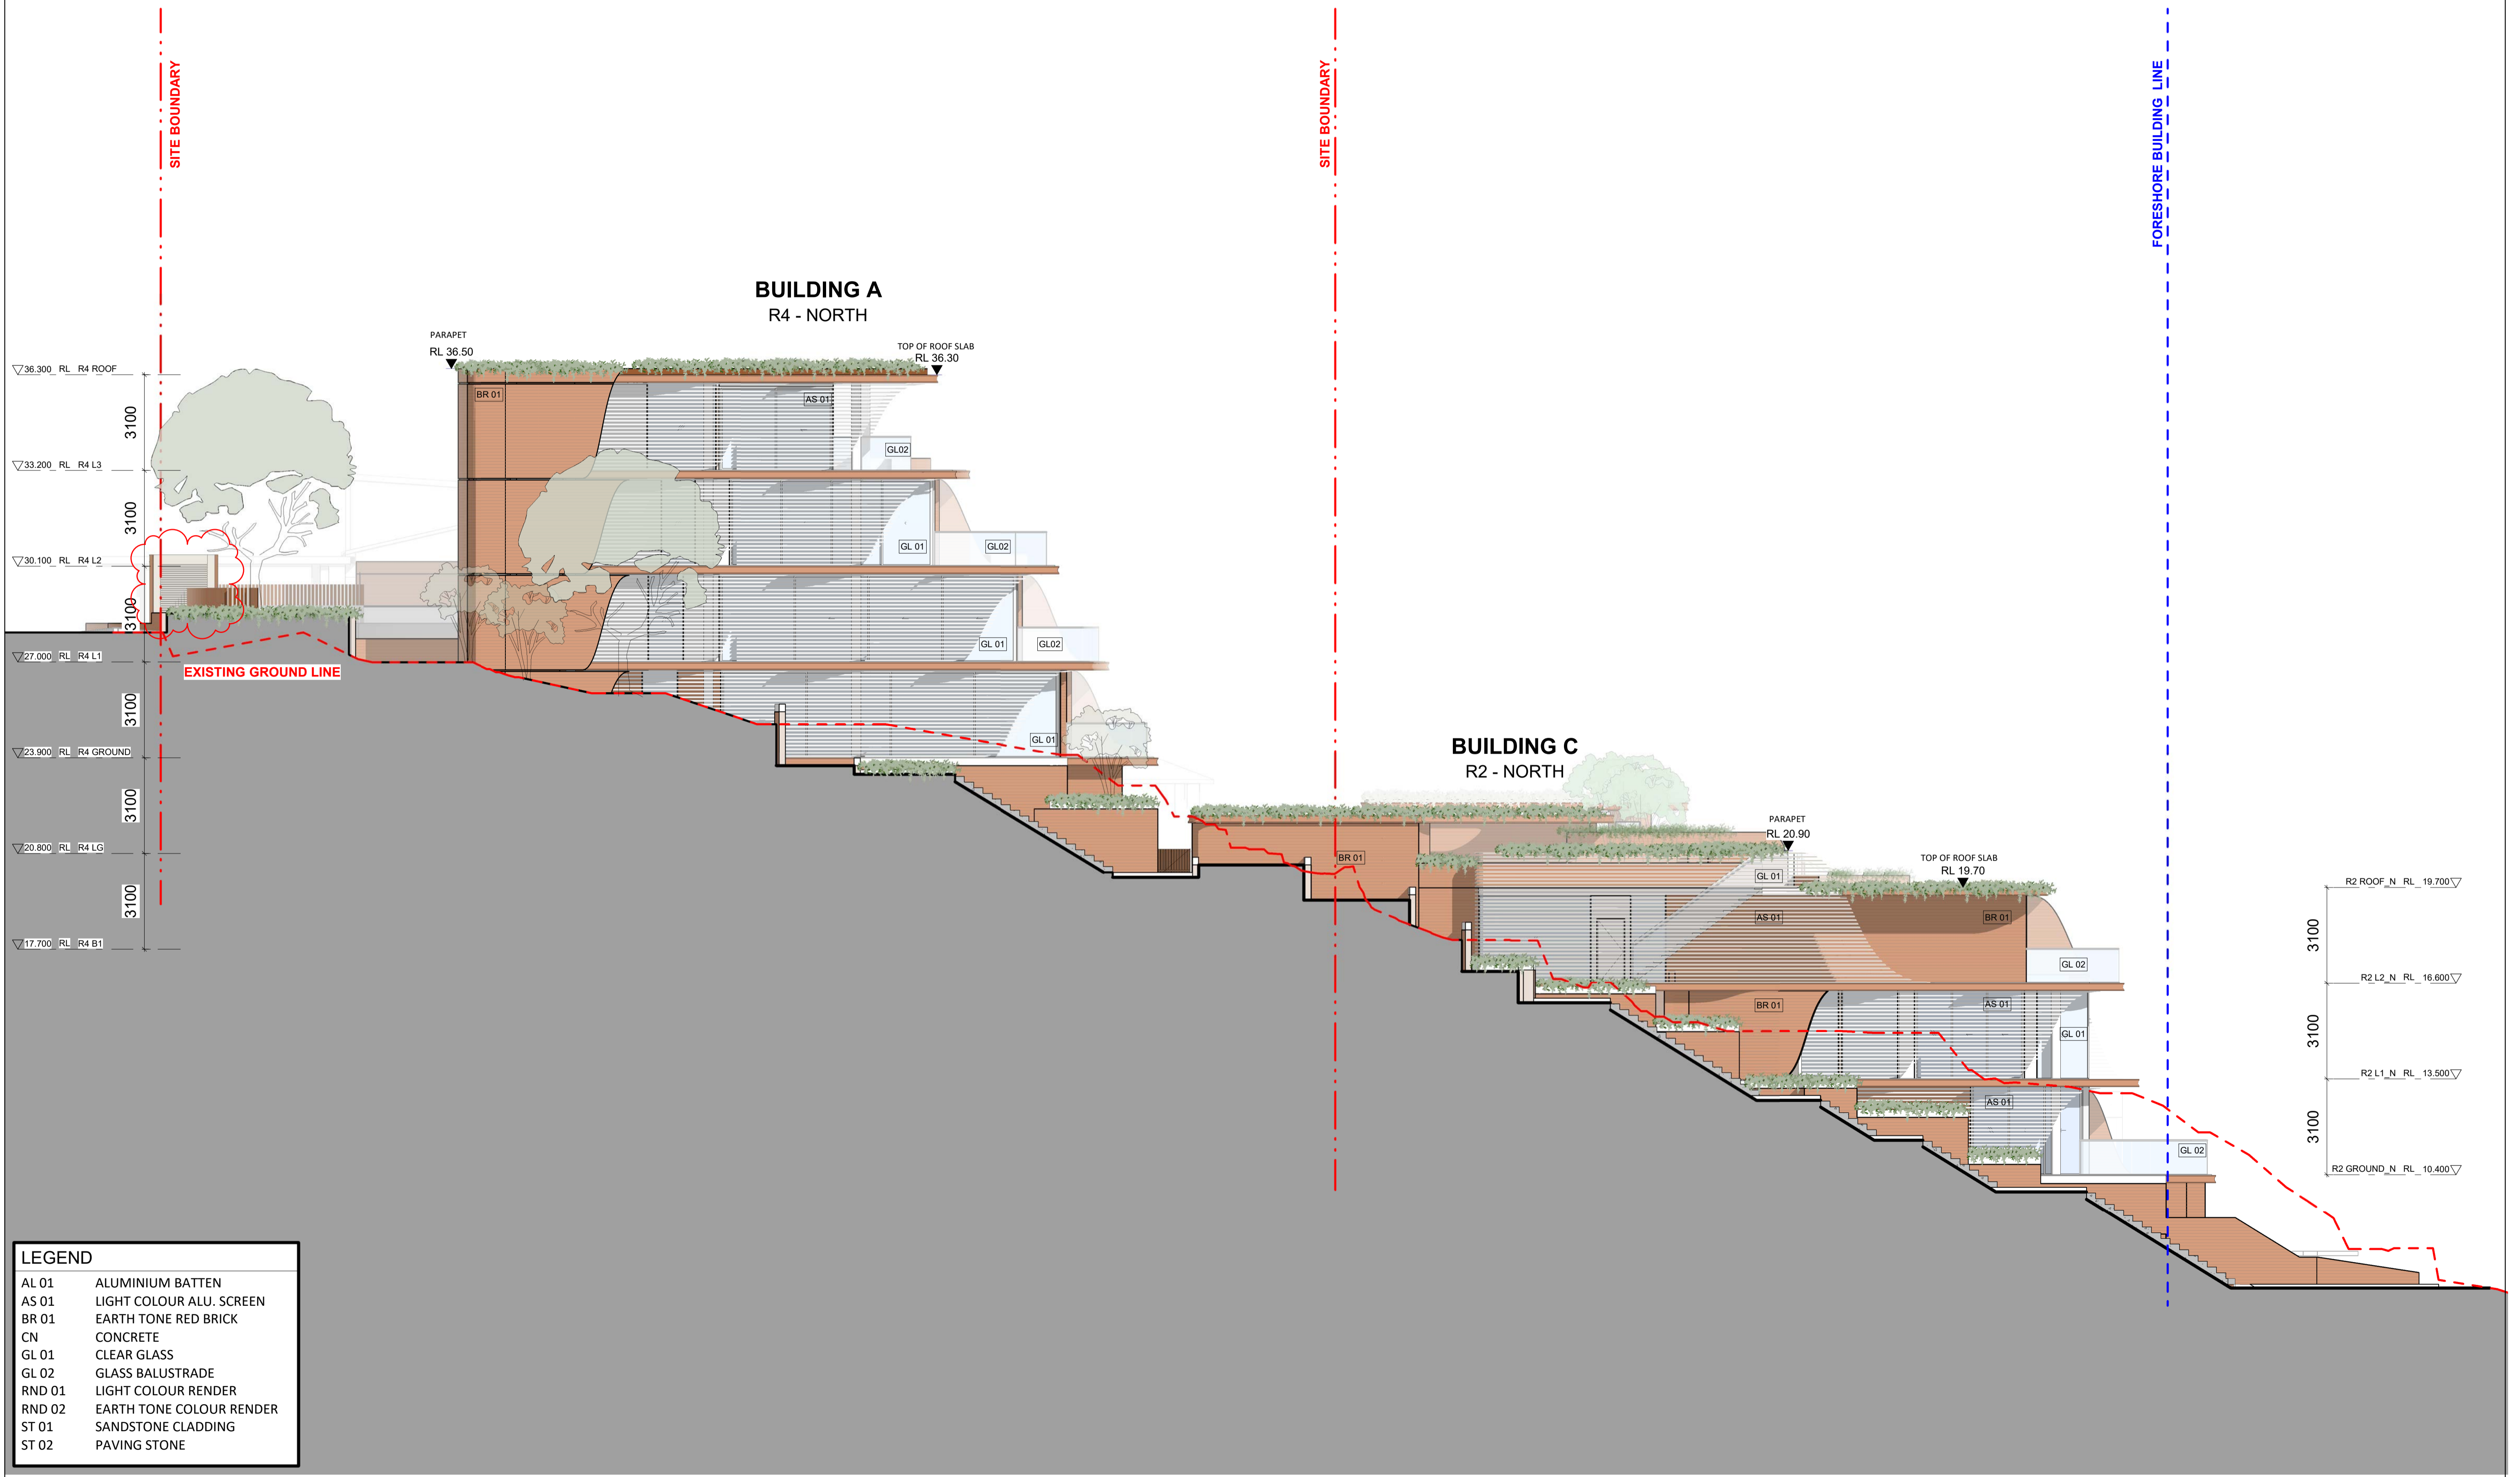

LEGEND

AL 01	ALUMINIUM BATTEN
AS 01	LIGHT COLOUR ALU. SCREEN
BR 01	EARTH TONE RED BRICK
CN	CONCRETE
GL 01	CLEAR GLASS
GL 02	GLASS BALUSTRADE
RND 01	LIGHT COLOUR RENDER
RND 02	EARTH TONE COLOUR RENDER
ST 01	SANDSTONE CLADDING
ST 02	PAVING STONE

NO.	REVISION	BY	CHK	DATE	REVISION NOTES:
1	FOR INFORMATION			08.12.2021	
2	FOR INFORMATION			17.12.2021	
3	COORDINATION ISSUE	AL	RPW	09.02.2022	
4	AMENDED COORDINATION ISSUE	AL	RPW	19.05.2022	
5	DA ISSUE	AL	RPW	08.06.2022	
6	COUNCIL RFI COORDINATION ISSUE	AL	RPW	31.07.2023	
7	COUNCIL RFI ISSUE	AL	RPW	15.08.2023	
8	ISSUE FOR DA RESUBMISSION	AL	RPW	02.02.2024	

KEY PLAN

CLOUD LEGEND

REVISION

ON HOLD

NOTES:
KOICHI TAKADA ARCHITECTS (KTA) RETAIN ALL COMMON LAW AND STATUTORY RIGHTS INCLUDING COPYRIGHT AND INTELLECTUAL PROPERTY RIGHTS TO THIS DOCUMENT. THIS DOCUMENT MUST NOT BE EDITED, PARTIALLY EXTRACTED, REPRODUCED OR DISTRIBUTED IN ANY MANNER WITHOUT KTA'S EXPRESS WRITTEN CONSENT AND UNDER NO CIRCUMSTANCES SHALL THE TRANSFER OF THIS DOCUMENT BE DEEMED A SALE OR CONSTITUTE A TRANSFER OF ANY LICENCE TO USE THE DOCUMENT WITHOUT KTA'S KNOWLEDGE OR CONSENT. THE PDF DOCUMENT STAMPED BY KTA AS A 'QA CONTROLLED DOCUMENT' IS THE ONLY OFFICIAL VERSION OF THIS DOCUMENT AND IS STRICTLY SUBJECT TO COPYRIGHT ©. THE CONTENT AND ACCURACY OF THE DOCUMENT IS STRICTLY LIMITED TO THAT DEPICTED IN THE QA CONTROLLED PDF. DO NOT MEASURE FROM THE ELECTRONIC OR HARD COPY VERSIONS OF THIS DOCUMENT. VERIFY ALL DIMENSIONS ON SITE BEFORE COMMENCING SHOP DRAWINGS, FABRICATION, CONSTRUCTION OR INSTALLATION.

CLIENT
Kurraba Point Road Pty Ltd
430 TOORAK ROAD, TOORAK 3142

ARCHITECT
SUITE 41 & 42, LEVEL 4
61 MARLBOROUGH ST
SURRY HILLS, NSW 2010
T 02 9698 8510
ABN 63 131 365 896
NOMINATED ARCHITECT:
KOICHI TAKADA
NSW ARCHITECTS 6901
VIC ARCHITECTS 16179
QLD ARCHITECTS 5590
KOICHI TAKADA.COM

Koichi Takada Architects

PROJECT
190 KURRABA RD
190 KURRABA RD, KURRABA POINT NSW 2089

STATUS
DEVELOPMENT APPLICATION - RFI 01

0 5 m

THIS DOCUMENT IS NOT SUITABLE OR APPROVED FOR CONSTRUCTION AT ANY TIME UNLESS KTA HAVE NOTATED THE STATUS TITLE AS FOR CONSTRUCTION WITHOUT THE PRESENCE OF 'WIP', 'DRAFT' OR ANY OTHER FORM OF QUALIFICATION ON THE DOCUMENT.

DWG TITLE ELEVATION - BUILDING A & C SOUTH	DWG NO. A205	REVISION 8
SCALE 1:100@A1, 1:200@A3	DATE 02.02.2024	

R2 ZONE

R4 ZONE


FORESHORE BUILDING LINE

SITE BOUNDARY

SITE BOUNDARY

BUILDING B
R4 - NORTH

BUILDING D
R2 - SOUTH

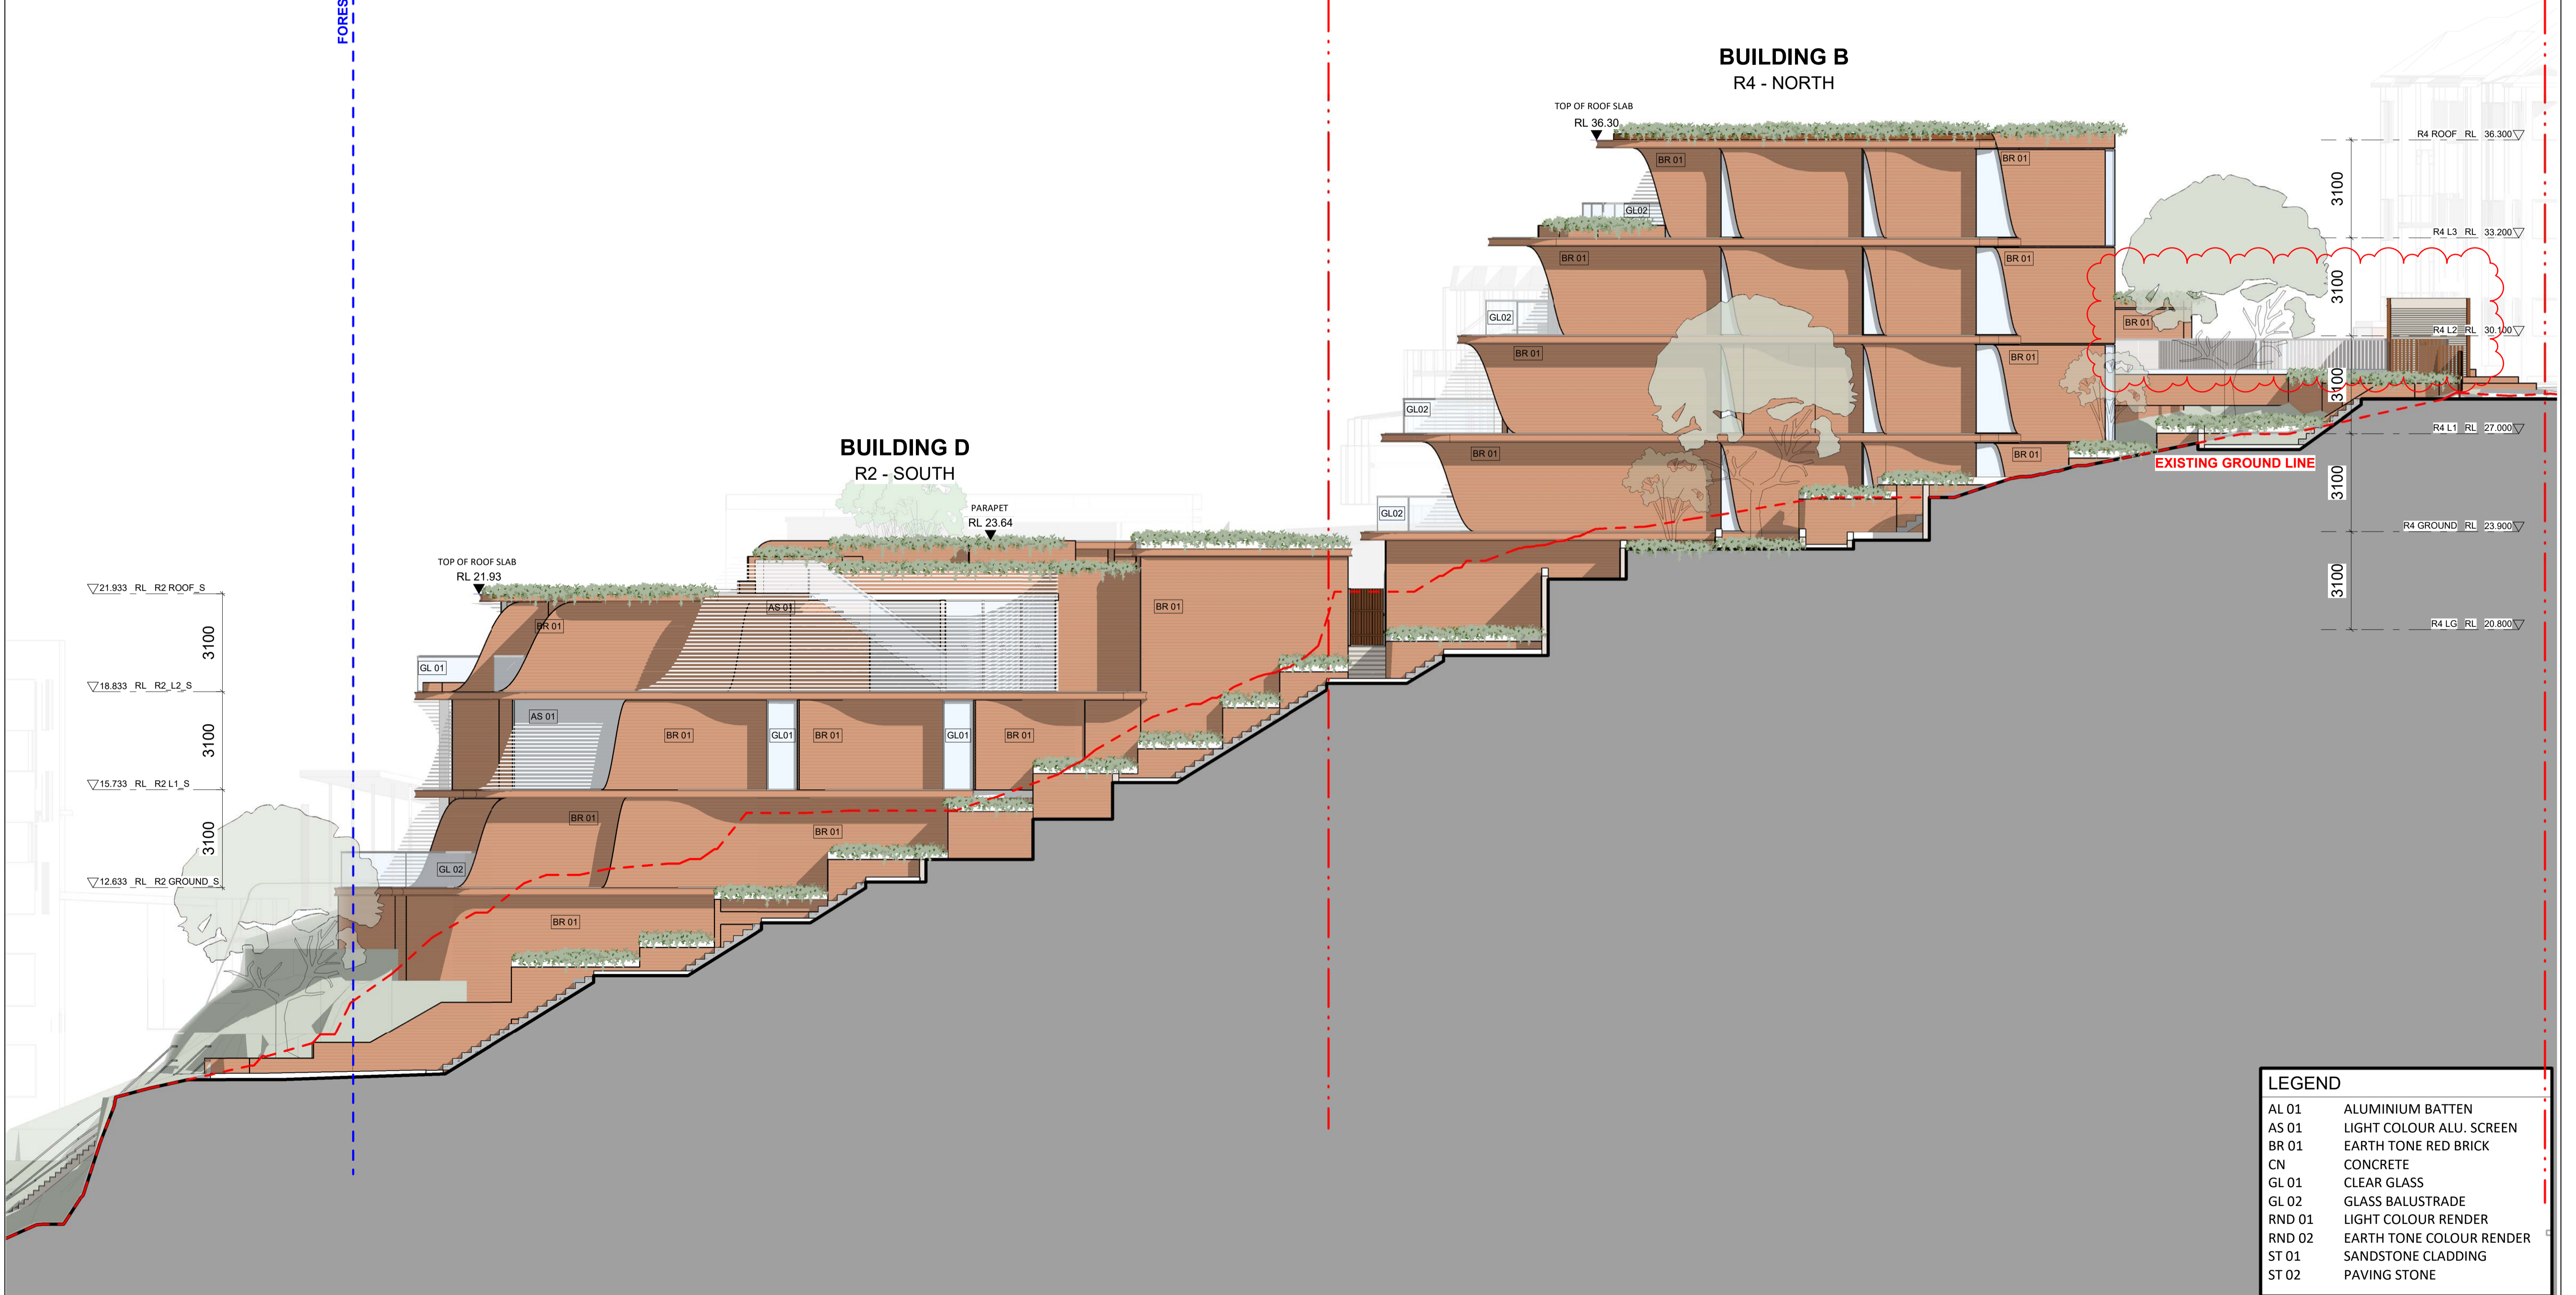

▽21.933_RL_R2 ROOF_S
3100
▽18.833_RL_R2 L2_S
3100
▽15.733_RL_R2 L1_S
3100
▽12.633_RL_R2 GROUND_S

R4 ROOF RL 36.300
3100
R4 L3 RL 33.200
3100
R4 L2 RL 30.100
3100
R4 L1 RL 27.000
3100
R4 GROUND RL 23.900
3100
R4 LG RL 20.800

LEGEND	
AL 01	ALUMINIUM BATTEN
AS 01	LIGHT COLOUR ALU. SCREEN
BR 01	EARTH TONE RED BRICK
CN	CONCRETE
GL 01	CLEAR GLASS
GL 02	GLASS BALUSTRADE
RND 01	LIGHT COLOUR RENDER
RND 02	EARTH TONE COLOUR RENDER
ST 01	SANDSTONE CLADDING
ST 02	PAVING STONE

NO.	REVISION	BY	CHK	DATE	REVISION NOTES:
1	FOR INFORMATION			08.12.2021	
2	FOR INFORMATION			17.12.2021	
3	AMENDED COORDINATION ISSUE	AL	RPW	19.05.2022	
4	DA ISSUE	RPW	AK	08.05.2022	
5	COUNCIL RFI COORDINATION ISSUE	AL/CK	RPW	31.07.2023	
6	COUNCIL RFI ISSUE	AL/CK	RPW	15.08.2023	
7	ISSUE FOR DA RESUBMISSION	AL	RPW	02.02.2024	

KEY PLAN
CLOUD LEGEND
REVISION
ON HOLD

NOTES:
KOICHI TAKADA ARCHITECTS (KTA) RETAIN ALL COMMON LAW AND STATUTORY RIGHTS INCLUDING COPYRIGHT AND INTELLECTUAL PROPERTY RIGHTS TO THIS DOCUMENT.
THIS DOCUMENT MUST NOT BE EDITED, PARTIALLY EXTRACTED, REPRODUCED OR DISTRIBUTED IN ANY MANNER WITHOUT KTA'S EXPRESS WRITTEN CONSENT AND UNDER NO CIRCUMSTANCES SHALL THE TRANSFER OF THIS DOCUMENT BE DEEMED A SALE OR CONSTITUTE A TRANSFER OF ANY LICENCE TO USE THE DOCUMENT WITHOUT KTA'S KNOWLEDGE OR CONSENT.
THE PDF DOCUMENT STAMPED BY KTA AS A 'QA CONTROLLED DOCUMENT' IS THE ONLY OFFICIAL VERSION OF THIS DOCUMENT AND IS STRICTLY SUBJECT TO COPYRIGHT ©.
THE CONTENT AND ACCURACY OF THE DOCUMENT IS STRICTLY LIMITED TO THAT DEPICTED IN THE QA CONTROLLED PDF. DO NOT MEASURE FROM THE ELECTRONIC OR HARD COPY VERSIONS OF THIS DOCUMENT.
VERIFY ALL DIMENSIONS ON SITE BEFORE COMMENCING SHOP DRAWINGS, FABRICATION, CONSTRUCTION OR INSTALLATION.

CLIENT
Kurraba Point Road Pty Ltd
430 TOORAK ROAD, TOORAK 3142

ARCHITECT
SUITE 41 & 42, LEVEL 4
61 MARLBOROUGH ST
SURRY HILLS, NSW 2010
T 02 9698 8510
ASN 63 131 365 696
NOMINATED ARCHITECT:
KOICHI TAKADA
NSW ARCHITECTS 6901
VIC ARCHITECTS 16179
QLD ARCHITECTS 5590
KOICHI TAKADA.COM

Koichi Takada Architects

GA STAMP
THIS DOCUMENT IS NOT SUITABLE OR APPROVED FOR CONSTRUCTION AT ANY TIME UNLESS KTA HAVE NOTATED THE STATUS TITLE AS FOR CONSTRUCTION WITHOUT THE PRESENCE OF 'WIP', 'DRAFT' OR ANY OTHER FORM OF QUALIFICATION ON THE DOCUMENT.

PROJECT
190 KURRABA RD
190 KURRABA RD, KURRABA POINT NSW 2089

STATUS
DEVELOPMENT APPLICATION - RFI 01

SCALE
1:100@A1, 1:200@A3


DWG TITLE
ELEVATION - MIDDLE LOOKING SOUTH

DWG NO.
A206

REVISION
7

DATE
02.02.2024

184B - 190 KURRABA ROAD,
KURRABA POINT NSW 2089

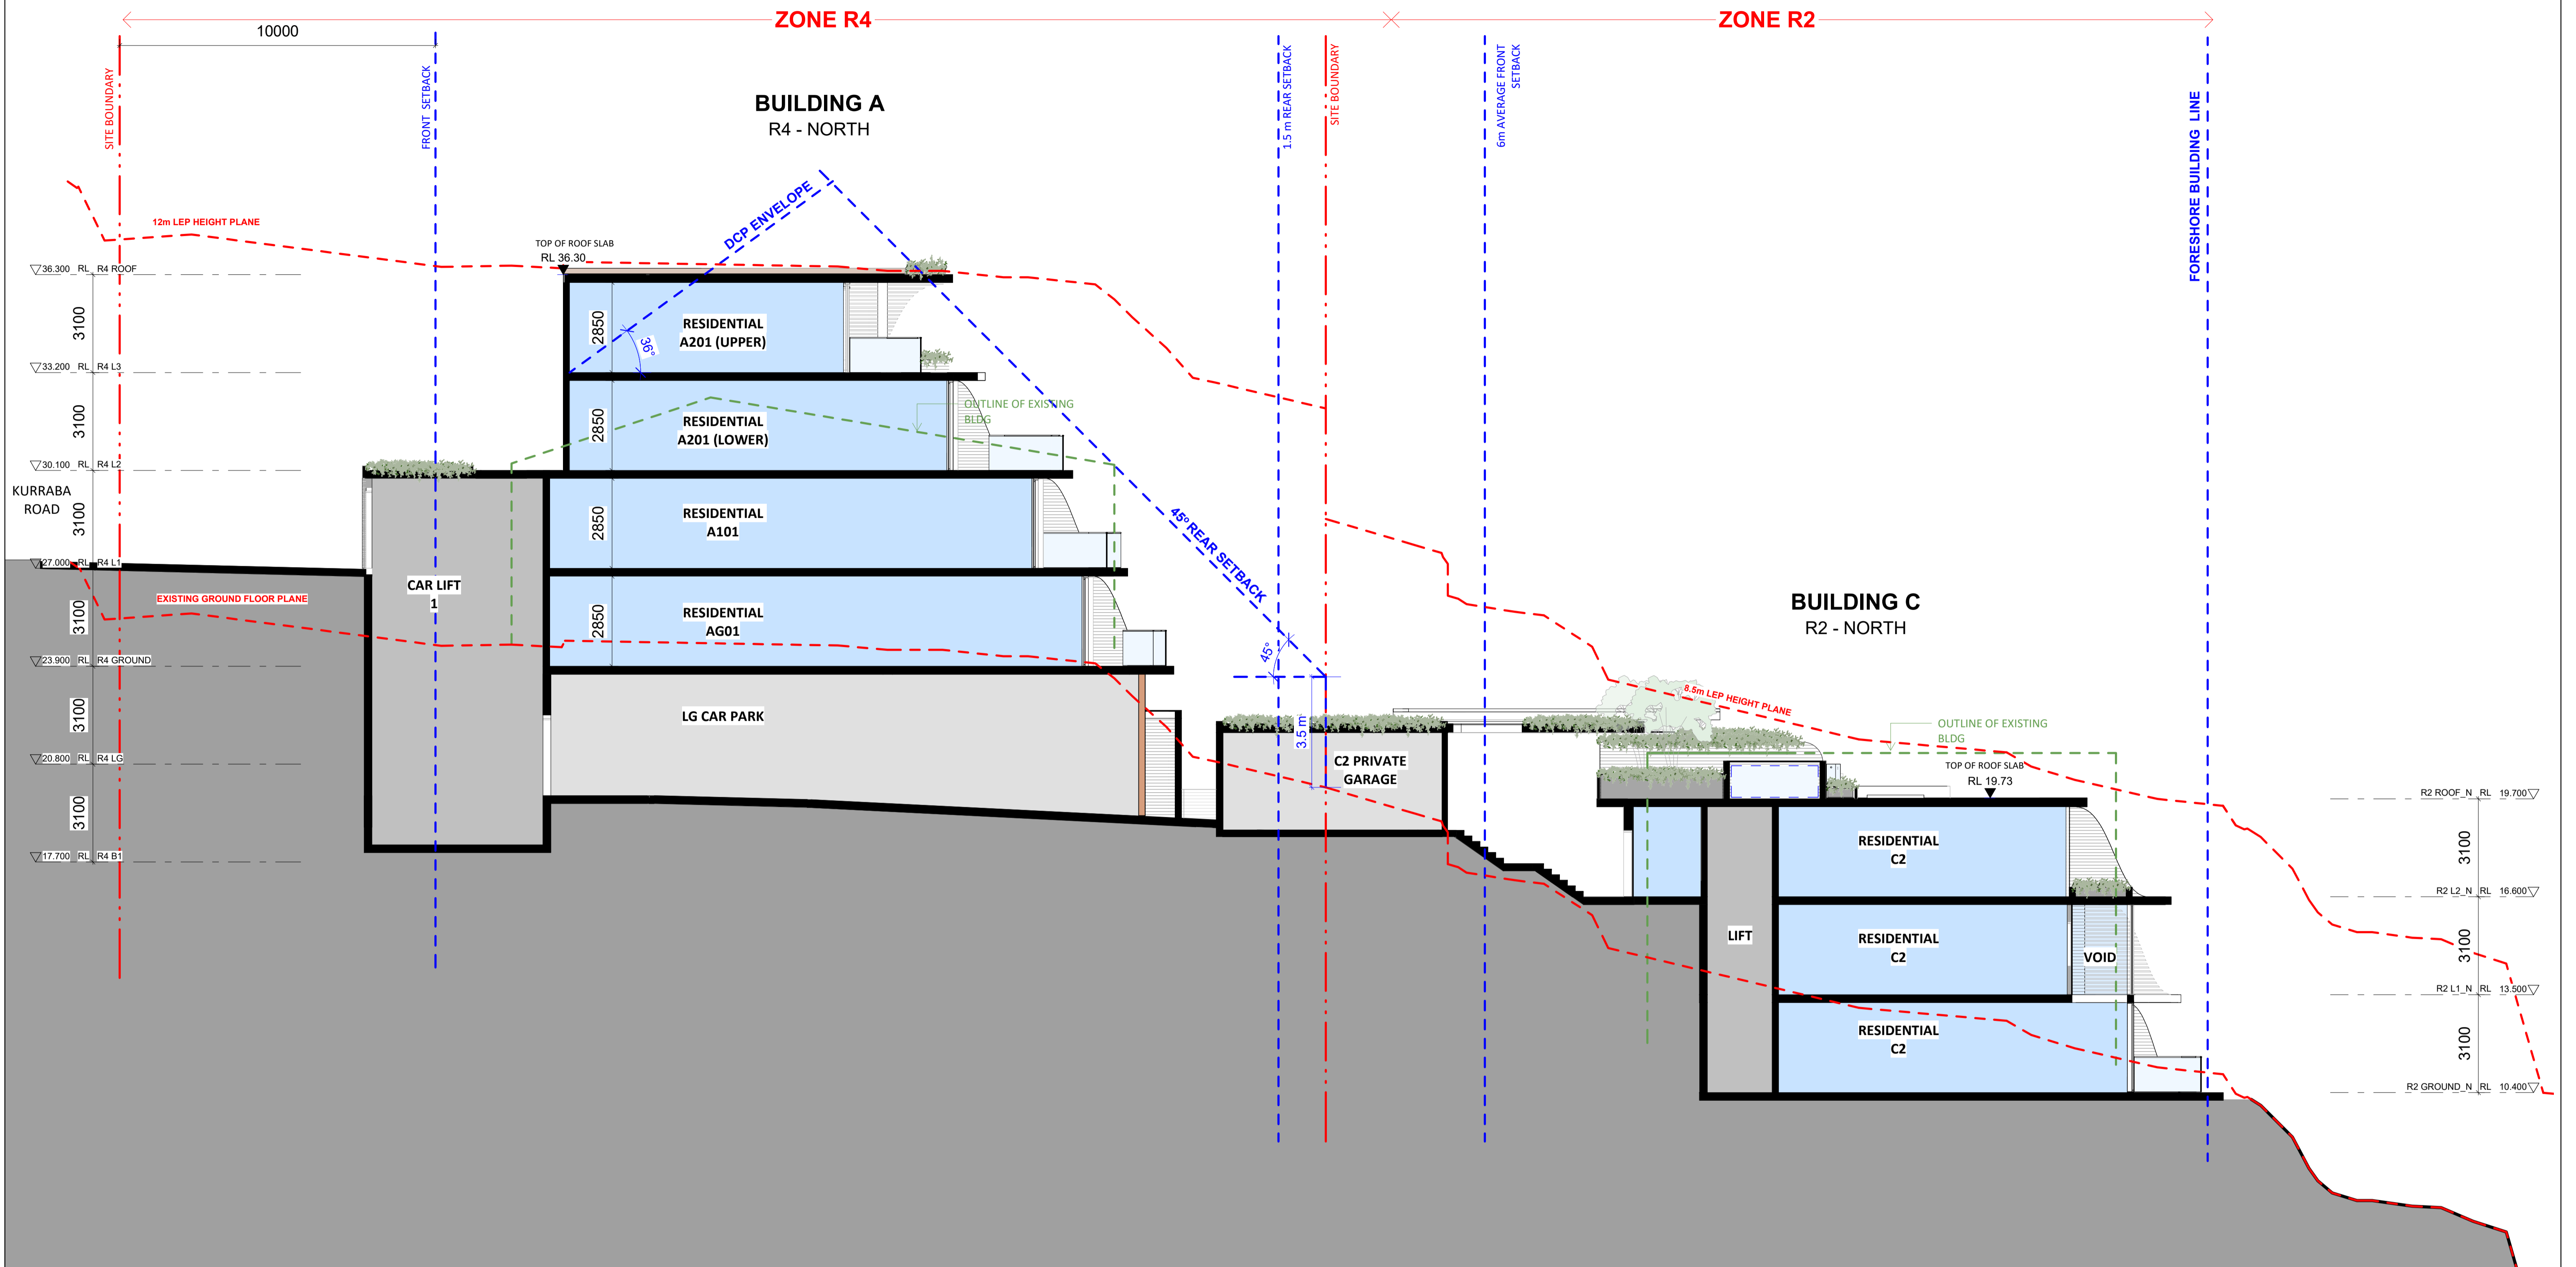

KEY

- SITE BOUNDARY
- SETBACK LINES
- RESIDENTIAL
- COMMUNAL
- CAR PARK

DIAGRAM LEGEND:

NOTE:
THE RED DOTTED LINES REPRESENTS HEIGHT PLANES REFLECTING THE SURVEYED GROUND WITH EXISTING STRUCTURES OMITTED, IN ACCORDANCE WITH BETTAR V COUNCIL

NO.	REVISION	BY	CHK	DATE
1	FOR INFORMATION			18.11.2021
2	FOR INFORMATION			08.12.2021
3	PRE-LODGE			20.01.2022
4	COORDINATION ISSUE			09.02.2022
5	AMENDED COORDINATION ISSUE	AL	RPW	19.05.2022
6	DA ISSUE	RPW	AC	08.06.2022
7	COUNCIL RFI COORDINATION ISSUE	AL/DK	RPW	31.07.2023
8	COUNCIL RFI ISSUE	AL/DK	RPW	15.08.2023
9	ISSUE FOR DA RESUBMISSION	AL	RPW	02.02.2024

REVISION NOTES:

REVISION ON HOLD

KEY PLAN

CLOUD LEGEND

NOTES:
KOICHI TAKADA ARCHITECTS (KTA) RETAIN ALL COMMON LAW AND STATUTORY RIGHTS INCLUDING COPYRIGHT AND INTELLECTUAL PROPERTY RIGHTS TO THIS DOCUMENT. THIS DOCUMENT MUST NOT BE EDITED, PARTIALLY EXTRACTED, REPRODUCED OR DISTRIBUTED IN ANY MANNER WITHOUT KTA'S EXPRESS WRITTEN CONSENT AND UNDER NO CIRCUMSTANCES SHALL THE TRANSFER OF THIS DOCUMENT BE DEEMED A SALE OR CONSTITUTE A TRANSFER OF ANY LICENCE TO USE THE DOCUMENT WITHOUT KTA'S KNOWLEDGE OR CONSENT. THE PDF DOCUMENT STAMPED BY KTA AS A 'QA CONTROLLED DOCUMENT' IS THE ONLY OFFICIAL VERSION OF THIS DOCUMENT AND IS STRICTLY SUBJECT TO COPYRIGHT ©. THE CONTENT AND ACCURACY OF THE DOCUMENT IS STRICTLY LIMITED TO THAT DEPICTED IN THE QA CONTROLLED PDF. DO NOT MEASURE FROM THE ELECTRONIC OR HARD COPY VERSIONS OF THIS DOCUMENT. VERIFY ALL DIMENSIONS ON SITE BEFORE COMMENCING SHOP DRAWINGS, FABRICATION, CONSTRUCTION OR INSTALLATION.

CLIENT
Kurraba Point Road Pty Ltd
430 TOORAK ROAD, TOORAK 3142

ARCHITECT
SUITE 41 & 42, LEVEL 4
61 MARLBOROUGH ST
SURRY HILLS, NSW 2010
T 02 9698 8510
ABN 63 131 365 896
NOMINATED ARCHITECT:
KOICHI TAKADA
NSW ARCHITECTS 6901
VIC ARCHITECTS 16179
QLD ARCHITECTS 5590
KOICHI TAKADA.COM

Koichi Takada Architects

GA STAMP

THIS DOCUMENT IS NOT SUITABLE OR APPROVED FOR CONSTRUCTION AT ANY TIME UNLESS KTA HAVE NOTATED THE STATUS TITLE AS FOR CONSTRUCTION WITHOUT THE PRESENCE OF 'WIP', 'DRAFT' OR ANY OTHER FORM OF QUALIFICATION ON THE DOCUMENT.

PROJECT
190 KURRABA RD
190 KURRABA RD, KURRABA POINT NSW 2089

STATUS
DEVELOPMENT APPLICATION - RFI 01

SCALE
1:100@A1, 1:200@A3


DWG TITLE
SECTION 1 - NORTH SECTION

DWG NO.
A301

REVISION
9

DATE
02.02.2024

184B - 190 KURRABA ROAD,
KURRABA POINT NSW 2089

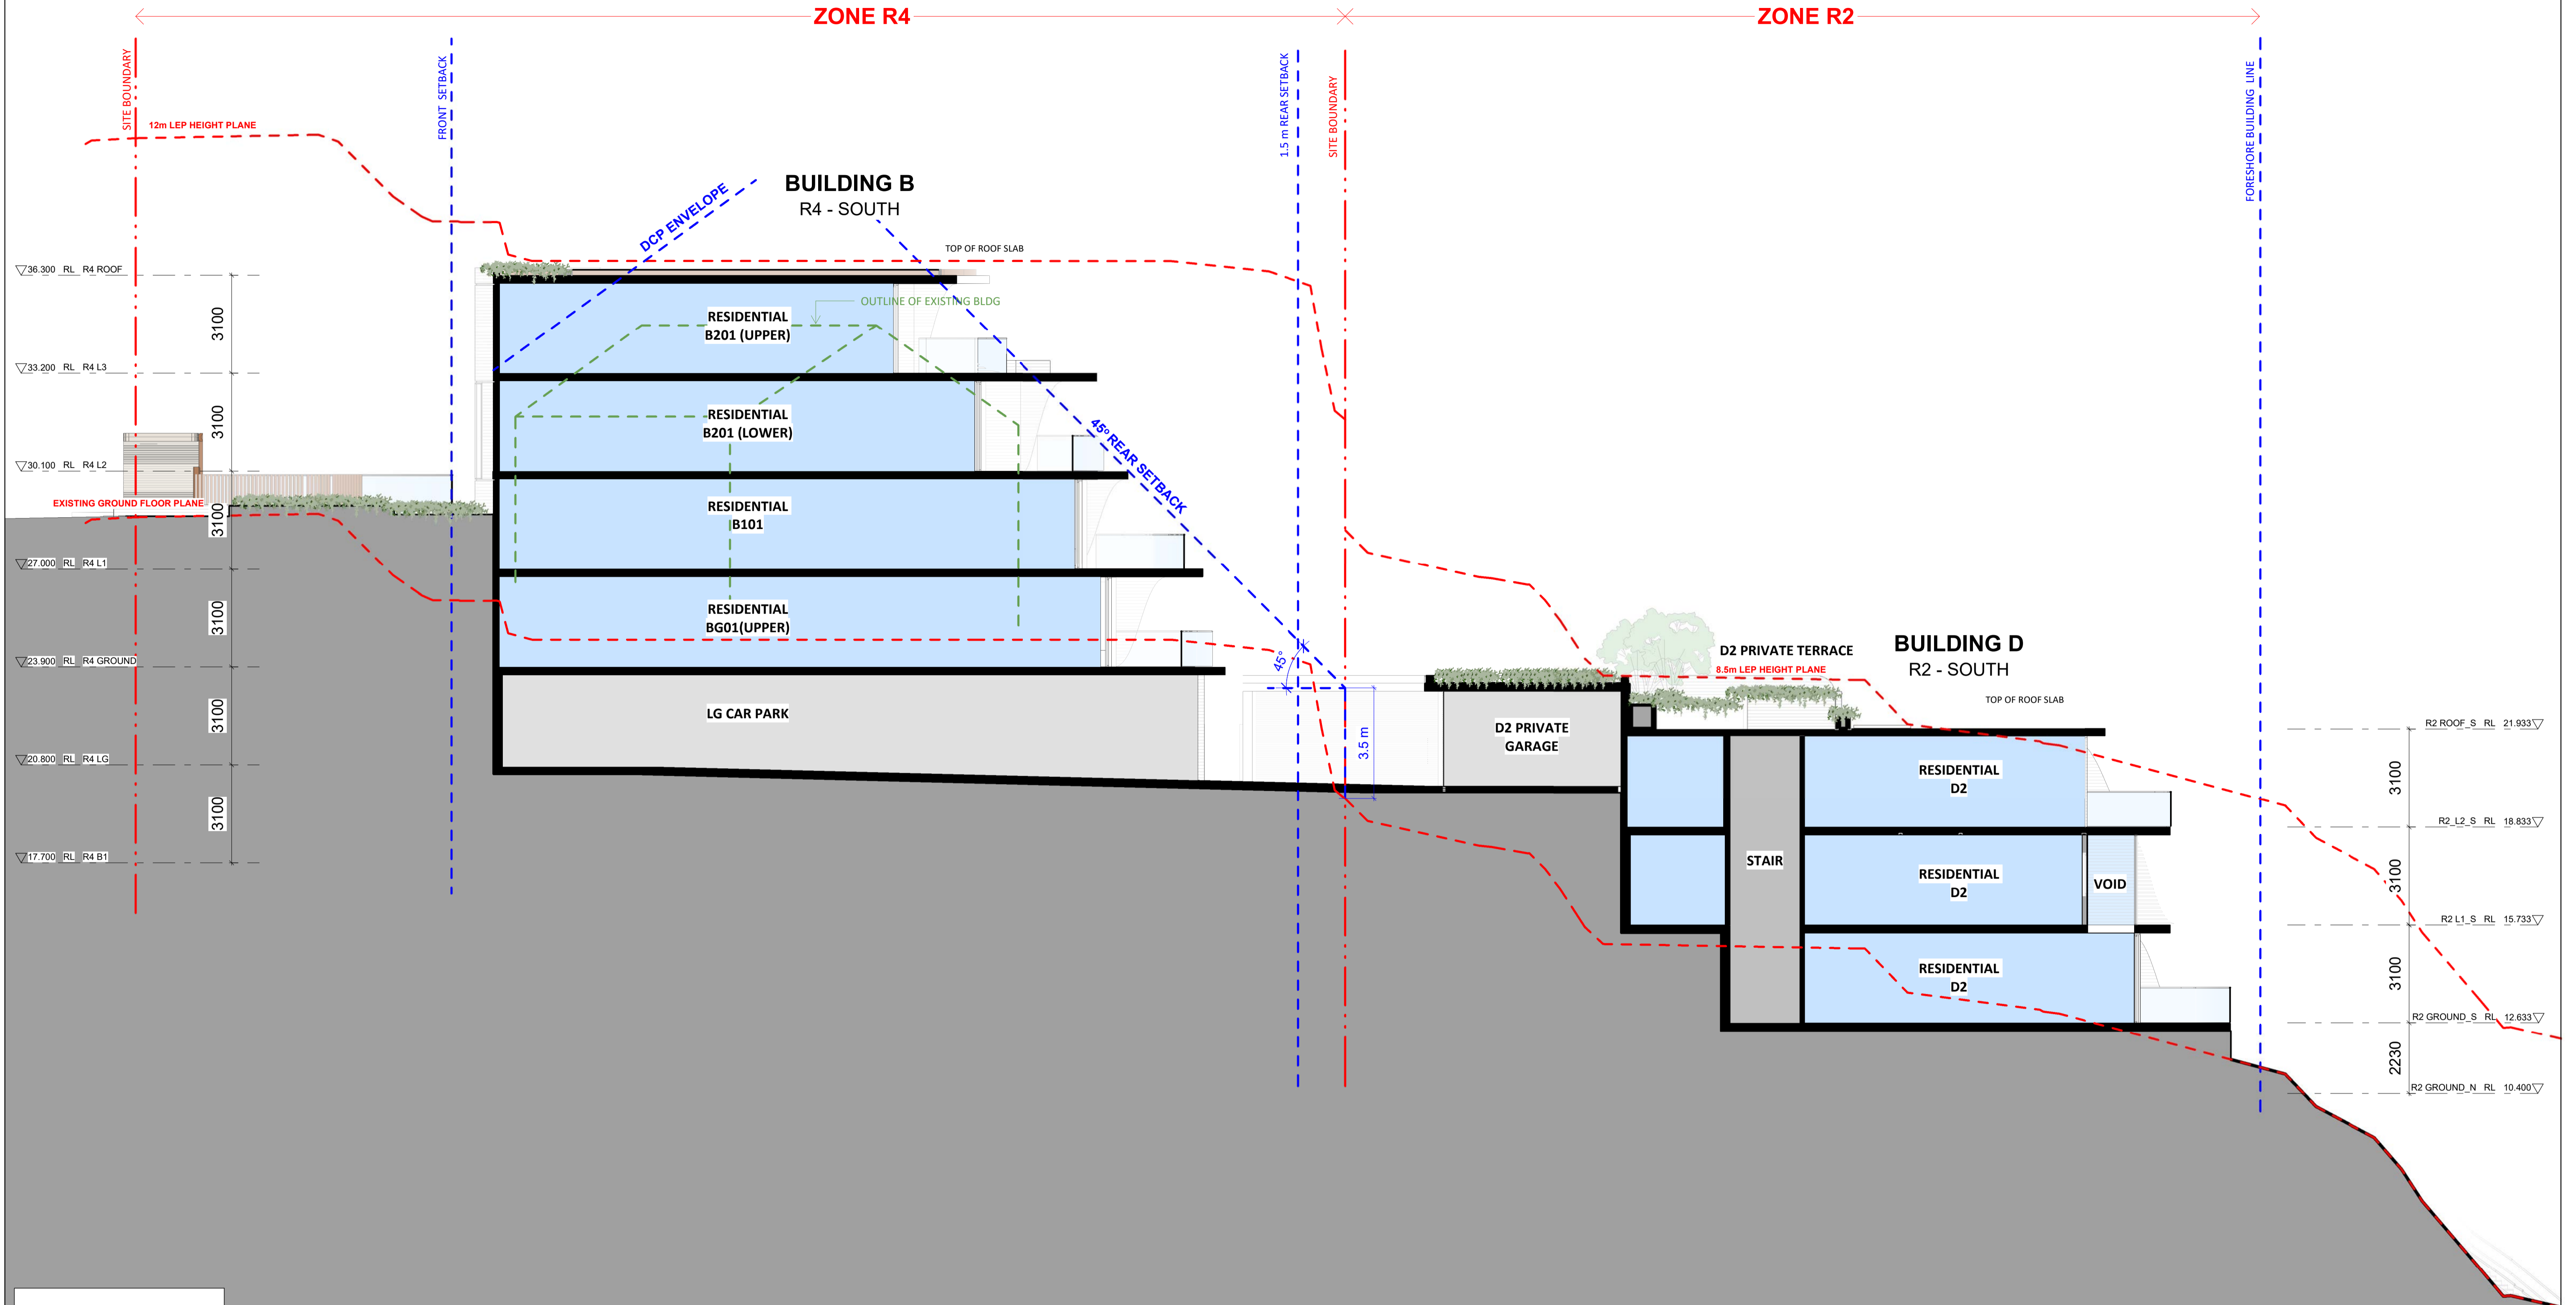

KEY

- SITE BOUNDARY
- SETBACK LINES
- RESIDENTIAL
- COMMUNAL
- CAR PARK

DIAGRAM LEGEND:

NOTE:
THE RED DOTTED LINES REPRESENTS HEIGHT PLANES REFLECTING THE SURVEYED GROUND WITH EXISTING STRUCTURES OMITTED, IN ACCORDANCE WITH BETTAR V COUNCIL

NO.	REVISION	BY	CHK	DATE	REVISION NOTES:
1	FOR INFORMATION			18.11.2021	
2	FOR INFORMATION			08.12.2021	
3	PRE-LODGE			20.01.2022	
4	COORDINATION ISSUE			09.02.2022	
5	AMENDED COORDINATION ISSUE	AL	RPW	19.05.2022	
6	DA ISSUE	RPW	AC	08.06.2022	
7	COUNCIL RFI COORDINATION ISSUE	AL/DK/RPW		31.07.2023	
8	COUNCIL RFI ISSUE	AL/DK/RPW		15.08.2023	
9	ISSUE FOR DA RESUBMISSION	AL	RPW	02.02.2024	

KEY PLAN

CLOUD LEGEND

- REVISION
- ON HOLD

NOTES:
KOICHI TAKADA ARCHITECTS (KTA) RETAIN ALL COMMON LAW AND STATUTORY RIGHTS INCLUDING COPYRIGHT AND INTELLECTUAL PROPERTY RIGHTS TO THIS DOCUMENT. THIS DOCUMENT MUST NOT BE EDITED, PARTIALLY EXTRACTED, REPRODUCED OR DISTRIBUTED IN ANY MANNER WITHOUT KTA'S EXPRESS WRITTEN CONSENT AND UNDER NO CIRCUMSTANCES SHALL THE TRANSFER OF THIS DOCUMENT BE DEEMED A SALE OR CONSTITUTE A TRANSFER OF ANY LICENCE TO USE THE DOCUMENT WITHOUT KTA'S KNOWLEDGE OR CONSENT. THE PDF DOCUMENT STAMPED BY KTA AS A 'QA CONTROLLED DOCUMENT' IS THE ONLY OFFICIAL VERSION OF THIS DOCUMENT AND IS STRICTLY SUBJECT TO COPYRIGHT ©. THE CONTENT AND ACCURACY OF THE DOCUMENT IS STRICTLY LIMITED TO THAT DEPICTED IN THE QA CONTROLLED PDF. DO NOT MEASURE FROM THE ELECTRONIC OR HARD COPY VERSIONS OF THIS DOCUMENT. VERIFY ALL DIMENSIONS ON SITE BEFORE COMMENCING SHOP DRAWINGS, FABRICATION, CONSTRUCTION OR INSTALLATION.

CLIENT:
Kurraba Point Road Pty Ltd
430 TOORAK ROAD, TOORAK 3142

ARCHITECT:
SUITE 41 & 42, LEVEL 4
61 MARLBOROUGH ST
SURRY HILLS, NSW 2010
T 02 9698 8510
ABN 63 131 365 896
NOMINATED ARCHITECT:
KOICHI TAKADA
NSW ARCHITECTS 6901
VIC ARCHITECTS 16179
QLD ARCHITECTS 5590
KOICHI TAKADA.COM

Koichi Takada Architects

PROJECT:
190 KURRABA RD
190 KURRABA RD, KURRABA POINT NSW
2089

STATUS:
DEVELOPMENT APPLICATION - RFI 01


0 5 m

THIS DOCUMENT IS NOT SUITABLE OR APPROVED FOR CONSTRUCTION AT ANY TIME UNLESS KTA HAS NOTATED THE STATUS TITLE AS FOR CONSTRUCTION WITHOUT THE PRESENCE OF 'WIP', 'DRAFT' OR ANY OTHER FORM OF QUALIFICATION ON THE DOCUMENT.

DWG TITLE	REVISION	DATE
SECTION 2 - SOUTH SECTION	9	02.02.2024

SCALE: 1:100@A1, 1:200@A3

184B - 190 KURRABA ROAD,
KURRABA POINT NSW 2089

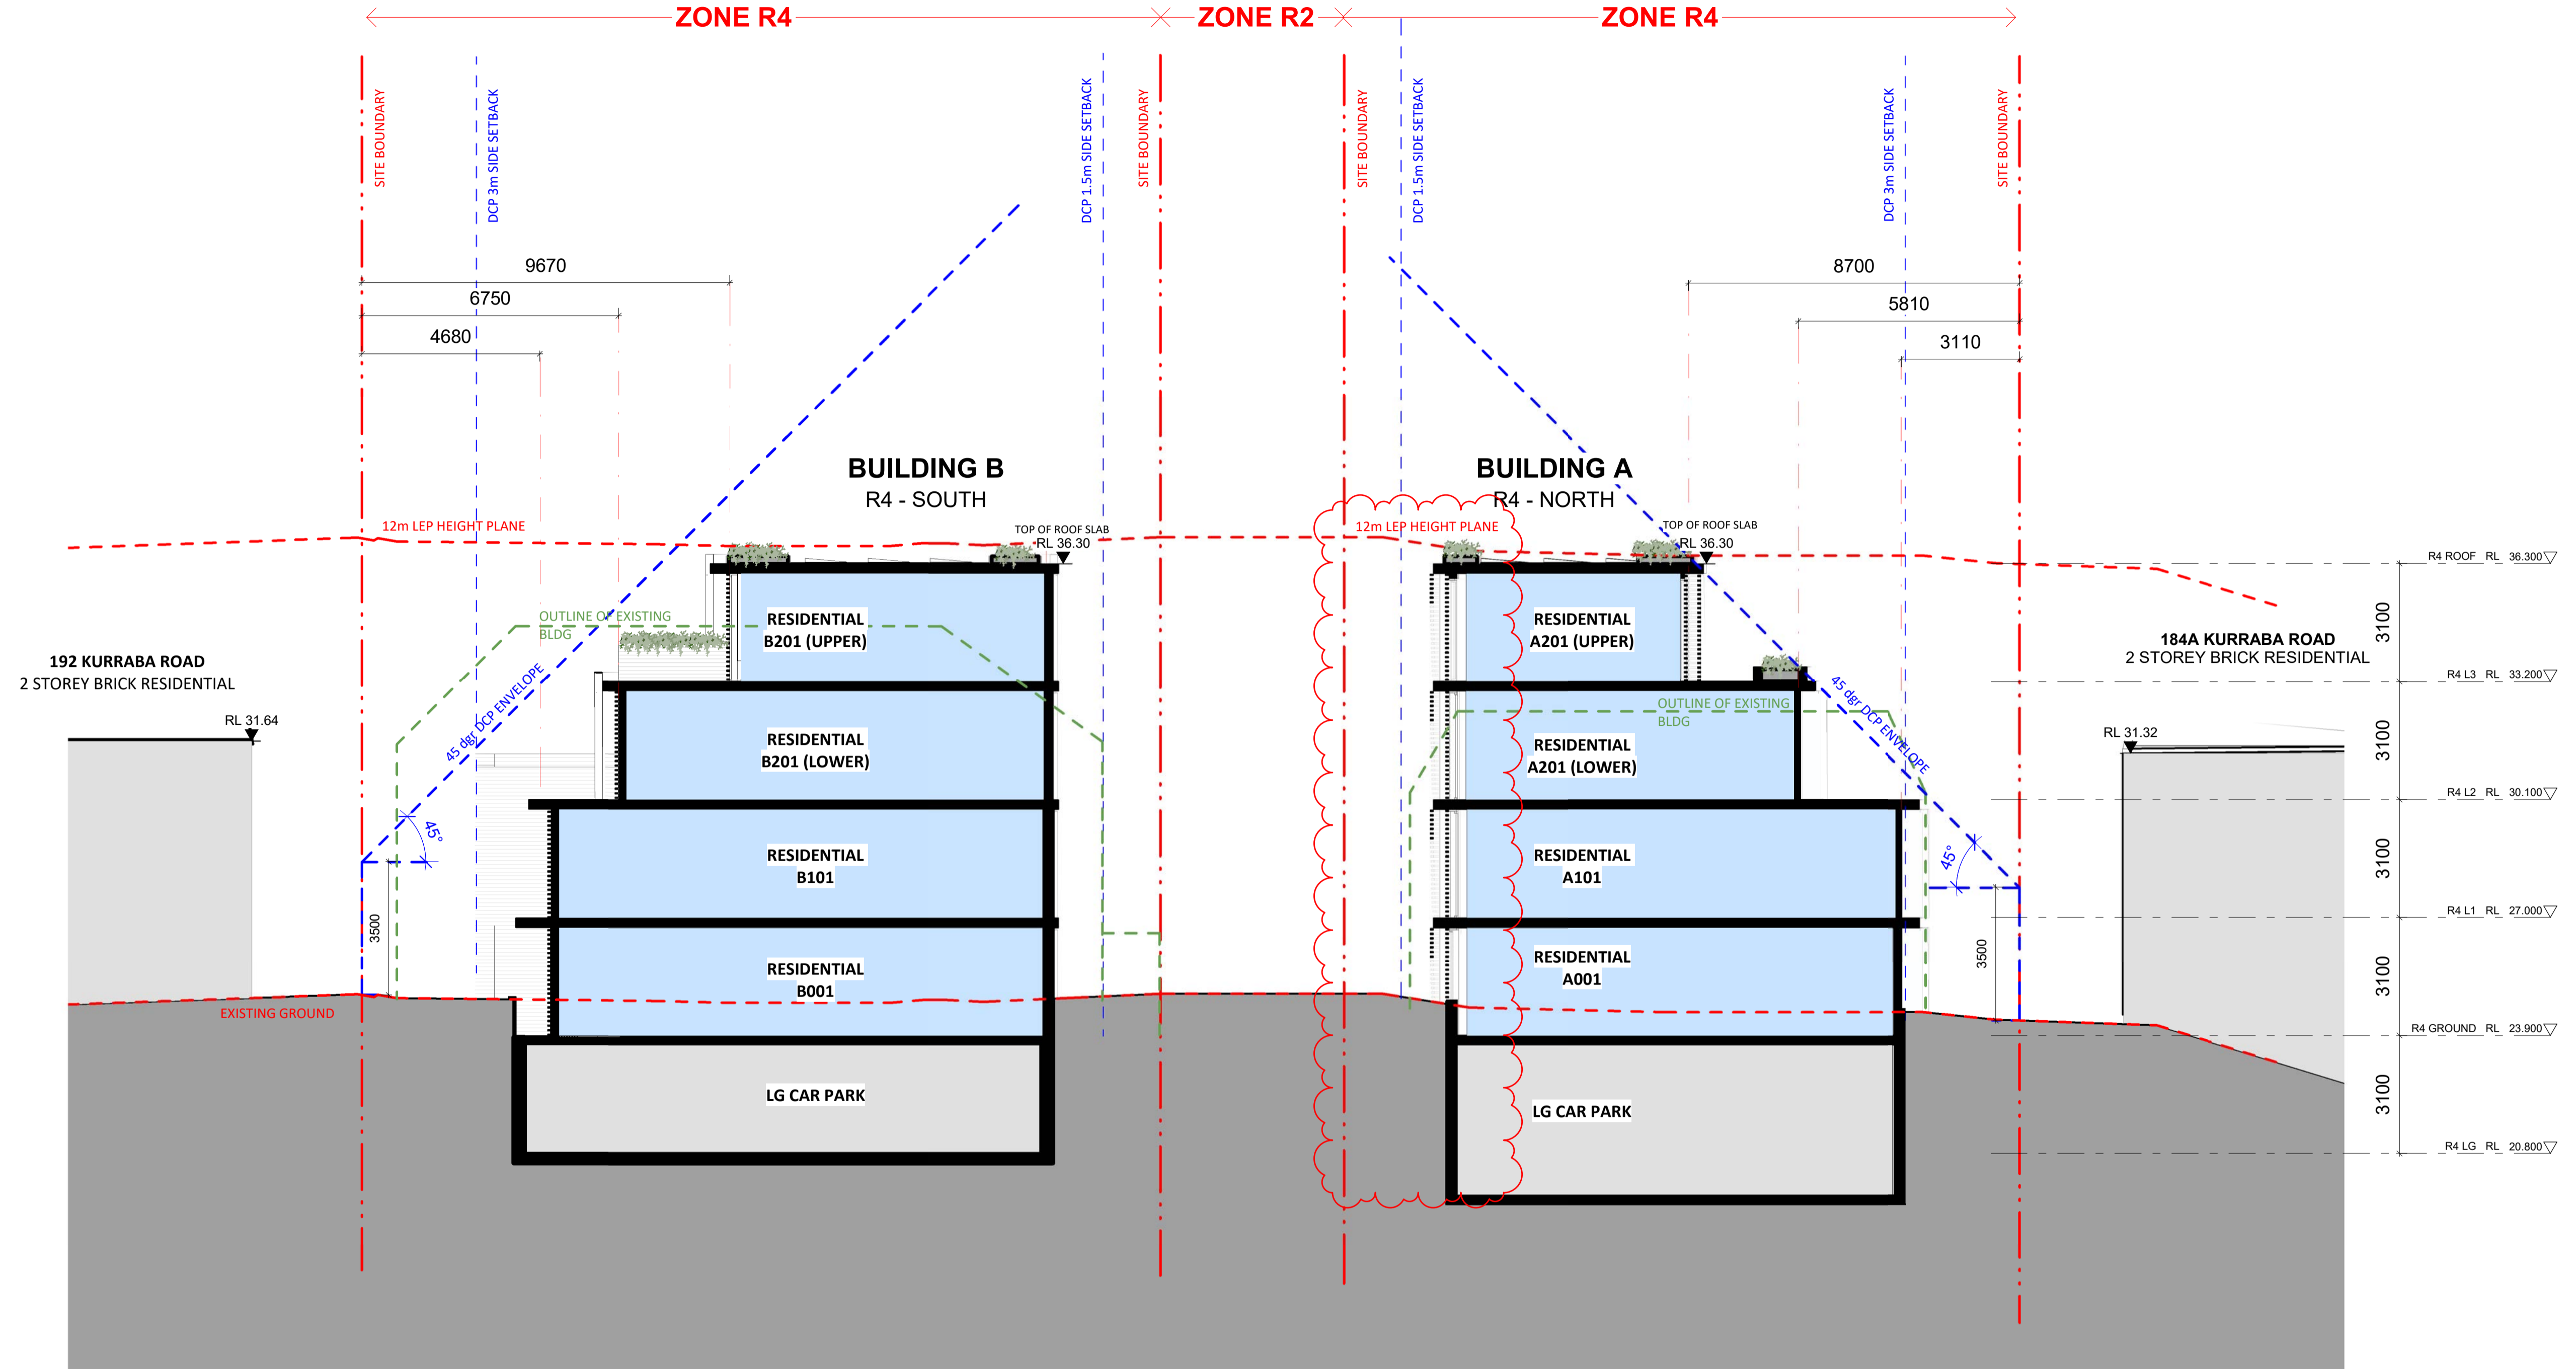

KEY

- SITE BOUNDARY
- SETBACK LINES
- RESIDENTIAL
- COMMUNAL
- CAR PARK

DIAGRAM LEGEND:

NOTE:
THE RED DOTTED LINE REPRESENT HEIGHT PLANES REFLECTING THE SURVEYED GROUND WITH EXISTING STRUCTURES OMITTED, IN ACCORDANCE WITH BETTAR V COUNCIL

NO.	REVISION	BY	CHK	DATE
1	FOR INFORMATION			18.11.2021
2	FOR INFORMATION			08.12.2021
3	PRE-LODGE			20.01.2022
4	COORDINATION ISSUE			09.02.2022
5	AMENDED COORDINATION ISSUE	AL	RPW	19.05.2022
6	DA ISSUE	RPW	AC	08.06.2022
7	COUNCIL RFI COORDINATION ISSUE	AL/DK	RPW	31.07.2023
8	COUNCIL RFI ISSUE	AL/DK	RPW	15.08.2023
9	ISSUE FOR DA RESUBMISSION	AL	RPW	02.02.2024

REVISION NOTES:

NO.	REVISION	DATE
1	FOR INFORMATION	18.11.2021
2	FOR INFORMATION	08.12.2021
3	PRE-LODGE	20.01.2022
4	COORDINATION ISSUE	09.02.2022
5	AMENDED COORDINATION ISSUE	19.05.2022
6	DA ISSUE	08.06.2022
7	COUNCIL RFI COORDINATION ISSUE	31.07.2023
8	COUNCIL RFI ISSUE	15.08.2023
9	ISSUE FOR DA RESUBMISSION	02.02.2024

KEY PLAN

CLOUD LEGEND

- REVISION
- ON HOLD

NOTES:
KOICHI TAKADA ARCHITECTS (KTA) RETAIN ALL COMMON LAW AND STATUTORY RIGHTS INCLUDING COPYRIGHT AND INTELLECTUAL PROPERTY RIGHTS TO THIS DOCUMENT. THIS DOCUMENT MUST NOT BE EDITED, PARTIALLY EXTRACTED, REPRODUCED OR DISTRIBUTED IN ANY MANNER WITHOUT KTA'S EXPRESS WRITTEN CONSENT AND UNDER NO CIRCUMSTANCES SHALL THE TRANSFER OF THIS DOCUMENT BE DEEMED A SALE OR CONSTITUTE A TRANSFER OF ANY LICENCE TO USE THE DOCUMENT WITHOUT KTA'S KNOWLEDGE OR CONSENT. THE PDF DOCUMENT STAMPED BY KTA AS A 'QA CONTROLLED DOCUMENT' IS THE ONLY OFFICIAL VERSION OF THIS DOCUMENT AND IS STRICTLY SUBJECT TO COPYRIGHT © THE CONTENT AND ACCURACY OF THE DOCUMENT IS STRICTLY LIMITED TO THAT SHOWN IN THE QA CONTROLLED PDF. DO NOT MEASURE FROM THE ELECTRONIC OR HARD COPY VERSIONS OF THIS DOCUMENT. VERIFY ALL DIMENSIONS ON SITE BEFORE COMMENCING SHOP DRAWINGS, FABRICATION, CONSTRUCTION OR INSTALLATION.

CLIENT
Kurraba Point Road Pty Ltd
430 TOORAK ROAD, TOORAK 3142

ARCHITECT
SUITE 41 & 42, LEVEL 4
61 MARLBOROUGH ST
SURRY HILLS, NSW 2010
T 02 9698 8510
ABN 63 131 365 896
NOMINATED ARCHITECT:
KOICHI TAKADA
NSW ARCHITECTS 6901
VIC ARCHITECTS 16179
QLD ARCHITECTS 5590
KOICHI TAKADA.COM

Koichi Takada Architects

GA STAMP

THIS DOCUMENT IS NOT SUITABLE OR APPROVED FOR CONSTRUCTION AT ANY TIME UNLESS KTA HAVE NOTATED THE STATUS TITLE AS FOR CONSTRUCTION WITHOUT THE PRESENCE OF 'WIP', 'DRAFT' OR ANY OTHER FORM OF QUALIFICATION ON THE DOCUMENT.

PROJECT
190 KURRABA RD
190 KURRABA RD, KURRABA POINT NSW
2089

STATUS
DEVELOPMENT APPLICATION - RFI 01

0 5 m

DWG TITLE
SECTION 3 - R4 ZONE

DWG NO.
A303

REVISION
9


SCALE
1:100@A1, 1:200@A3

DATE
02.02.2024

184B - 190 KURRABA ROAD,
KURRABA POINT NSW 2089

R2 ZONE

R2 ZONE

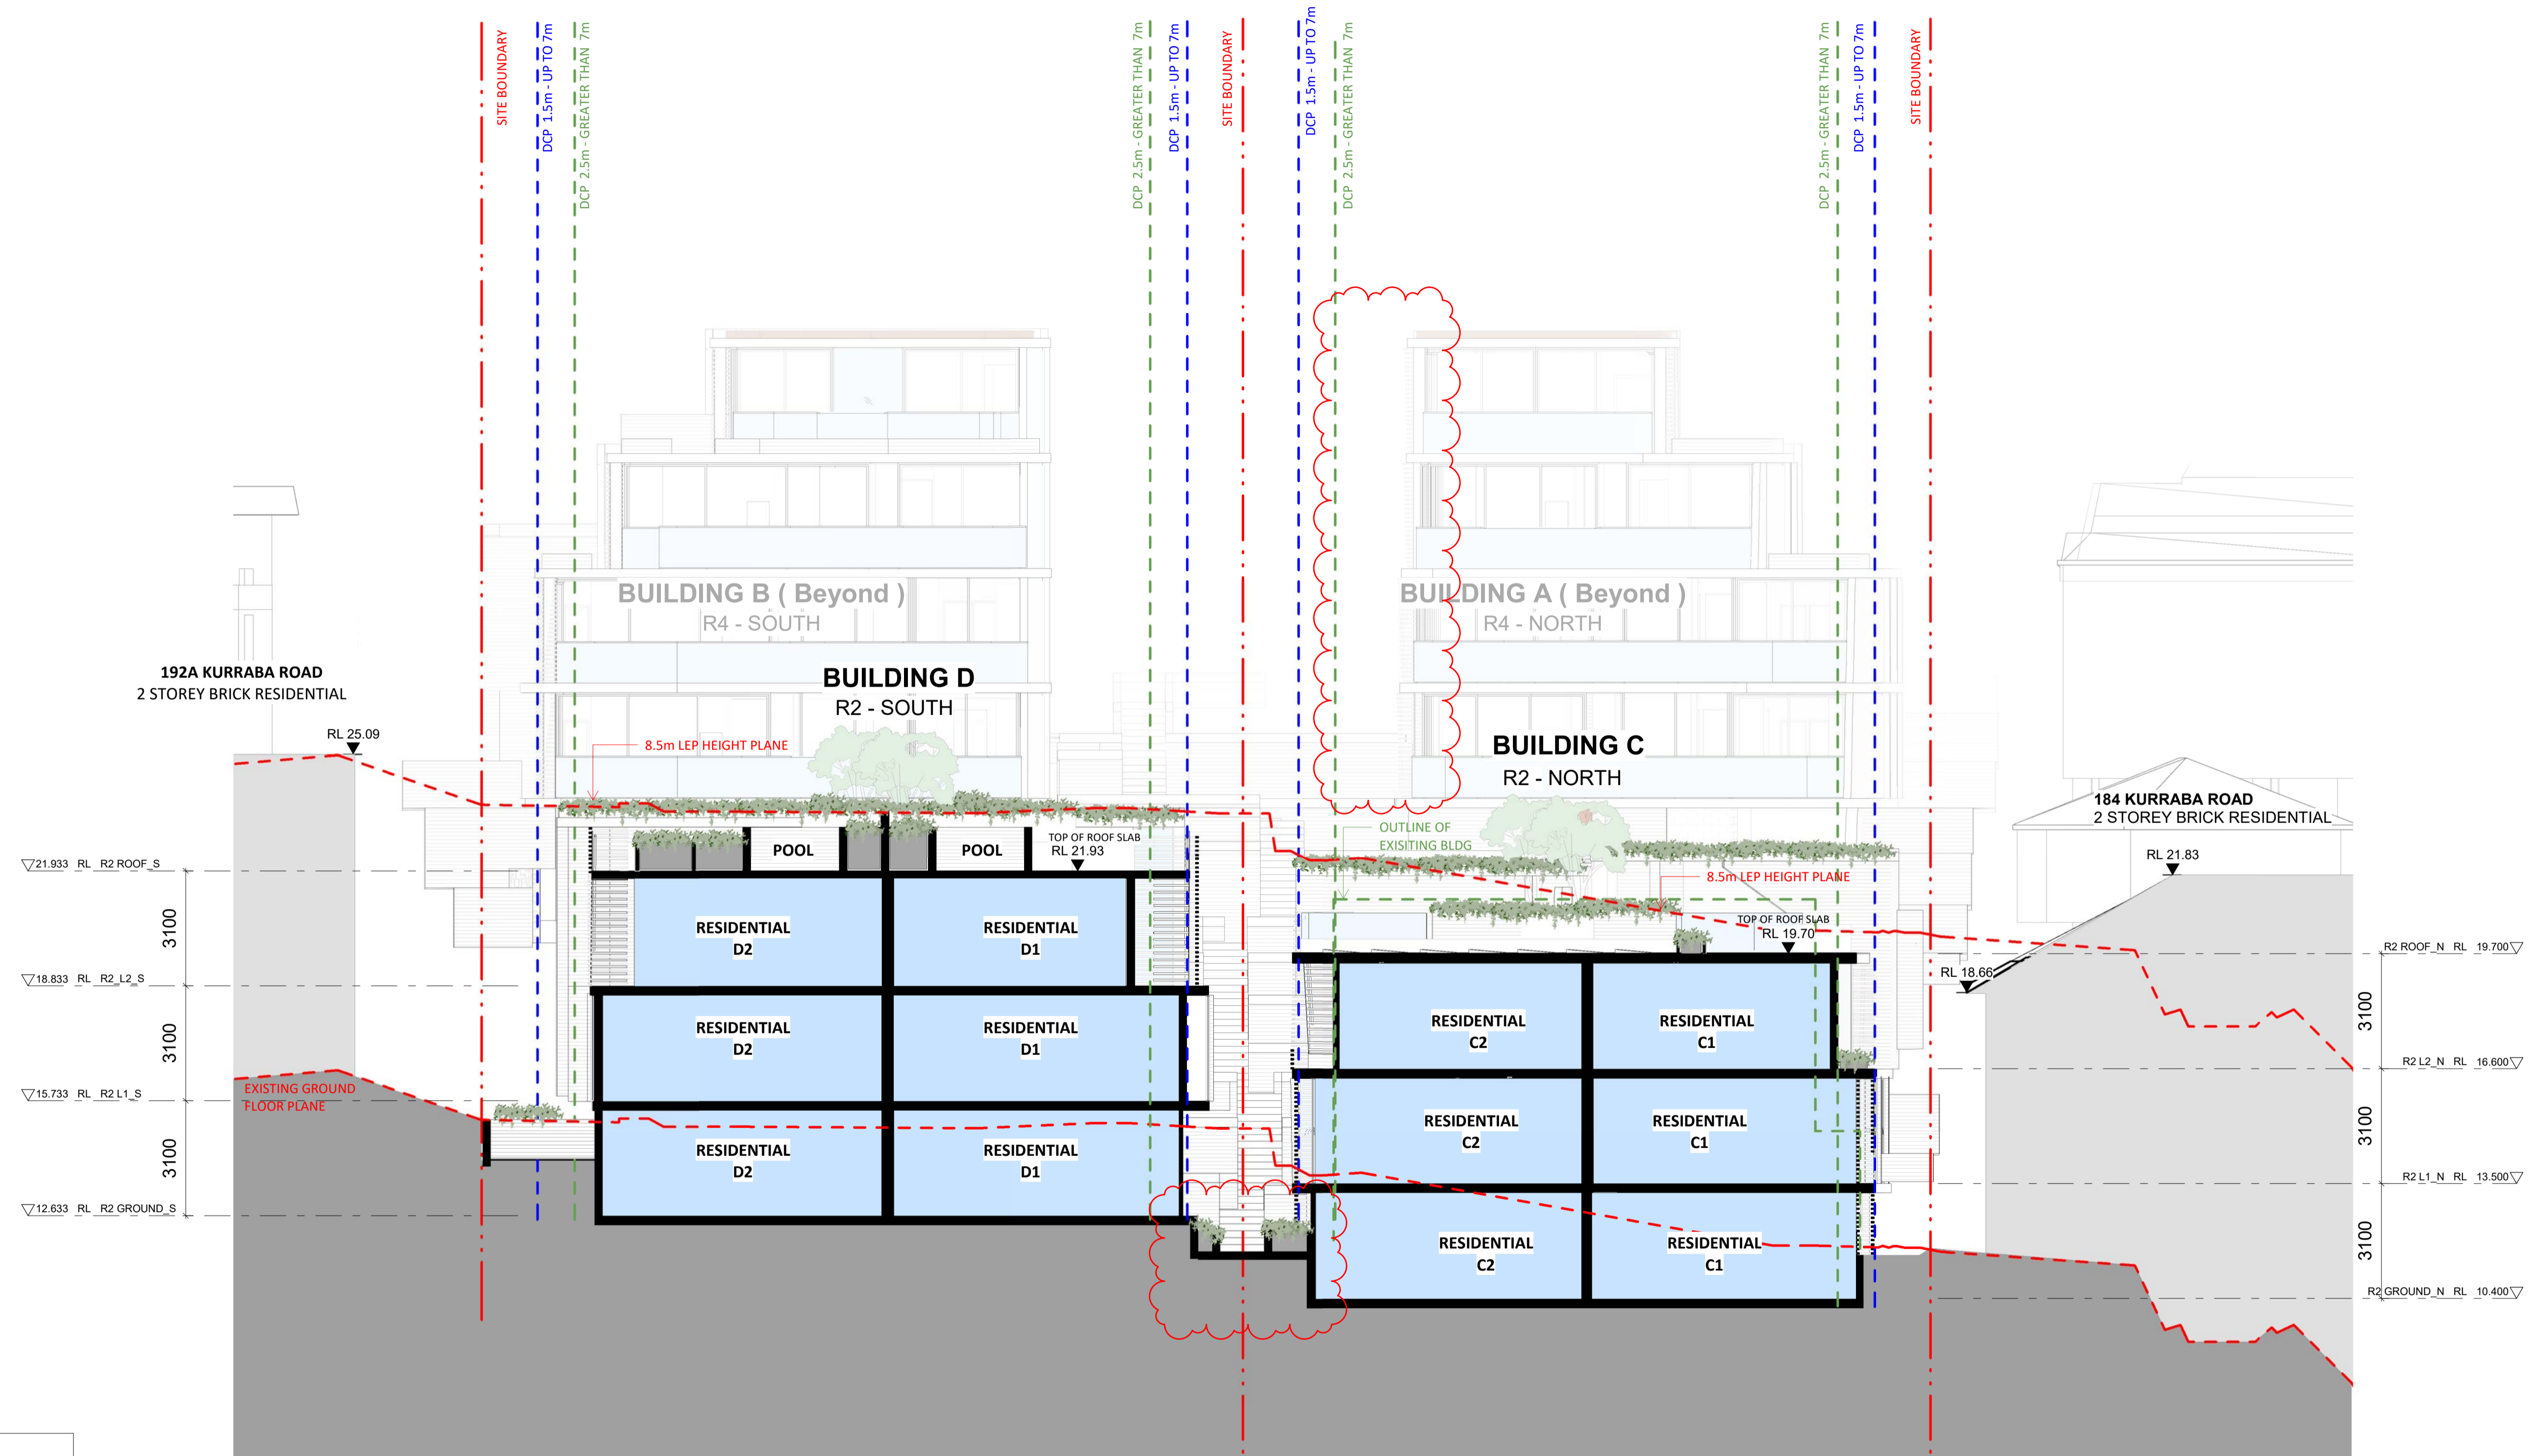

KEY

- SITE BOUNDARY
- SETBACK LINES
- RESIDENTIAL
- COMMUNAL
- CAR PARK

DIAGRAM LEGEND:

NOTE:
THE RED DOTTED LINES REPRESENTS HEIGHT PLANES REFLECTING THE SURVEYED GROUND WITH EXISTING STRUCTURES OMITTED, IN ACCORDANCE WITH BETTAR V COUNCIL

NO.	REVISION	BY	CHK	DATE
1	FOR INFORMATION			18.11.2021
2	FOR INFORMATION			08.12.2021
3	PRE-LODGE			20.01.2022
4	COORDINATION ISSUE			09.02.2022
5	AMENDED COORDINATION ISSUE	AL	RPW	19.05.2022
6	DA ISSUE	RPW	JAC	08.06.2022
7	COUNCIL RFI COORDINATION ISSUE	AL/DK/RPW		31.07.2023
8	COUNCIL RFI ISSUE	AL/DK/RPW		15.08.2023
9	ISSUE FOR DA RESUBMISSION	AL	RPW	02.02.2024

REVISION NOTES:

KEY PLAN

CLOUD LEGEND

- REVISION
- ON HOLD

NOTES:
KOICHI TAKADA ARCHITECTS (KTA) RETAIN ALL COMMON LAW AND STATUTORY RIGHTS INCLUDING COPYRIGHT AND INTELLECTUAL PROPERTY RIGHTS TO THIS DOCUMENT.
THIS DOCUMENT MUST NOT BE EDITED, PARTIALLY EXTRACTED, REPRODUCED OR DISTRIBUTED IN ANY MANNER WITHOUT KTA'S EXPRESS WRITTEN CONSENT AND UNDER NO CIRCUMSTANCES SHALL THE TRANSFER OF THIS DOCUMENT BE DEEMED A SALE OR CONSTITUTE A TRANSFER OF ANY LICENCE TO USE THE DOCUMENT WITHOUT KTA'S KNOWLEDGE OR CONSENT.
THE PDF DOCUMENT STAMPED BY KTA AS A QA CONTROLLED DOCUMENT IS THE ONLY OFFICIAL VERSION OF THIS DOCUMENT AND IS STRICTLY SUBJECT TO COPYRIGHT.
THE CONTENT AND ACCURACY OF THE DOCUMENT IS STRICTLY LIMITED TO THAT DEPICTED IN THE QA CONTROLLED PDF. DO NOT MEASURE FROM THE ELECTRONIC OR HARD COPY VERSIONS OF THIS DOCUMENT.
VERIFY ALL DIMENSIONS ON SITE BEFORE COMMENCING SHOP DRAWINGS, FABRICATION, CONSTRUCTION OR INSTALLATION.

CLIENT
Kurraba Point Road Pty Ltd
430 TOORAK ROAD, TOORAK 3142

ARCHITECT
SUITE 41 & 42, LEVEL 4
61 MARLBOROUGH ST
SURRY HILLS, NSW 2010
T 02 9698 8510
ABN 63 131 365 896
NOMINATED ARCHITECT:
KOICHI TAKADA
NSW ARCHITECTS 6901
VIC ARCHITECTS 16179
QLD ARCHITECTS 5590
KOICHI TAKADA.COM

Koichi Takada Architects

GA STAMP

THIS DOCUMENT IS NOT SUITABLE OR APPROVED FOR CONSTRUCTION AT ANY TIME UNLESS KTA HAS NOTATED THE STATUS TITLE AS FOR CONSTRUCTION WITHOUT THE PRESENCE OF 'WIP', 'DRAFT' OR ANY OTHER FORM OF QUALIFICATION ON THE DOCUMENT.

PROJECT
190 KURRABA RD
190 KURRABA RD, KURRABA POINT NSW
2089

STATUS
DEVELOPMENT APPLICATION - RFI 01

SCALE
1:100@A1, 1:200@A3

DWG TITLE
SECTION 4 - R2 ZONE

DWG NO.
A304

REVISION
9

DATE
02.02.2024

COMPLIANCE SUMMARY - R4 ZONE

R4 NORTH SITE AREA:	658m ²	R4 NORTH SITE AREA (EASEMENT EXCLUDED):	622m ²
R4 SOUTH SITE AREA:	749m ²	R4 SOUTH SITE AREA:	749m ²
R4 TOTAL SITE AREA:	1407m ²	R4 TOTAL SITE AREA:	1371m ²

	PROPOSED R4 NORTH	PROPOSED R4 SOUTH	COMBINED R4	R4 CONTROL
SITE COVERAGE	279.9 m ² = 45%	329.3m ² =44.0%	609.2m² = 44.4%	Max 45% of combined site area (617m ²)
LANDSCAPE	243.9m ² = 39.2%	310.1m ² =41.4%	554m² = 40.4%	Min 40% of combined site area =548.4m ²
UNBUILT UPON AREA	98.2m ² = 15.8%	109.6m ² =14.6%	207.8m² = 15.2%	Max 15% of combined site area (205.7m ²)
EASEMENT	NOT INCLUDED	-	-	
SITE AREA	622 m ²	749 m ²	1371 m²	

COMPLIANCE SUMMARY - R2 ZONE


R2 NORTH SITE AREA:	924m ²
R2 SOUTH SITE AREA:	1012m ²
R2 TOTAL SITE AREA:	1936m ²

	PROPOSED R2 NORTH	PROPOSED R2 SOUTH	COMBINED R2	R2 CONTROL
SITE COVERAGE	400.1m ² = 43.3%	430.0m ² =42.5%	830.1m² =42.9%	North: Max 45% = 416m ² South: Max 45% = 455m ²
LANDSCAPE	421.8m ² = 45.7%	434.3m ² =42.9%	856.1m² =44.2%	North: Min Total Landscape 40% = 370m ² South: Min Total Landscape 40% = 405m ²
UNBUILT UPON AREA	102.1m ² = 11%	147.7m ² =14.6%	249.8m² = 12.9%	North: Max 15% = 139m ² South: Max 15% = 152m ²
SITE AREA	924 m ²	1012 m ²	1936 m²	

COMPLIANCE SUMMARY - TOTAL SITE

TOTAL SITE AREA (EASEMENT EXCLUDED): 3,307m²

	TOTAL SITE	CONTROL
SITE COVERAGE	1439.3m ² = 43.5%	Max 45% of combined site area (1488m ²)
LANDSCAPE	1413.9m ² = 42.8%	Min 40% of combined site area =1323m ²
UNBUILT UPON AREA	453.8m ² = 13.7%	Max 15% of combined site area (496m ²)
SITE AREA	3,307 m ²	

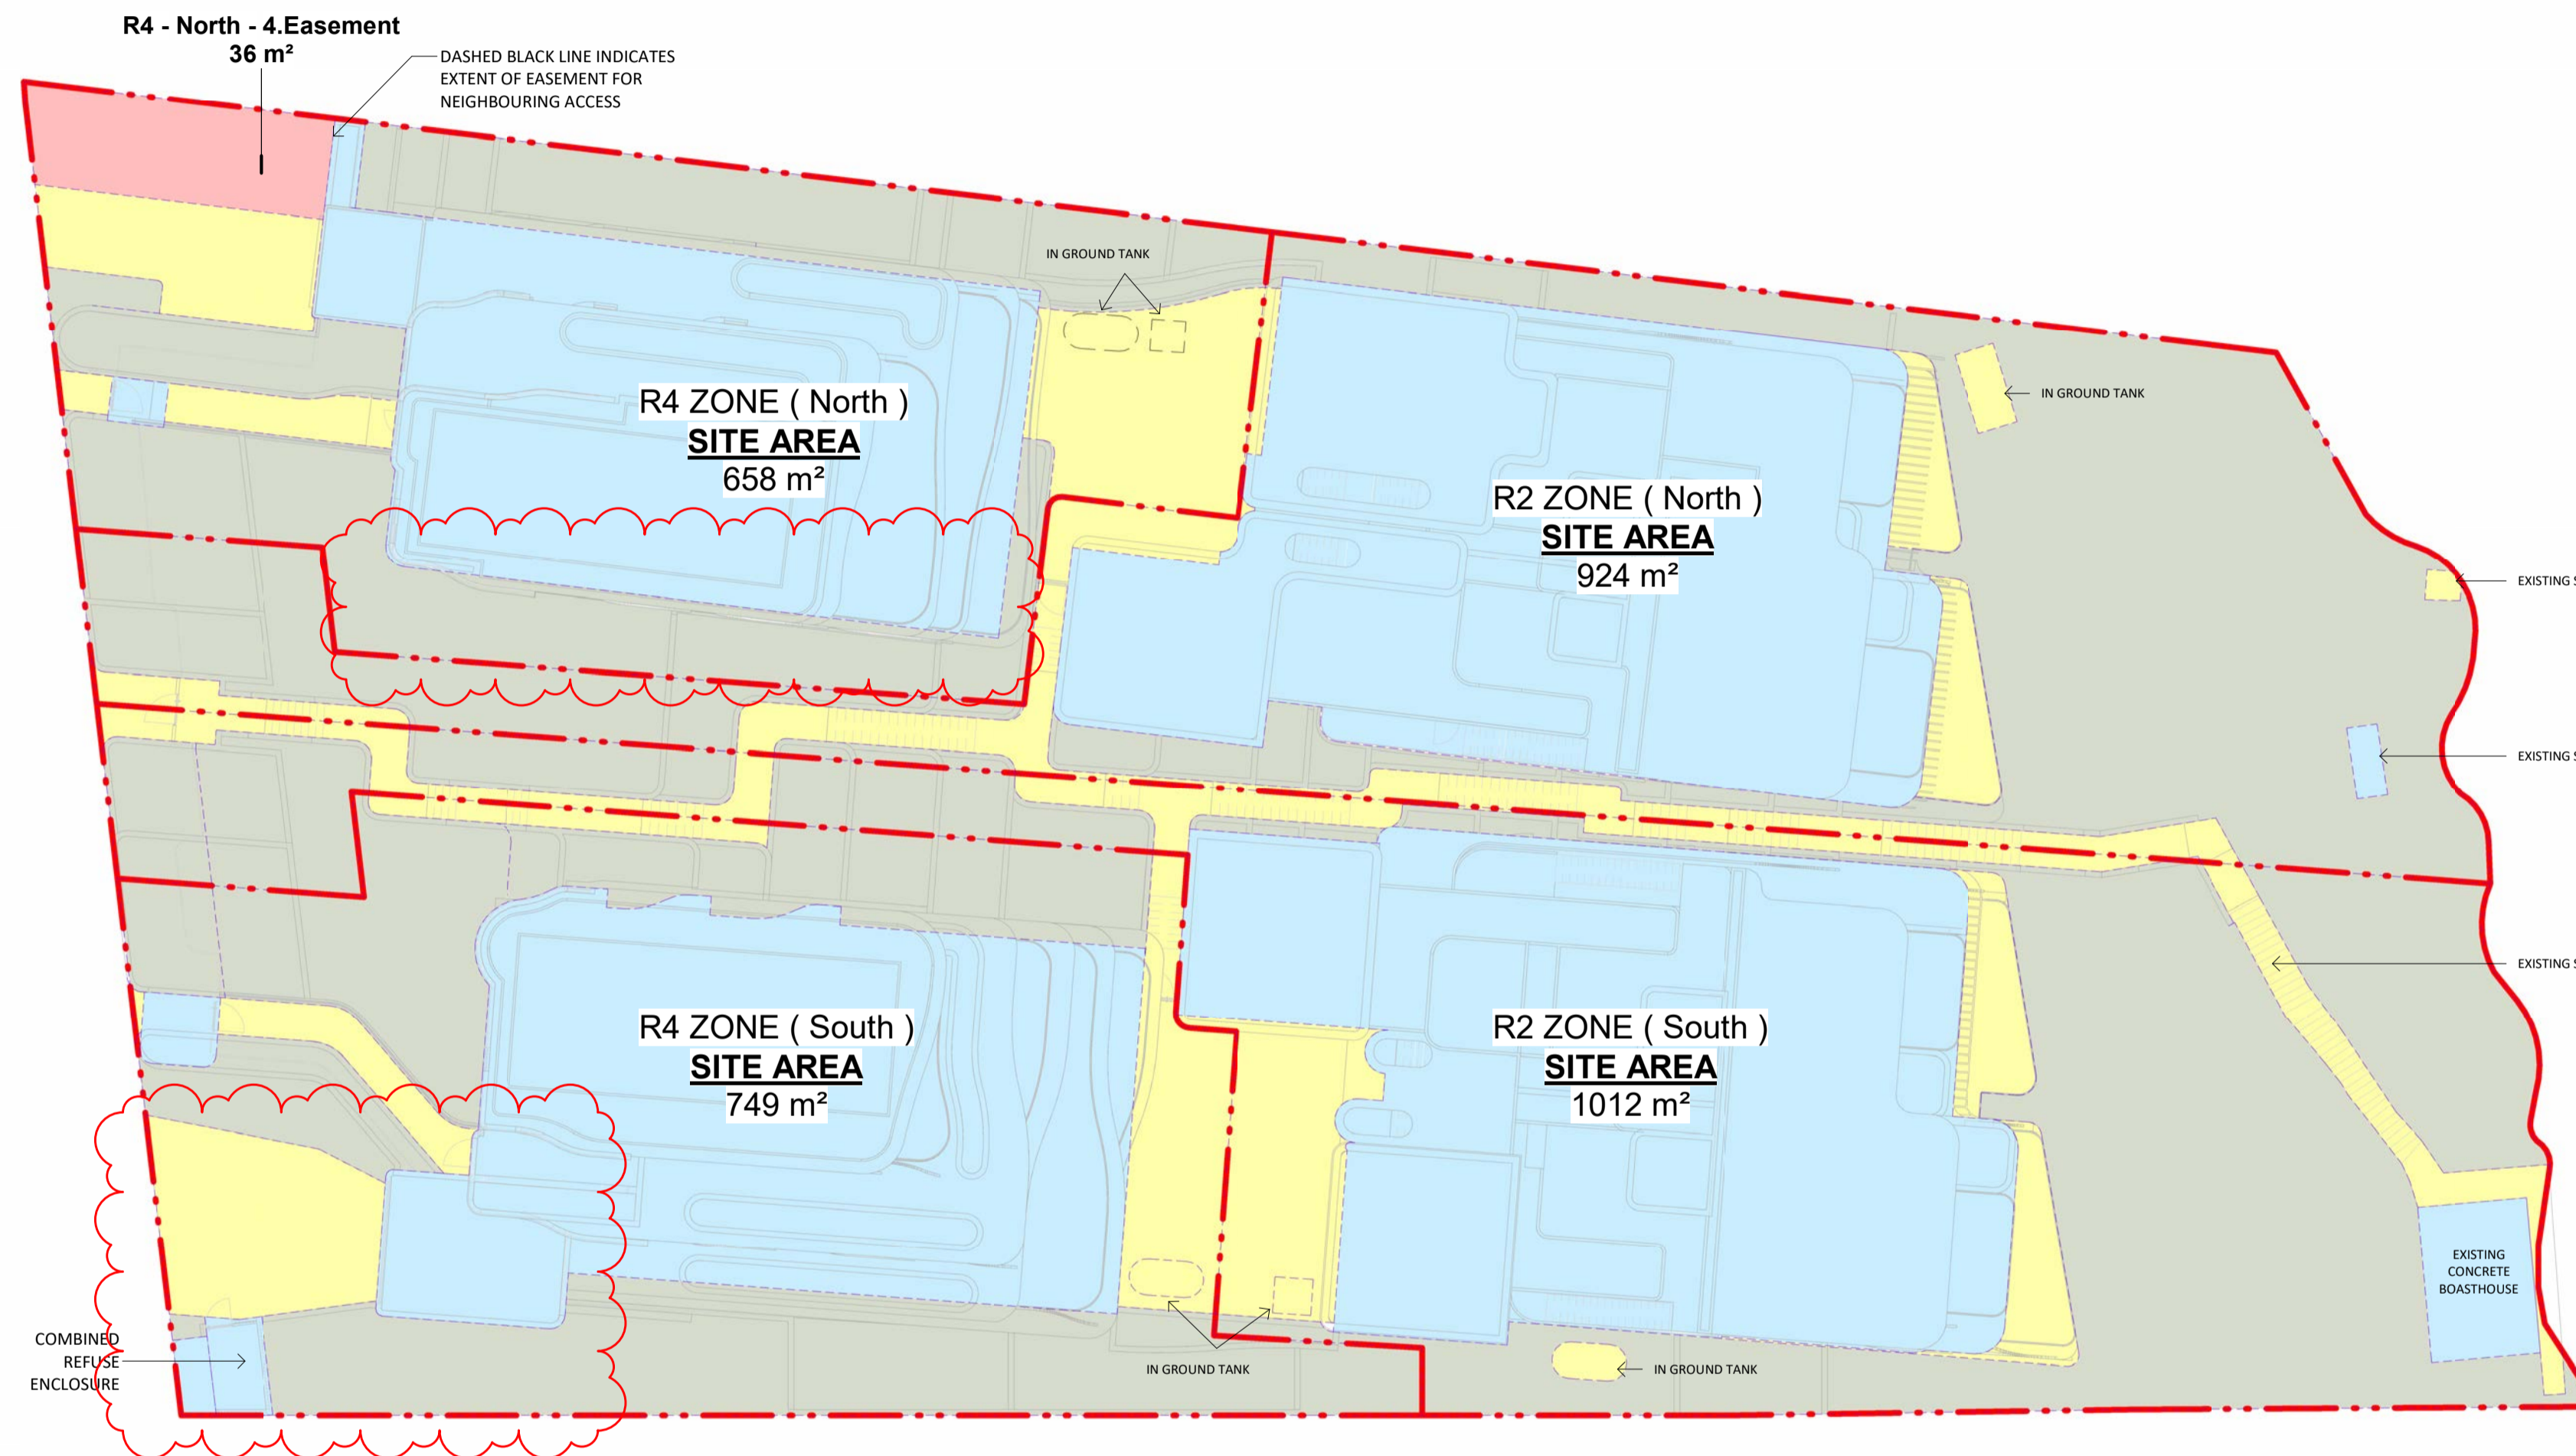

- SITE COVERAGE
- LANDSCAPE
- UNBUILT UPON AREA

NO.	REVISION	BY	CHK	DATE	REVISION NOTES:
1	AMENDED COORDINATION ISSUE	AL	RPW	19.05.2022	
2	RA ISSUE	RPW	AL	18.05.2022	
3	RFI Mark ups	RPW	AL	30.06.2023	
4	Amended RFI Markups	RPW	RPW	07.07.2023	
5	COUNCIL RFI COORDINATION ISSUE	AL/CK	RPW	31.07.2023	
6	COUNCIL RFI ISSUE	AL/CK	RPW	15.08.2023	
7	ISSUE FOR DA RESUBMISSION	AL	RPW	02.02.2024	

KEY PLAN
CLOUD LEGEND
REVISION
ON HOLD

NOTES:
 KOICHI TAKADA ARCHITECTS (KTA) RETAIN ALL COMMON LAW AND STATUTORY RIGHTS INCLUDING COPYRIGHT AND INTELLECTUAL PROPERTY RIGHTS TO THIS DOCUMENT.
 THIS DOCUMENT MUST NOT BE EDITED, PARTIALLY EXTRACTED, REPRODUCED OR DISTRIBUTED IN ANY MANNER WITHOUT KTA'S EXPRESS WRITTEN CONSENT AND UNDER NO CIRCUMSTANCES SHALL THE TRANSFER OF THIS DOCUMENT BE DEEMED A SALE OR CONSTITUTE A TRANSFER OF ANY LICENCE TO USE THE DOCUMENT WITHOUT KTA'S KNOWLEDGE OR CONSENT.
 THE PDF DOCUMENT STAMPED BY KTA AS A 'QA CONTROLLED DOCUMENT' IS THE ONLY OFFICIAL VERSION OF THIS DOCUMENT AND IS STRICTLY SUBJECT TO COPYRIGHT.
 THE CONTENT AND ACCURACY OF THE DOCUMENT IS STRICTLY LIMITED TO THAT DEPICTED IN THE 'QA CONTROLLED PDF'. DO NOT MEASURE FROM THE ELECTRONIC OR HARD COPY VERSIONS OF THIS DOCUMENT.
 VERIFY ALL DIMENSIONS ON SITE BEFORE COMMENCING SHOP DRAWINGS, FABRICATION, CONSTRUCTION OR INSTALLATION.

CLIENT
 Kurraba Point Road Pty Ltd
 430 TOORAK ROAD, TOORAK 3142

ARCHITECT
 SUITE 41 & 42, LEVEL 4
 61 MARLBOROUGH ST
 SURRY HILLS, NSW 2010
 T 02 9698 8510
 ABN 63 131 365 896
 NOMINATED ARCHITECT:
 KOICHI TAKADA
 NSW ARCHITECTS 6901
 VIC ARCHITECTS 16179
 QLD ARCHITECTS 5590
 KOICHI TAKADA.COM

Koichi Takada Architects

GA STAMP
 THIS DOCUMENT IS NOT SUITABLE OR APPROVED FOR CONSTRUCTION AT ANY TIME UNLESS KTA HAVE NOTATED THE STATUS/TITLE AS FOR CONSTRUCTION WITHOUT THE PRESENCE OF 'WIP', 'DRAFT' OR ANY OTHER FORM OF QUALIFICATION ON THE DOCUMENT.

PROJECT
 190 KURRABA RD
 190 KURRABA RD, KURRABA POINT NSW
 2089

STATUS
 DEVELOPMENT APPLICATION - RFI 01

SCALE
 1:200@A1, 1:400@A3

DWG TITLE	DWG NO.	REVISION	DATE
COMBINED SITE CALCULATIONS	A401	7	02.02.2024



LANDSCAPE AREA DIAGRAM


LANDSCAPE COMPLIANCE SUMMARY - R4 ZONE

	PROPOSED R4 NORTH	PROPOSED R4 SOUTH	COMBINED R4	R4 CONTROL
SITE AREA	622 m² (EASEMENT EXCL.)	749 m²	1371 m² (EASEMENT EXCL.)	
DEEP SOIL LANDSCAPE	243.9m² = 39.2%	310.1m² = 41.4%	554m² = 40.4%	Min Total Landscape Area 40% of combined site area = 548m²
LANDSCAPE ON STRUCTURE	89.1m² = 14.3%	145.8m² = 19.5%	234.9m² = 17.1%	

LANDSCAPE COMPLIANCE SUMMARY - R2 ZONE

	PROPOSED R2 NORTH	PROPOSED R2 SOUTH	COMBINED R2	R2 CONTROL
SITE AREA	924 m²	1012 m²	1936 m²	
DEEP SOIL LANDSCAPE	423.6m² = 45.8%	436.3m² = 43.1%	859.9m² = 44.4%	North: Min Total Landscape 40% = 370m² South: Min Total Landscape 40% = 405m²
LANDSCAPE ON STRUCTURE	263.9m² = 28.6%	248.7m² = 24.6%	512.6m² = 26.5%	North: Min Total Landscape 40% = 370m² South: Min Total Landscape 40% = 405m²

- DEEP SOIL LANDSCAPING
- LANDSCAPE ON STRUCTURE

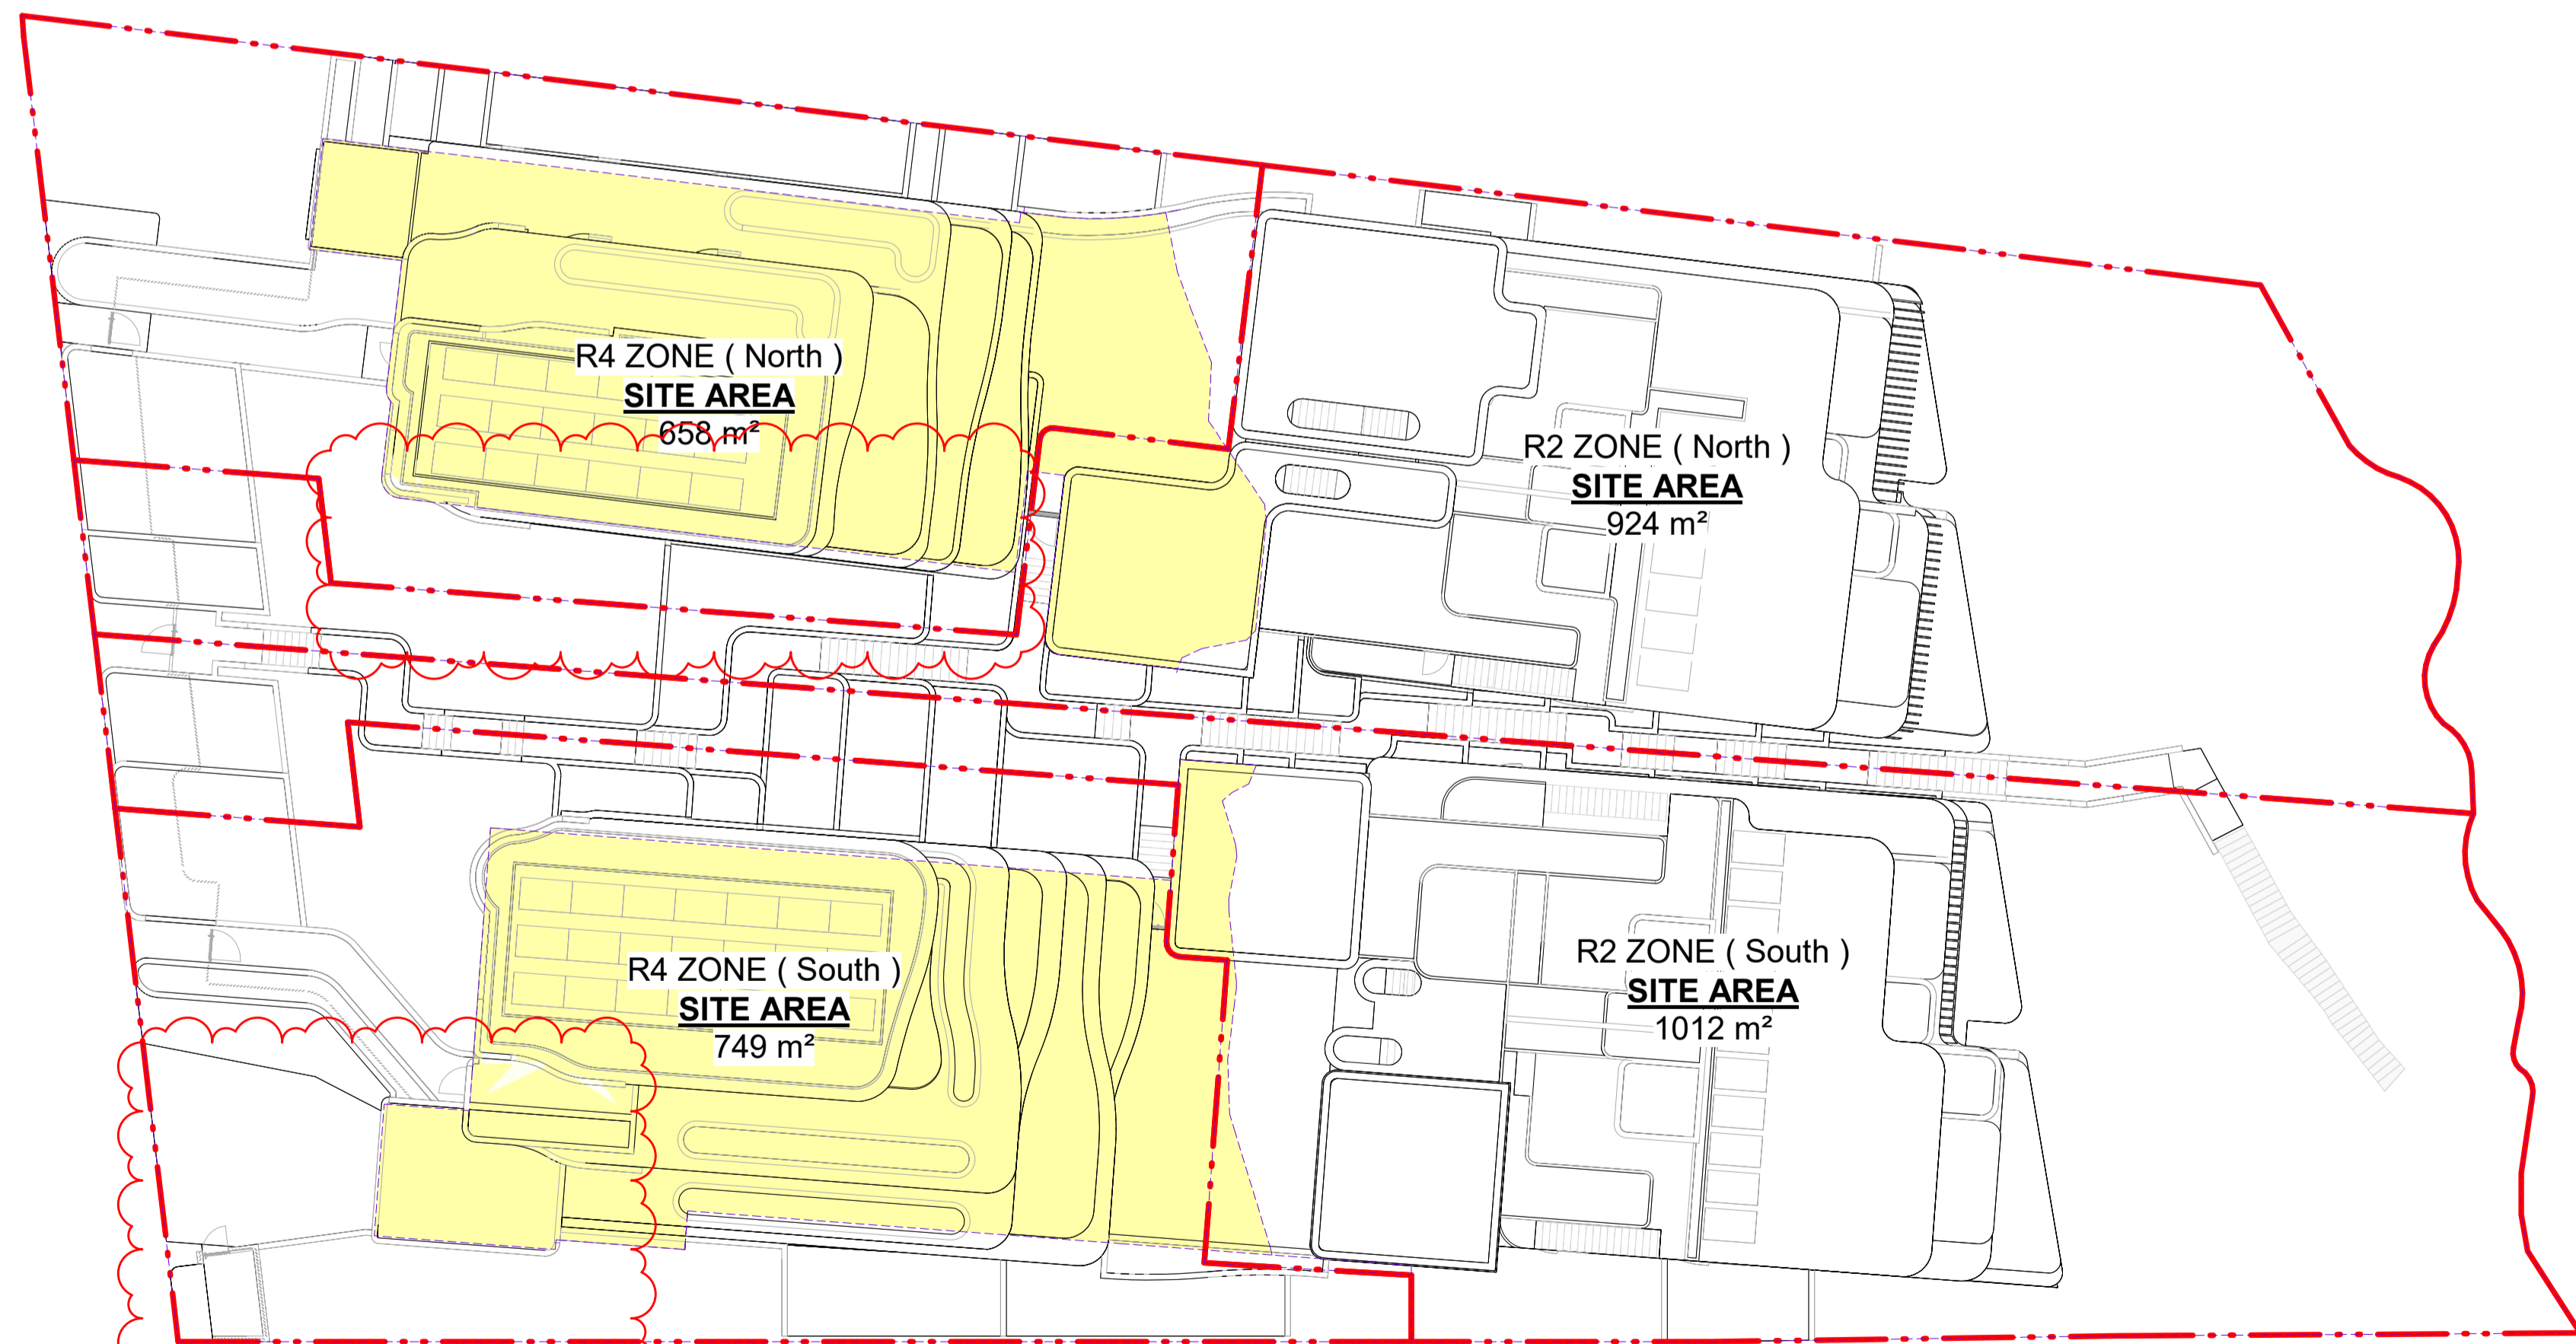

EXCAVATION AREA DIAGRAM

EXCAVATION COMPLIANCE SUMMARY - R4 ZONE (AREA EXCAVATED FOR CAR PARKING ONLY)

	PROPOSED R4 NORTH	PROPOSED R4 SOUTH	COMBINED R4	R4 CONTROL
SITE AREA	622 m² (EASEMENT EXCL.)	749 m²	1371 m² (EASEMENT EXCL.)	
EXCAVATED AREA	323.7m² = 52.0%	349.2m² = 46.6%	672.9m² = 49.1%	Max 70% of Combined Site = 960m²

EXCAVATION COMPLIANCE SUMMARY - R2 ZONE (AREA EXCAVATED FOR CAR PARKING ONLY)

	PROPOSED R2 NORTH	PROPOSED R2 SOUTH	COMBINED R2	R2 CONTROL
SITE AREA	924 m²	1012 m²	1936 m²	
EXCAVATED AREA	53.5m² = 5.8%	23.1m² = 2.3%	76.6m² = 3.9%	North: Max 70% of Site Area = 647m² South: Max 70% of Site Area = 708m²

- AREA EXCAVATED FOR CAR PARKING

NO.	REVISION	BY	CHK	DATE	REVISION NOTES:
1	AMENDED COORDINATION ISSUE	AL	RPW	19.05.2022	
2	DA ISSUE	AL	RPW	18.05.2022	
3	COUNCIL RFI COORDINATION ISSUE	AL/DR	RPW	31.07.2023	
4	COUNCIL RFI ISSUE	AL/DR	RPW	15.08.2023	
5	ISSUE FOR DA RESUBMISSION	AL	RPW	02.02.2024	

KEY PLAN	NOTES:
	KOICHI TAKADA ARCHITECTS (KTA) RETAIN ALL COMMON LAW AND STATUTORY RIGHTS INCLUDING COPYRIGHT AND INTELLECTUAL PROPERTY RIGHTS TO THIS DOCUMENT. THIS DOCUMENT MUST NOT BE EDITED, PARTIALLY EXTRACTED, REPRODUCED OR DISTRIBUTED IN ANY MANNER WITHOUT KTA'S EXPRESS WRITTEN CONSENT AND UNDER NO CIRCUMSTANCES SHALL THE TRANSFER OF THIS DOCUMENT BE DEEMED A SALE OR CONSTITUTE A TRANSFER OF ANY LICENCE TO USE THE DOCUMENT. THE PDF DOCUMENT STAMPED BY KTA AS A QA CONTROLLED DOCUMENT IS THE ONLY OFFICIAL VERSION OF THIS DOCUMENT AND IS STRICTLY SUBJECT TO COPYRIGHT ©. THE CONTENT AND ACCURACY OF THE DOCUMENT IS STRICTLY LIMITED TO THAT SHOWN IN THE QA CONTROLLED PDF. DO NOT MEASURE FROM THE ELECTRONIC OR HARD COPY VERSIONS OF THIS DOCUMENT. VERIFY ALL DIMENSIONS ON SITE BEFORE COMMENCING SHOP DRAWINGS, FABRICATION, CONSTRUCTION OR INSTALLATION.

CLIENT	ARCHITECT
Kurraba Point Road Pty Ltd 430 TOORAK ROAD, TOORAK 3142	SUITE 41 & 42, LEVEL 4 61 MARLBOROUGH ST SURREY HILLS, NSW 2010 T 02 9698 8510 ASN 63 131 365 896 NOMINATED ARCHITECT: KOICHI TAKADA NSW ARCHITECTS 6901 VIC ARCHITECTS 16179 QLD ARCHITECTS 5590 KOICHI TAKADA.COM

Koichi Takada Architects


THIS DOCUMENT IS NOT SUITABLE OR APPROVED FOR CONSTRUCTION AT ANY TIME UNLESS KTA HAVE NOTATED THE STATUS TITLE AS FOR CONSTRUCTION WITHOUT THE PRESENCE OF 'WIP', 'DRAFT' OR ANY OTHER FORM OF QUALIFICATION ON THE DOCUMENT.

PROJECT	DWG TITLE
190 KURRABA RD 190 KURRABA RD, KURRABA POINT NSW 2089	LANDSCAPE & EXCAVATION AREA CALCULATION


STATUS	DWG NO.	REVISION
DEVELOPMENT APPLICATION - RFI 01	A403	5

SCALE	DATE
1:200@A1, 1:400@A3	02.02.2024

GA STAMP

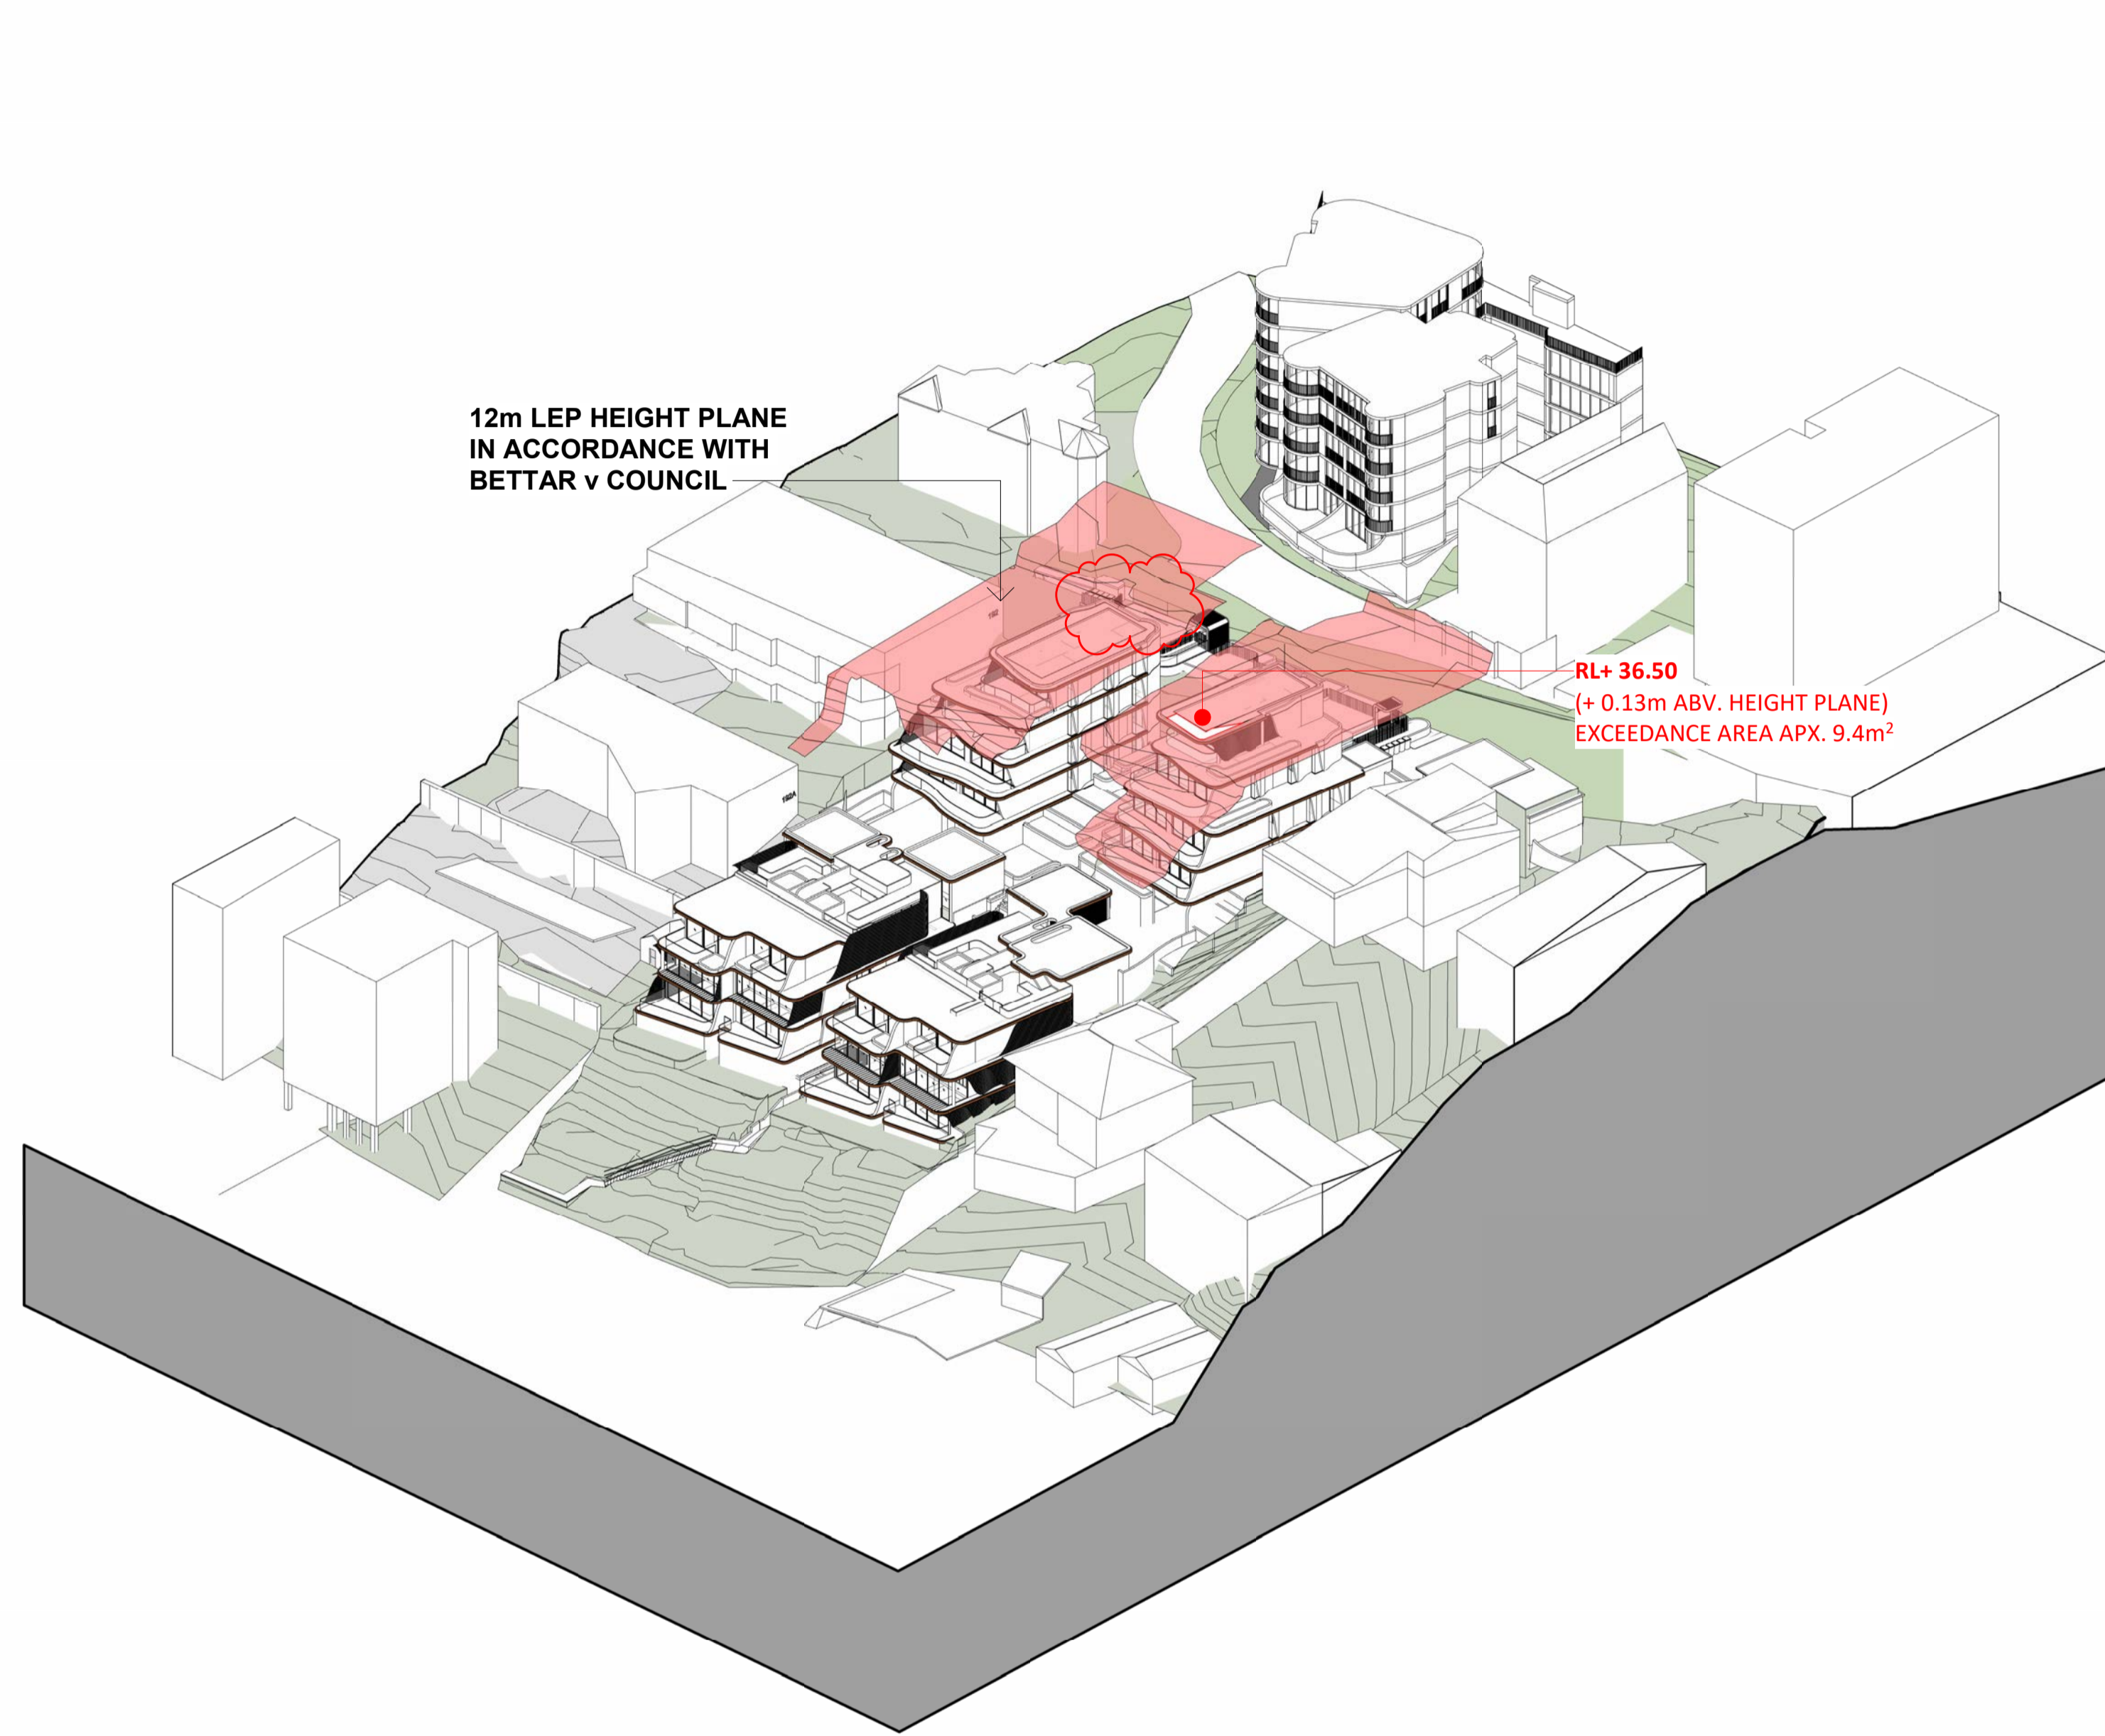

R4 HEIGHT PLANE DIAGRAM - 12m ABOVE EXISTING GROUND LEVEL (VIEW 1)

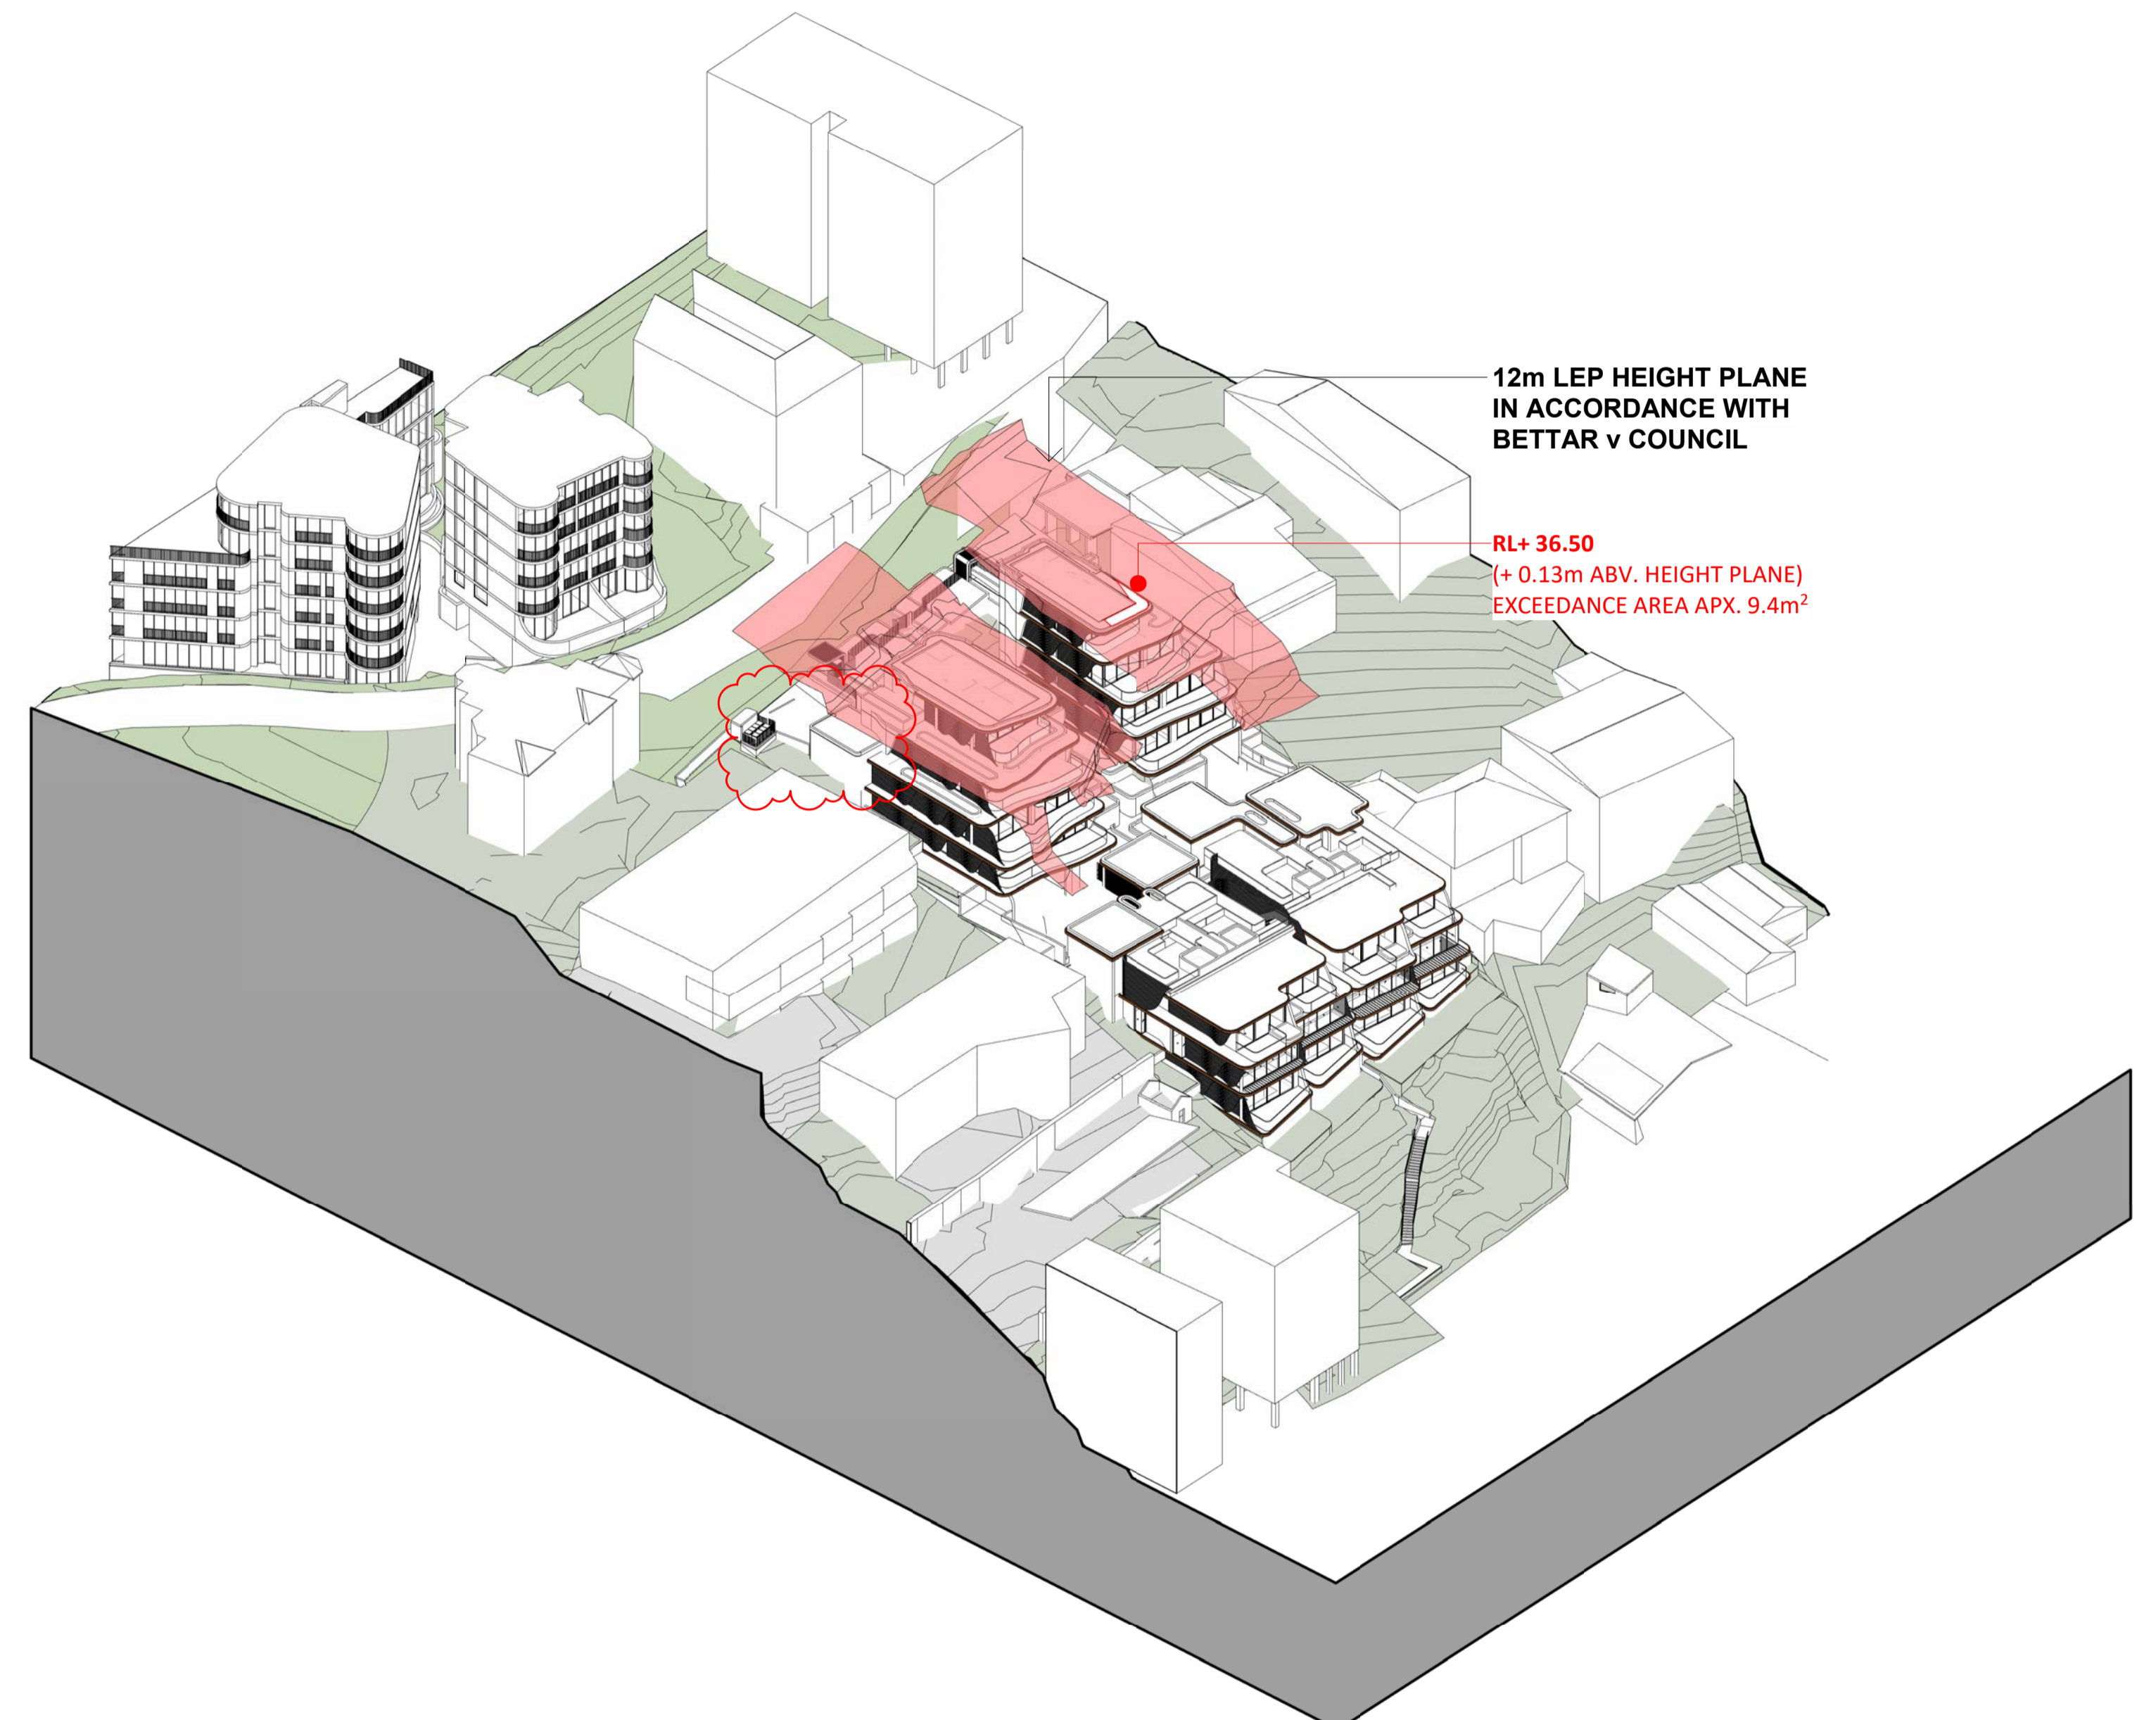

R4 HEIGHT PLANE DIAGRAM - 12m ABOVE EXISTING GROUND LEVEL (VIEW 2)

DIAGRAM LEGEND:

NOTE:
THE DIAGRAMS ABOVE REPRESENT A 12m HEIGHT PLANE REFLECTING THE R4 ZONE SURVEYED GROUND IN ACCORDANCE WITH BETTAR v COUNCIL

NO.	REVISION	BY	CHK	DATE	REVISION NOTES:
1	PRE-LODGE			20.01.2022	
2	COORDINATION ISSUE			09.02.2023	
3	AMENDED COORDINATION ISSUE	AL	RPW	19.05.2022	
4	DA ISSUE	RPW	AL	08.05.2022	
5	COUNCIL RFI COORDINATION ISSUE	AL	RPW	31.07.2023	
6	COUNCIL RFI ISSUE	AL	RPW	15.08.2023	
7	ISSUE FOR PLANNING REPORT	AL	RPW	31.01.2024	
8	ISSUE FOR DA RESUBMISSION	AL	RPW	02.02.2024	

KEY PLAN
CLOUD LEGEND
REVISION
ON HOLD

NOTES:
KOICHI TAKADA ARCHITECTS (KTA) RETAIN ALL COMMON LAW AND STATUTORY RIGHTS INCLUDING COPYRIGHT AND INTELLECTUAL PROPERTY RIGHTS TO THIS DOCUMENT.
THIS DOCUMENT MUST NOT BE EDITED, PARTIALLY EXTRACTED, REPRODUCED OR DISTRIBUTED IN ANY MANNER WITHOUT KTA'S EXPRESS WRITTEN CONSENT AND UNDER NO CIRCUMSTANCES SHALL THE TRANSFER OF THIS DOCUMENT BE DEEMED A SALE OR CONSTITUTE A TRANSFER OF ANY LICENCE TO USE THE DOCUMENT.
THE PDF DOCUMENT STAMPED BY KTA AS A 'QA CONTROLLED DOCUMENT' IS THE ONLY OFFICIAL VERSION OF THIS DOCUMENT AND IS STRICTLY SUBJECT TO COPYRIGHT.
THE CONTENT AND ACCURACY OF THE DOCUMENT IS STRICTLY LIMITED TO THAT DEPICTED IN THE QA CONTROLLED PDF.
DO NOT MEASURE FROM THE ELECTRONIC OR HARD COPY VERSIONS OF THIS DOCUMENT.
VERIFY ALL DIMENSIONS ON SITE BEFORE COMMENCING SHOP DRAWINGS, FABRICATION, CONSTRUCTION OR INSTALLATION.

CLIENT
Kurraba Point Road Pty Ltd
430 TOORAK ROAD, TOORAK 3142

ARCHITECT
SUITE 41 & 42, LEVEL 4
61 MARLBOROUGH ST
SURRY HILLS, NSW 2010
T 02 9698 8510
ABN 63 131 365 896
NOMINATED ARCHITECT:
KOICHI TAKADA
NSW ARCHITECTS 6901
VIC ARCHITECTS 16179
QLD ARCHITECTS 5590
KOICHI TAKADA.COM

Koichi Takada Architects

PROJECT
190 KURRABA RD
190 KURRABA RD, KURRABA POINT NSW 2089

STATUS
DEVELOPMENT APPLICATION - RFI 01

DWG TITLE
HEIGHT PLANE DIAGRAMS (BETTAR) - R4 ZONE

DWG NO.
A410

SCALE

REVISION
8

DATE
02.02.2024

THIS DOCUMENT IS NOT SUITABLE OR APPROVED FOR CONSTRUCTION AT ANY TIME UNLESS KTA HAVE NOTATED THE STATUS TITLE AS FOR CONSTRUCTION WITHOUT THE PRESENCE OF 'WIP', 'DRAFT' OR ANY OTHER FORM OF QUALIFICATION ON THE DOCUMENT.



DIAGRAM LEGEND:

NOTE:
THE DIAGRAMS ABOVE REPRESENT A 12m HEIGHT PLANE REFLECTING THE R4 ZONE SURVEYED GROUND IN ACCORDANCE WITH BETTAR V COUNCIL

NO.	REVISION	BY	CHK	DATE	REVISION NOTES:
1	PRE-LODGE			20.01.2022	
2	COORDINATION ISSUE			09.02.2023	
3	DA ISSUE	RPW	JAC	08.06.2022	
4	COUNCIL RFI COORDINATION ISSUE	ALDR	RPW	31.07.2023	
5	COUNCIL RFI ISSUE	ALDR	RPW	15.08.2023	
6	ISSUE FOR PLANNING REPORT	AL	RPW	31.01.2024	
7	ISSUE FOR DA RESUBMISSION	AL	RPW	02.02.2024	

KEY PLAN

NOTES:
KOICHI TAKADA ARCHITECTS (KTA) RETAIN ALL COMMON LAW AND STATUTORY RIGHTS INCLUDING COPYRIGHT AND INTELLECTUAL PROPERTY RIGHTS TO THIS DOCUMENT.
THIS DOCUMENT MUST NOT BE EDITED, PARTIALLY EXTRACTED, REPRODUCED OR DISTRIBUTED IN ANY MANNER WITHOUT KTA'S EXPRESS WRITTEN CONSENT AND UNDER NO CIRCUMSTANCES SHALL THE TRANSFER OF THIS DOCUMENT BE DEEMED A SALE OR CONSTITUTE A TRANSFER OF ANY LICENCE TO USE THE DOCUMENT WITHOUT KTA'S KNOWLEDGE OR CONSENT.
THE PDF DOCUMENT STAMPED BY KTA AS A 'QA CONTROLLED DOCUMENT' IS THE ONLY OFFICIAL VERSION OF THIS DOCUMENT AND IS STRICTLY SUBJECT TO COPYRIGHT ©.
THE CONTENT AND ACCURACY OF THE DOCUMENT IS STRICTLY LIMITED TO THAT SPECIFIED IN THE 'QA CONTROLLED PDF'. DO NOT MEASURE FROM THE ELECTRONIC OR HARD COPY VERSIONS OF THIS DOCUMENT.
VERIFY ALL DIMENSIONS ON SITE BEFORE COMMENCING SHOP DRAWINGS, FABRICATION, CONSTRUCTION OR INSTALLATION.

CLIENT:
Kurraba Point Road Pty Ltd
430 TOORAK ROAD, TOORAK 3142

ARCHITECT:
SUITE 41 & 42, LEVEL 4
61 MARLBOROUGH ST
SURRY HILLS, NSW 2010
T 02 9698 8510
ABN 63 131 365 696
NOMINATED ARCHITECT:
KOICHI TAKADA
NSW ARCHITECTS 6901
VIC ARCHITECTS 16179
QLD ARCHITECTS 5590
KOICHIKAKADA.COM

PROJECT:
190 KURRABA RD
190 KURRABA RD, KURRABA POINT NSW
2089


STATUS:
DEVELOPMENT APPLICATION - RFI 01

ARCHITECT:
Koichi Takada Architects


GA STAMP:
THIS DOCUMENT IS NOT SUITABLE OR APPROVED FOR CONSTRUCTION AT ANY TIME UNLESS KTA HAVE NOTATED THE STATUS TITLE AS FOR CONSTRUCTION WITHOUT THE PRESENCE OF 'WIP', 'DRAFT' OR ANY OTHER FORM OF QUALIFICATION ON THE DOCUMENT.

DWG TITLE:
HEIGHT PLANE PLAN (BETTAR) - R4 ZONE

DWG NO.	REVISION
A411	7
SCALE	DATE
	02.02.2024

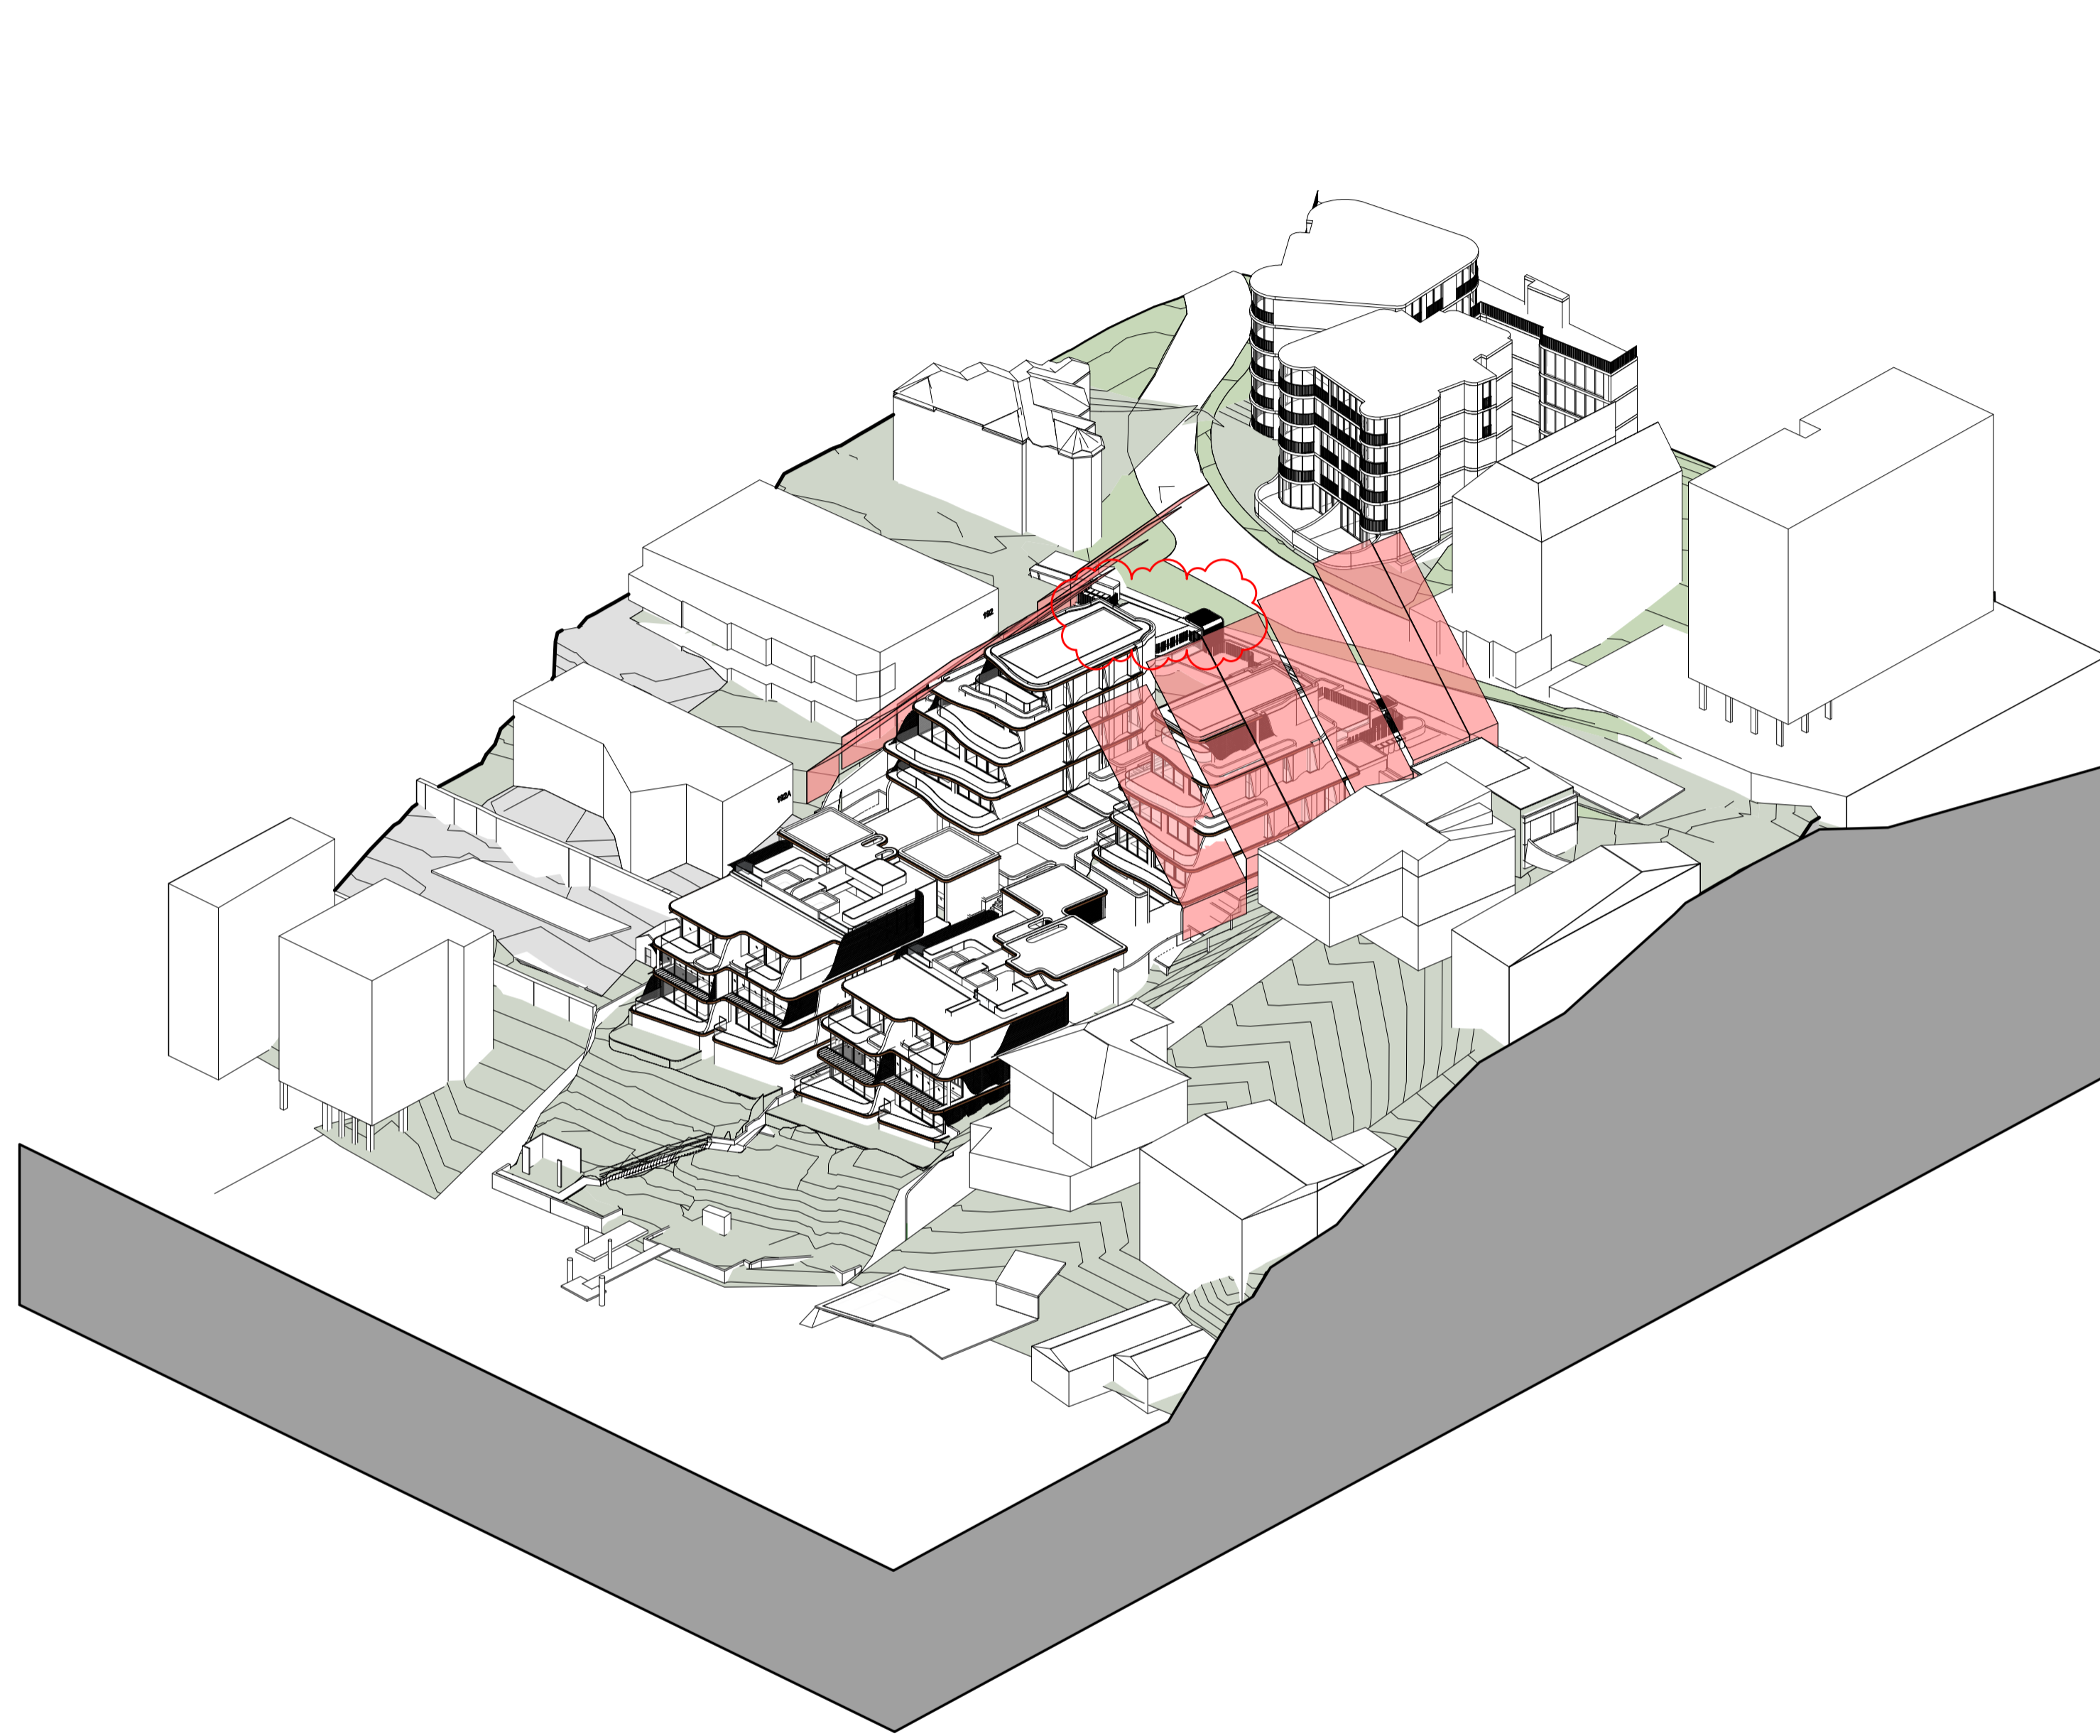

DCP ENVELOPE (VIEW 1)

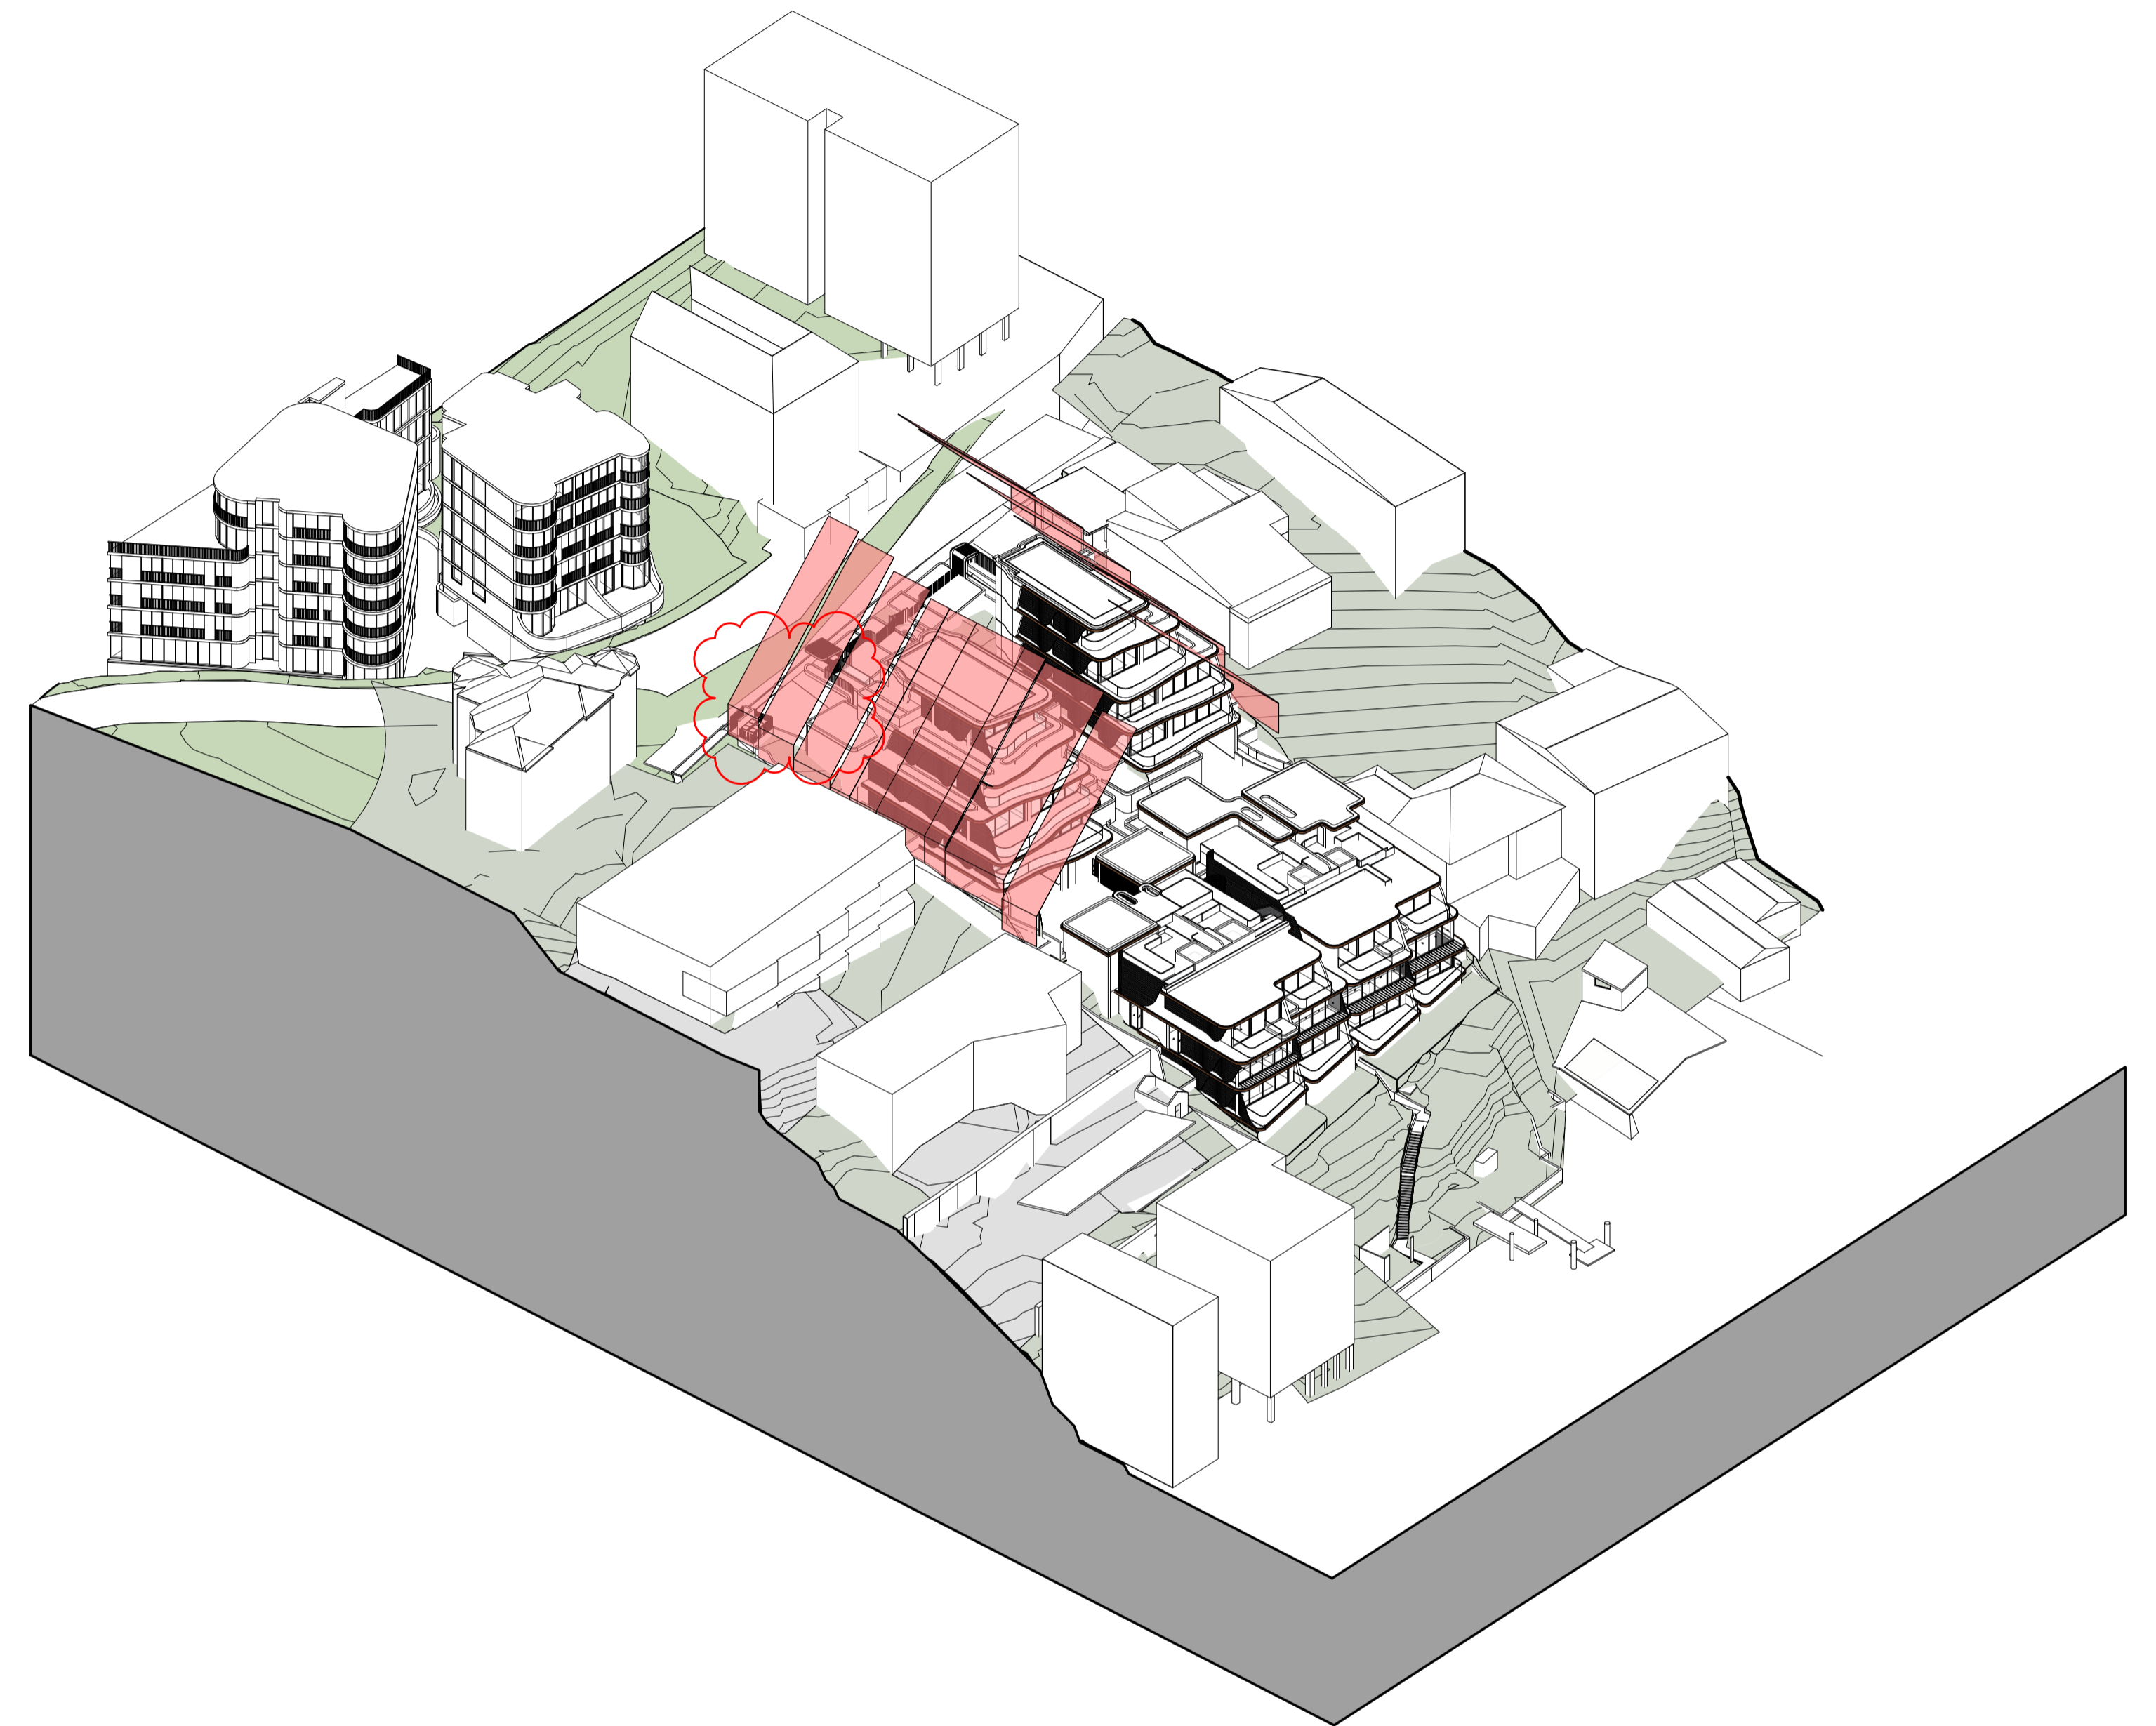

DCP ENVELOPE (VIEW 2)

DIAGRAM LEGEND:

NOTE:
THE DIAGRAMS ABOVE REPRESENT A HEIGHT PLANE TAKEN ALONG THE SIDE BOUNDARIES AT 3.5m ABOVE EXISTING SITE LEVEL AT SIDE BOUNDARIES AND PROJECTED INTERNALLY AT 45 DEGREES FROM VERTICAL. (REFER TO SHEET A620 FOR GROUND LEVEL CALCULATION METHOD).

NO.	REVISION	BY	CHK	DATE	REVISION NOTES:
1	PRE-LODGE			20.01.2022	
2	COORDINATION ISSUE			09.02.2023	
3	AMENDED COORDINATION ISSUE	AL	RPW	19.05.2022	
4	DA ISSUE	RPW	JAC	08.05.2022	
5	COUNCIL RFI COORDINATION ISSUE	AL/CK	RPW	31.07.2023	
6	COUNCIL RFI ISSUE	AL/CK	RPW	15.08.2023	
7	ISSUE FOR DA RESUBMISSION	AL	RPW	02.02.2024	

KEY PLAN

NOTES:
KOICHI TAKADA ARCHITECTS (KTA) RETAIN ALL COMMON LAW AND STATUTORY RIGHTS INCLUDING COPYRIGHT AND INTELLECTUAL PROPERTY RIGHTS TO THIS DOCUMENT.
THIS DOCUMENT MUST NOT BE EDITED, PARTIALLY EXTRACTED, REPRODUCED OR DISTRIBUTED IN ANY MANNER WITHOUT KTA'S EXPRESS WRITTEN CONSENT AND UNDER NO CIRCUMSTANCES SHALL THE TRANSFER OF THIS DOCUMENT BE DEEMED A SALE OR CONSTITUTE A TRANSFER OF ANY LICENCE TO USE THE DOCUMENT.
THE PDF DOCUMENT STAMPED BY KTA AS A 'QA CONTROLLED DOCUMENT' IS THE ONLY OFFICIAL VERSION OF THIS DOCUMENT AND IS STRICTLY SUBJECT TO COPYRIGHT.
THE CONTENT AND ACCURACY OF THE DOCUMENT IS STRICTLY LIMITED TO THAT DEPICTED IN THE QA CONTROLLED PDF.
DO NOT MEASURE FROM THE ELECTRONIC OR HARD COPY VERSIONS OF THIS DOCUMENT.
VERIFY ALL DIMENSIONS ON SITE BEFORE COMMENCING SHOP DRAWINGS, FABRICATION, CONSTRUCTION OR INSTALLATION.

CLIENT:
Kurraba Point Road Pty Ltd
430 TOORAK ROAD, TOORAK 3142

ARCHITECT:
SUITE 41 & 42, LEVEL 4
61 MARLBOROUGH ST
SURRY HILLS, NSW 2010
T 02 9698 8510
ABN 63 131 365 896
NOMINATED ARCHITECT:
KOICHI TAKADA
NSW ARCHITECTS 6901
VIC ARCHITECTS 16179
QLD ARCHITECTS 5590
KOICHI.TAKADA.COM

Koichi Takada Architects

PROJECT:
190 KURRABA RD
190 KURRABA RD, KURRABA POINT NSW 2089

STATUS:
DEVELOPMENT APPLICATION - RFI 01


DWG TITLE:
R4 DCP ENVELOPE (SIDE BOUNDARY)

DWG NO.:
A412


SCALE:

REVISION:
7

DATE:
02.02.2024

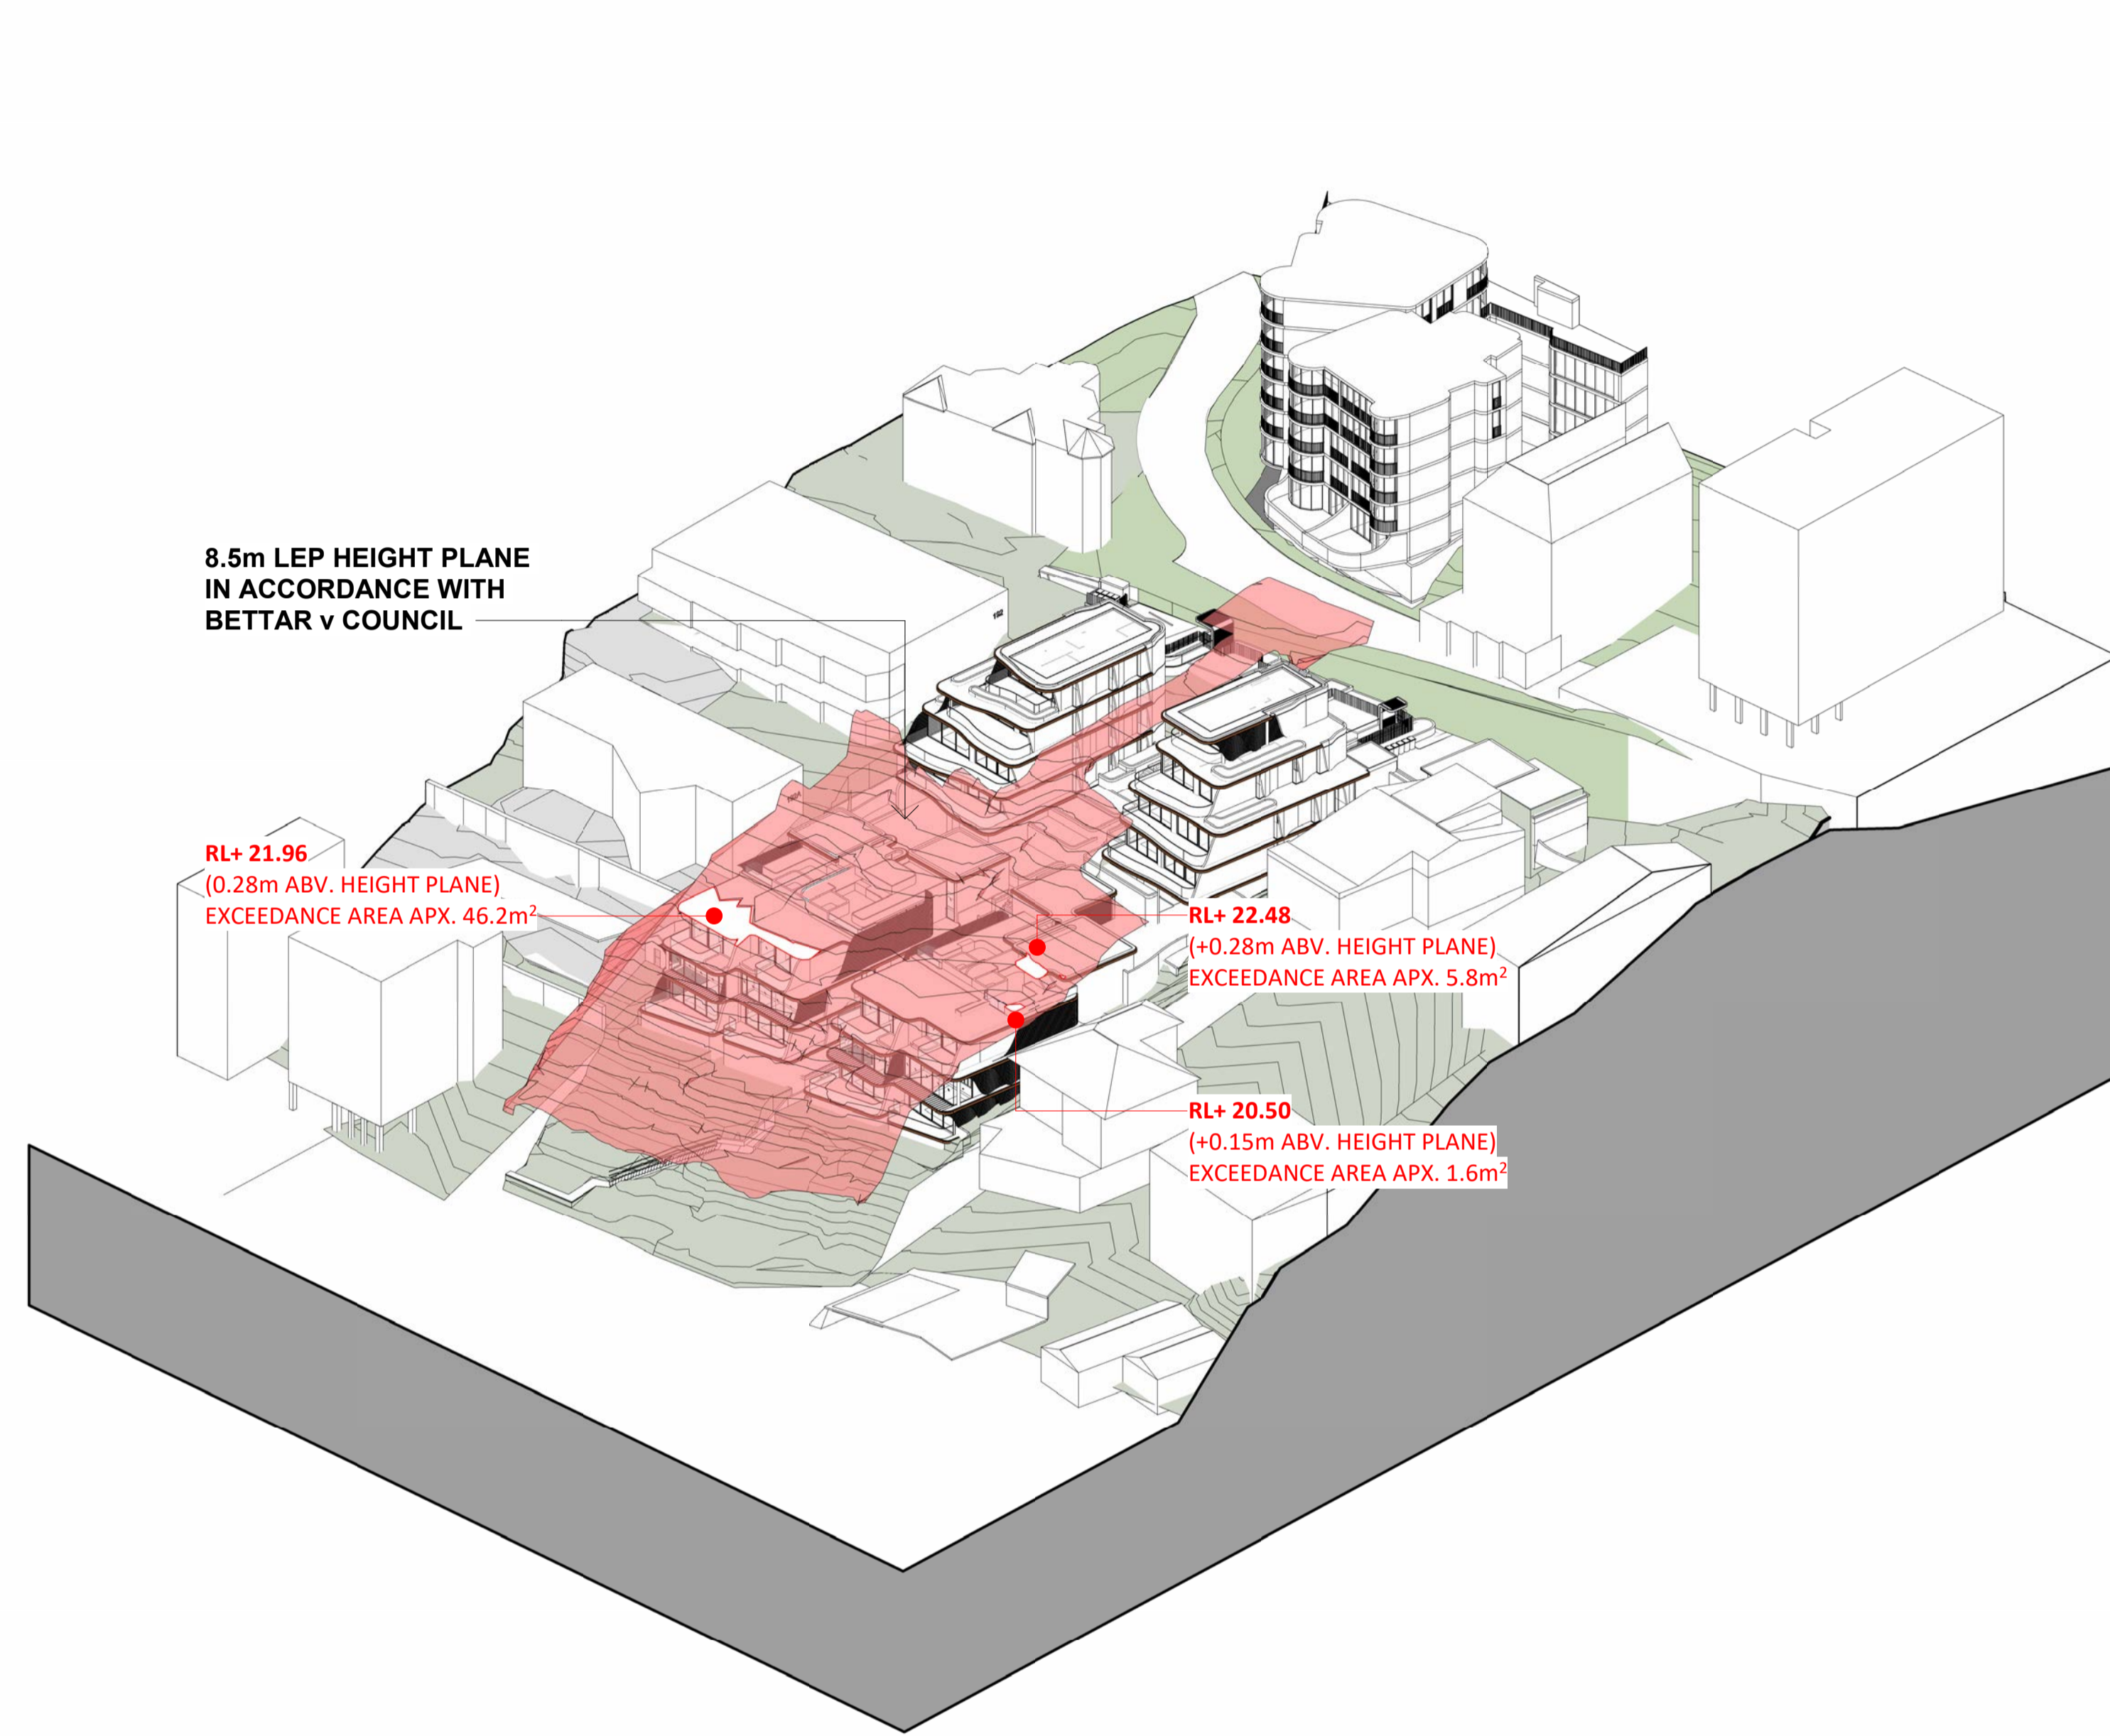

R2 HEIGHT PLANE DIAGRAM - 8.5m ABOVE EXISTING GROUND LEVEL (VIEW 1)

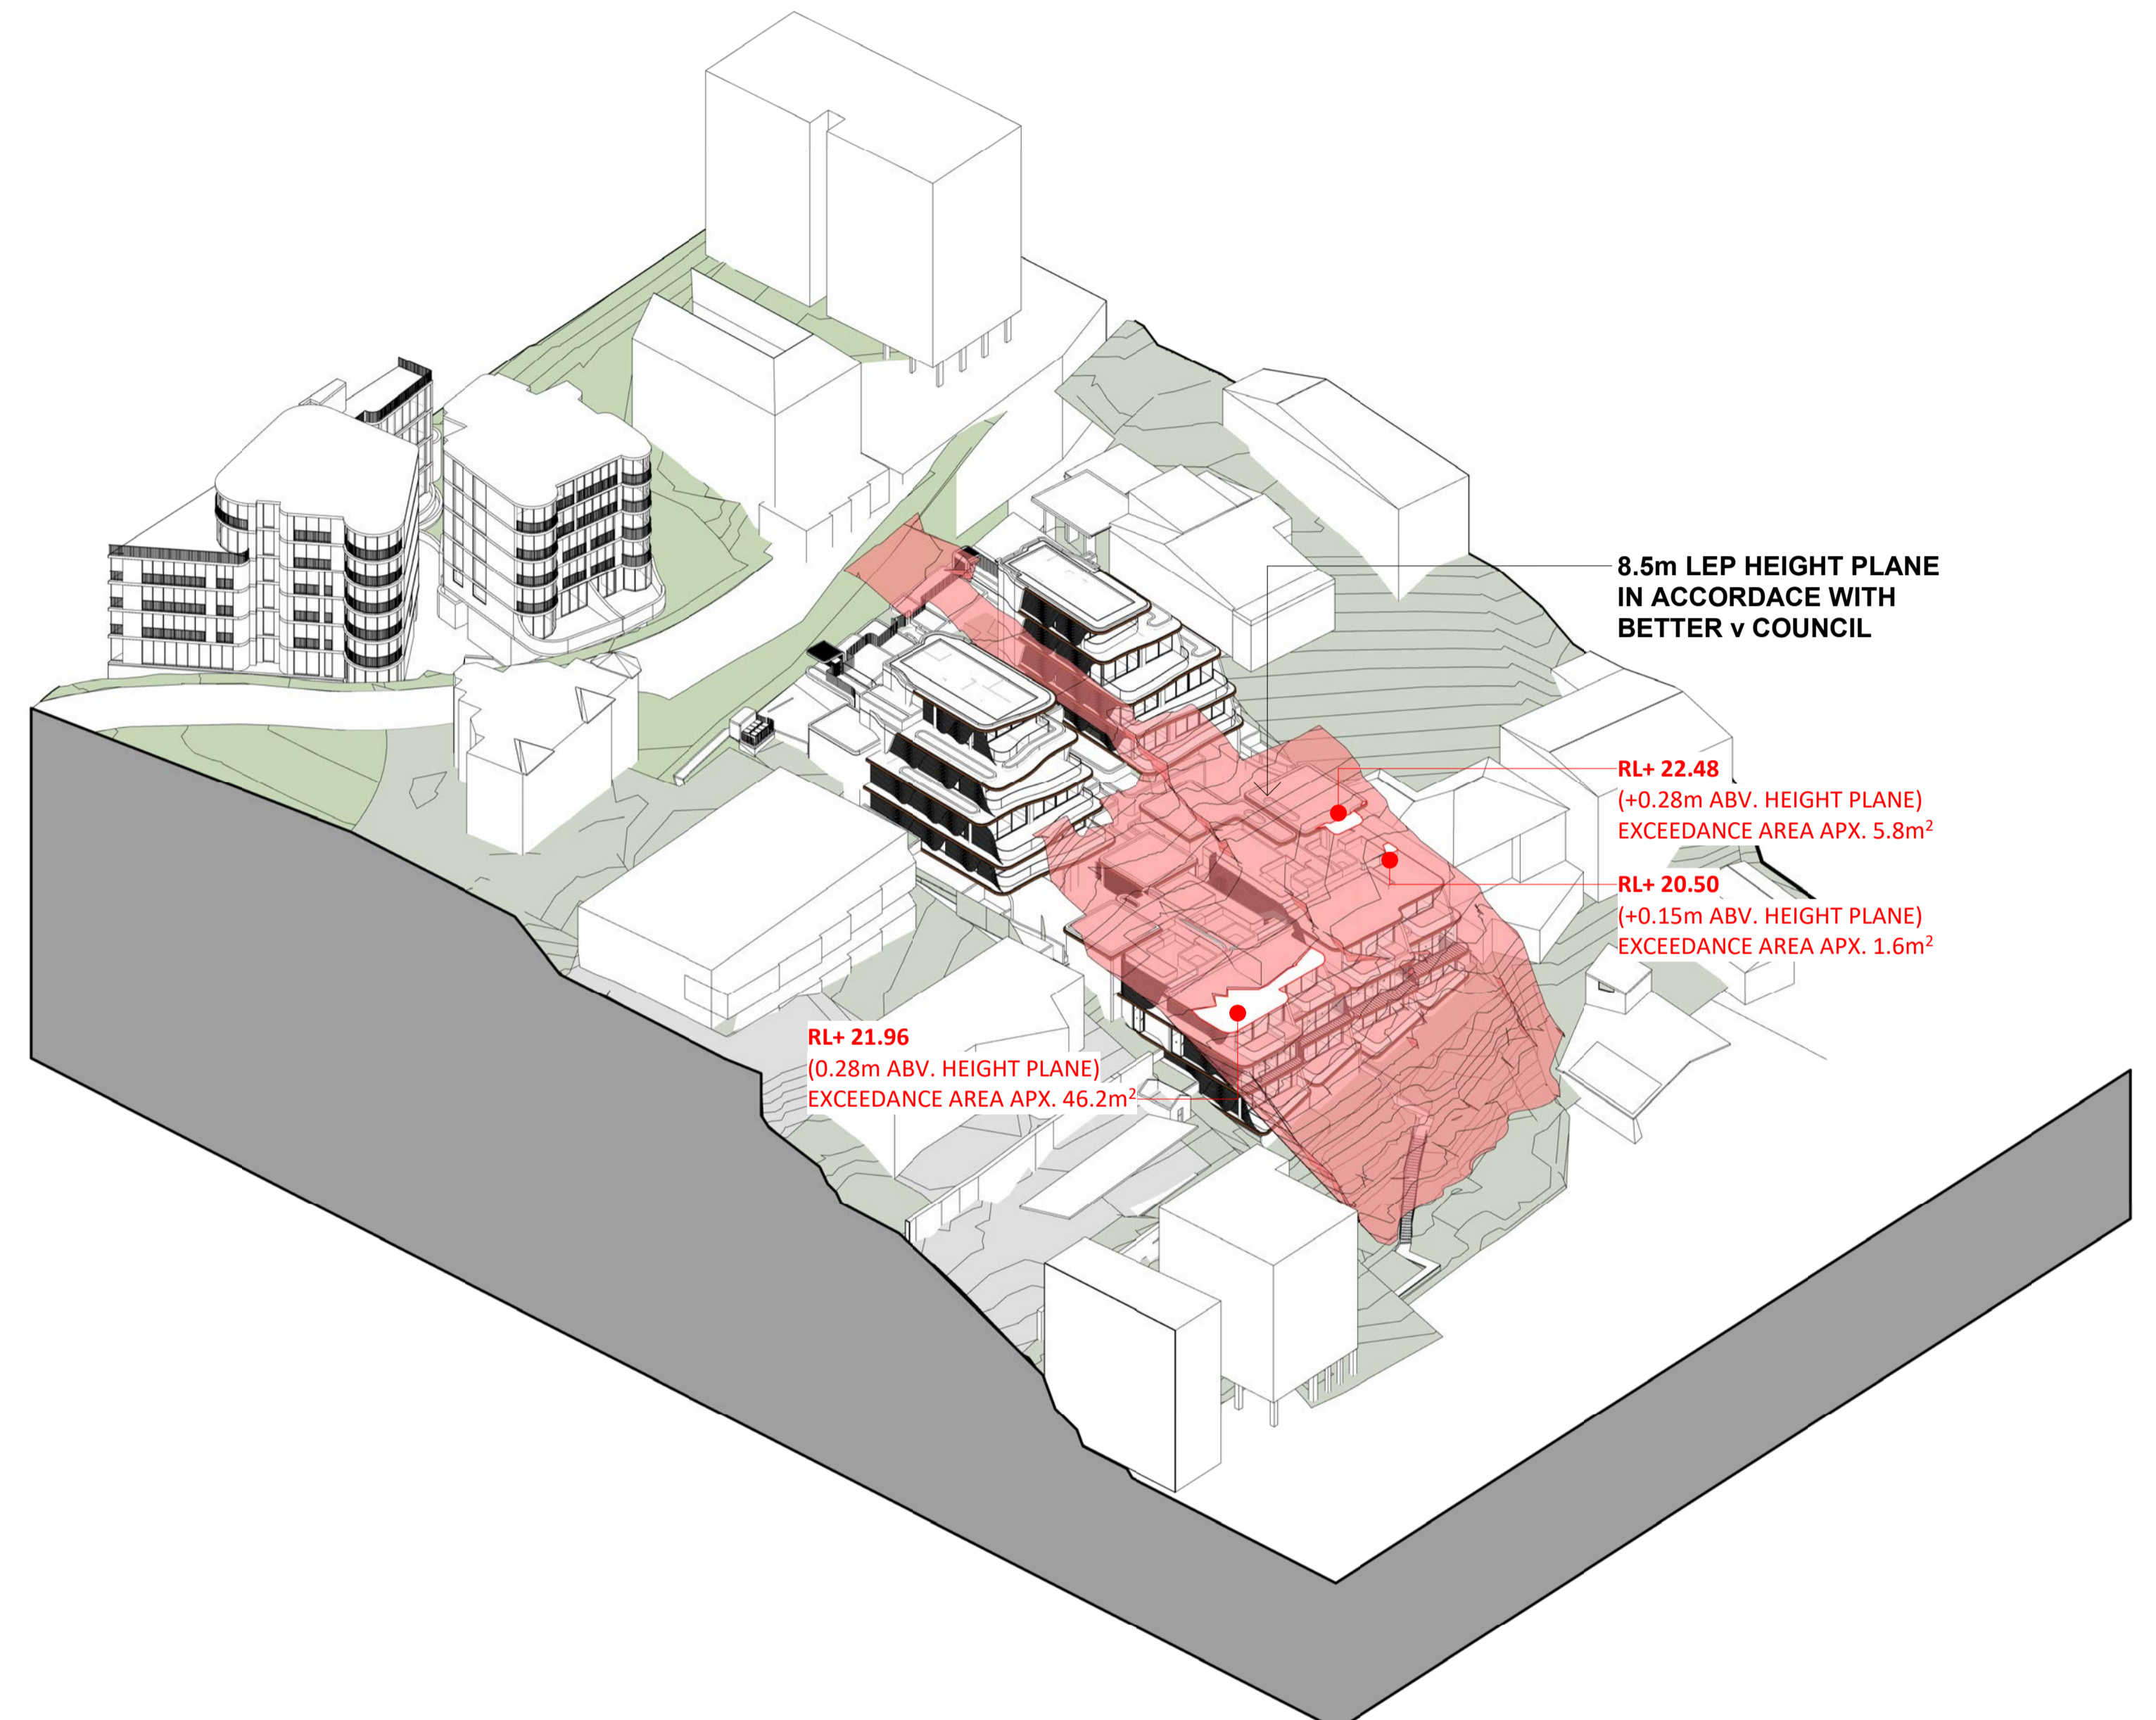

R2 HEIGHT PLANE DIAGRAM - 8.5m ABOVE EXISTING GROUND LEVEL (VIEW 2)

DIAGRAM LEGEND:

NOTE:
THE DIAGRAMS ABOVE REPRESENT A 8.5m HEIGHT PLANE REFLECTING THE R2 ZONE SURVEYED GROUND IN ACCORDANCE WITH BETTAR V COUNCIL.

NO.	REVISION	BY	CHK	DATE	REVISION NOTES:
1	PRE LODGEMENT			20.01.2022	
2	COORDINATION ISSUE			09.02.2023	
3	AMENDED COORDINATION ISSUE	AL	RPW	19.05.2022	
4	DA ISSUE	RPW	AL	08.05.2022	
5	COUNCIL RFI COORDINATION ISSUE	AL/CK	RPW	31.07.2023	
6	COUNCIL RFI ISSUE	AL/CK	RPW	15.08.2023	
7	ISSUE FOR PLANNING REPORT	AL	RPW	31.01.2024	
8	ISSUE FOR DA RESUBMISSION	AL	RPW	02.02.2024	

KEY PLAN

NOTES:
KOICHI TAKADA ARCHITECTS (KTA) RETAIN ALL COMMON LAW AND STATUTORY RIGHTS INCLUDING COPYRIGHT AND INTELLECTUAL PROPERTY RIGHTS TO THIS DOCUMENT. THIS DOCUMENT MUST NOT BE EDITED, PARTIALLY EXTRACTED, REPRODUCED OR DISTRIBUTED IN ANY MANNER WITHOUT KTA'S EXPRESS WRITTEN CONSENT AND UNDER NO CIRCUMSTANCES SHALL THE TRANSFER OF THIS DOCUMENT BE DEEMED A SALE OR CONSTITUTE A TRANSFER OF ANY LICENCE TO USE THE DOCUMENT. THE PDF DOCUMENT STAMPED BY KTA AS A 'QA CONTROLLED DOCUMENT' IS THE ONLY OFFICIAL VERSION OF THIS DOCUMENT AND IS STRICTLY SUBJECT TO COPYRIGHT. THE CONTENT AND ACCURACY OF THE DOCUMENT IS STRICTLY LIMITED TO THAT DEPICTED IN THE QA CONTROLLED PDF. DO NOT MEASURE FROM THE ELECTRONIC OR HARD COPY VERSIONS OF THIS DOCUMENT. VERIFY ALL DIMENSIONS ON SITE BEFORE COMMENCING SHOP DRAWINGS, FABRICATION, CONSTRUCTION OR INSTALLATION.

CLIENT
Kurraba Point Road Pty Ltd 430 TOORAK ROAD, TOORAK 3142

ARCHITECT
SUITE 41 & 42, LEVEL 4 61 MARLBOROUGH ST SURRY HILLS, NSW 2010 T 02 9698 8510 ABN 63 131 365 896 NOMINATED ARCHITECT: KOICHI TAKADA NSW ARCHITECTS 6901 VIC ARCHITECTS 16179 QLD ARCHITECTS 5590 KOICHI TAKADA.COM

Koichi Takada Architects

PROJECT
190 KURRABA RD 190 KURRABA RD, KURRABA POINT NSW 2089

DWG TITLE
HEIGHT PLANE DIAGRAMS (BETTAR) - R2 ZONE

STATUS
DEVELOPMENT APPLICATION - RFI 01

DWG NO.	REVISION
A415	8
SCALE	DATE
	02.02.2024

THIS DOCUMENT IS NOT SUITABLE OR APPROVED FOR CONSTRUCTION AT ANY TIME UNLESS KTA HAVE NOTATED THE STATUS TITLE AS FOR CONSTRUCTION WITHOUT THE PRESENCE OF 'WIP', 'DRAFT' OR ANY OTHER FORM OF QUALIFICATION ON THE DOCUMENT.